 
SEE 4-H
#22025-D
3524.02
Pt. -039
Pt. 5.51 A.
EXCEPTION
OR 230/125
REDUCED
813.23
Pt. -047
~~Pt. 103.84 A.~~
PT. 98.33 A
ACREAGE BREAKDOWN
111.23 - ORIG. AC
- 7.39 - EXCEPTION (STATE)
103.84 Ac
- 5.51 - EXCEPTION OR 230/125
98.33 A.
AC. CORR. PER DEED
101
598.98
60.10
344.39
-012
.46 A.
-013
.60 A.
-014
.53 A.
-015
.47 A.
-016
-034
2.67 A.
RD
RIDGE
DETROIT RD.
254
NORTH
P.O.B.
388.44
-056
0.38 A.
705.47
-053
0.46 A.
-054
0.46 A.
-055
0.46 A.
-03
0.43 A.
APPROVED
LORAIN CO.
MAP DEPT.
DATE 1-03-97
PAGE 4-00-027F
BY R. BELL
VOID AFTER # 22025-D
22025-D