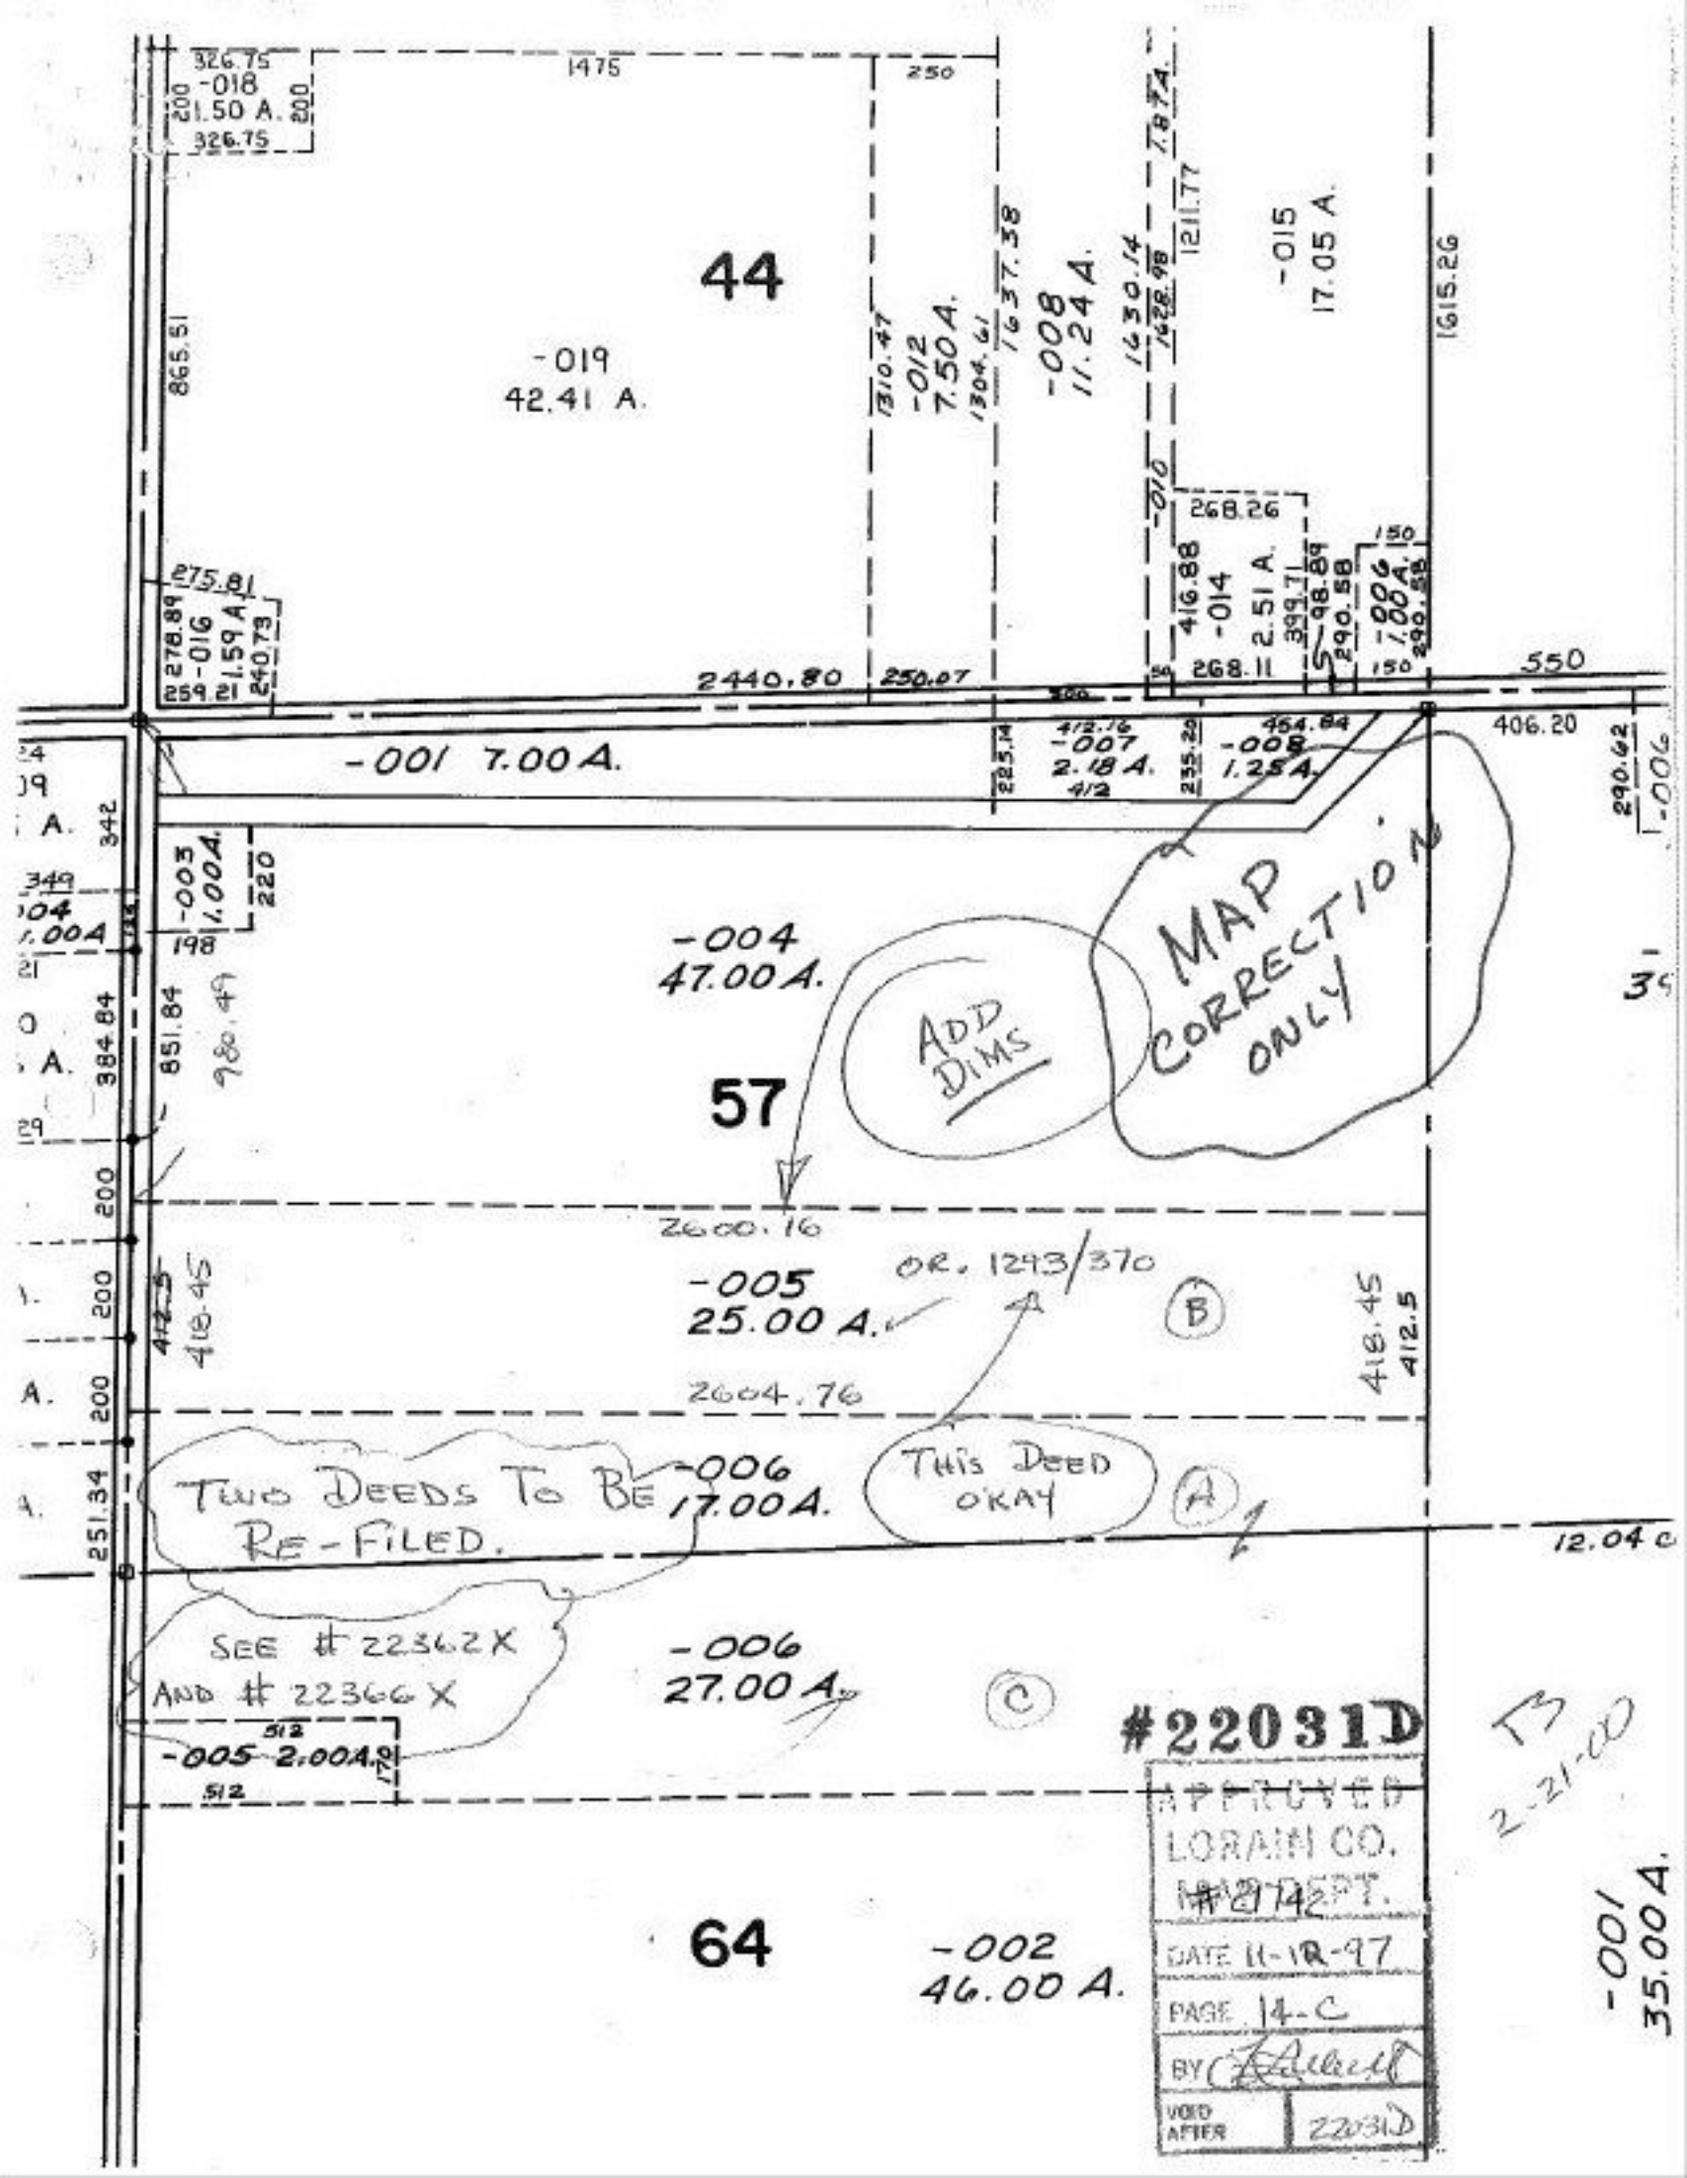
326.75
-018
21.50 A.
326.75
1475
250
44
-019
42.41 A.
865.51
1310.47
-012
7.50 A.
1304.61
1637.38
-008
11.24 A.
1630.14
1628.98
1211.77
-015
17.05 A.
1615.26
-010
268.26
416.88
-014
2.51 A.
399.71
98.89
290.58
-006
1.00 A.
290.58
150
275.81
278.89
-016
21.59 A.
259.21
240.73
2440.80
250.07
550
406.20
-001 7.00 A.
228.14
412.16
-007
2.18 A.
412
235.20
454.84
-008
1.25 A.
290.62
-006
342
-003
1.00 A.
220
198
-004
47.00 A.
ADD DIMS
MAP CORRECTION ONLY
57
851.84
980.49
384.84
2600.16
-005
25.00 A.
OR. 1243/370
B
418.45
412.5
2604.76
200
251.34
TWO DEEDS TO BE RE-FILED.
-006
17.00 A.
THIS DEED OKAY
A
12.04 c
SEE #22362X
AND #22366X
-006
27.00 A.
C
512
-005 2.00 A.
170
512
#22031D
APPROVED
LORAIN CO.
MAP DEPT.
#2174
DATE 11-12-97
PAGE 14-C
BY
VOID AFTER
22031D
2-21-00
64
-002
46.00 A.
-001
35.00 A.