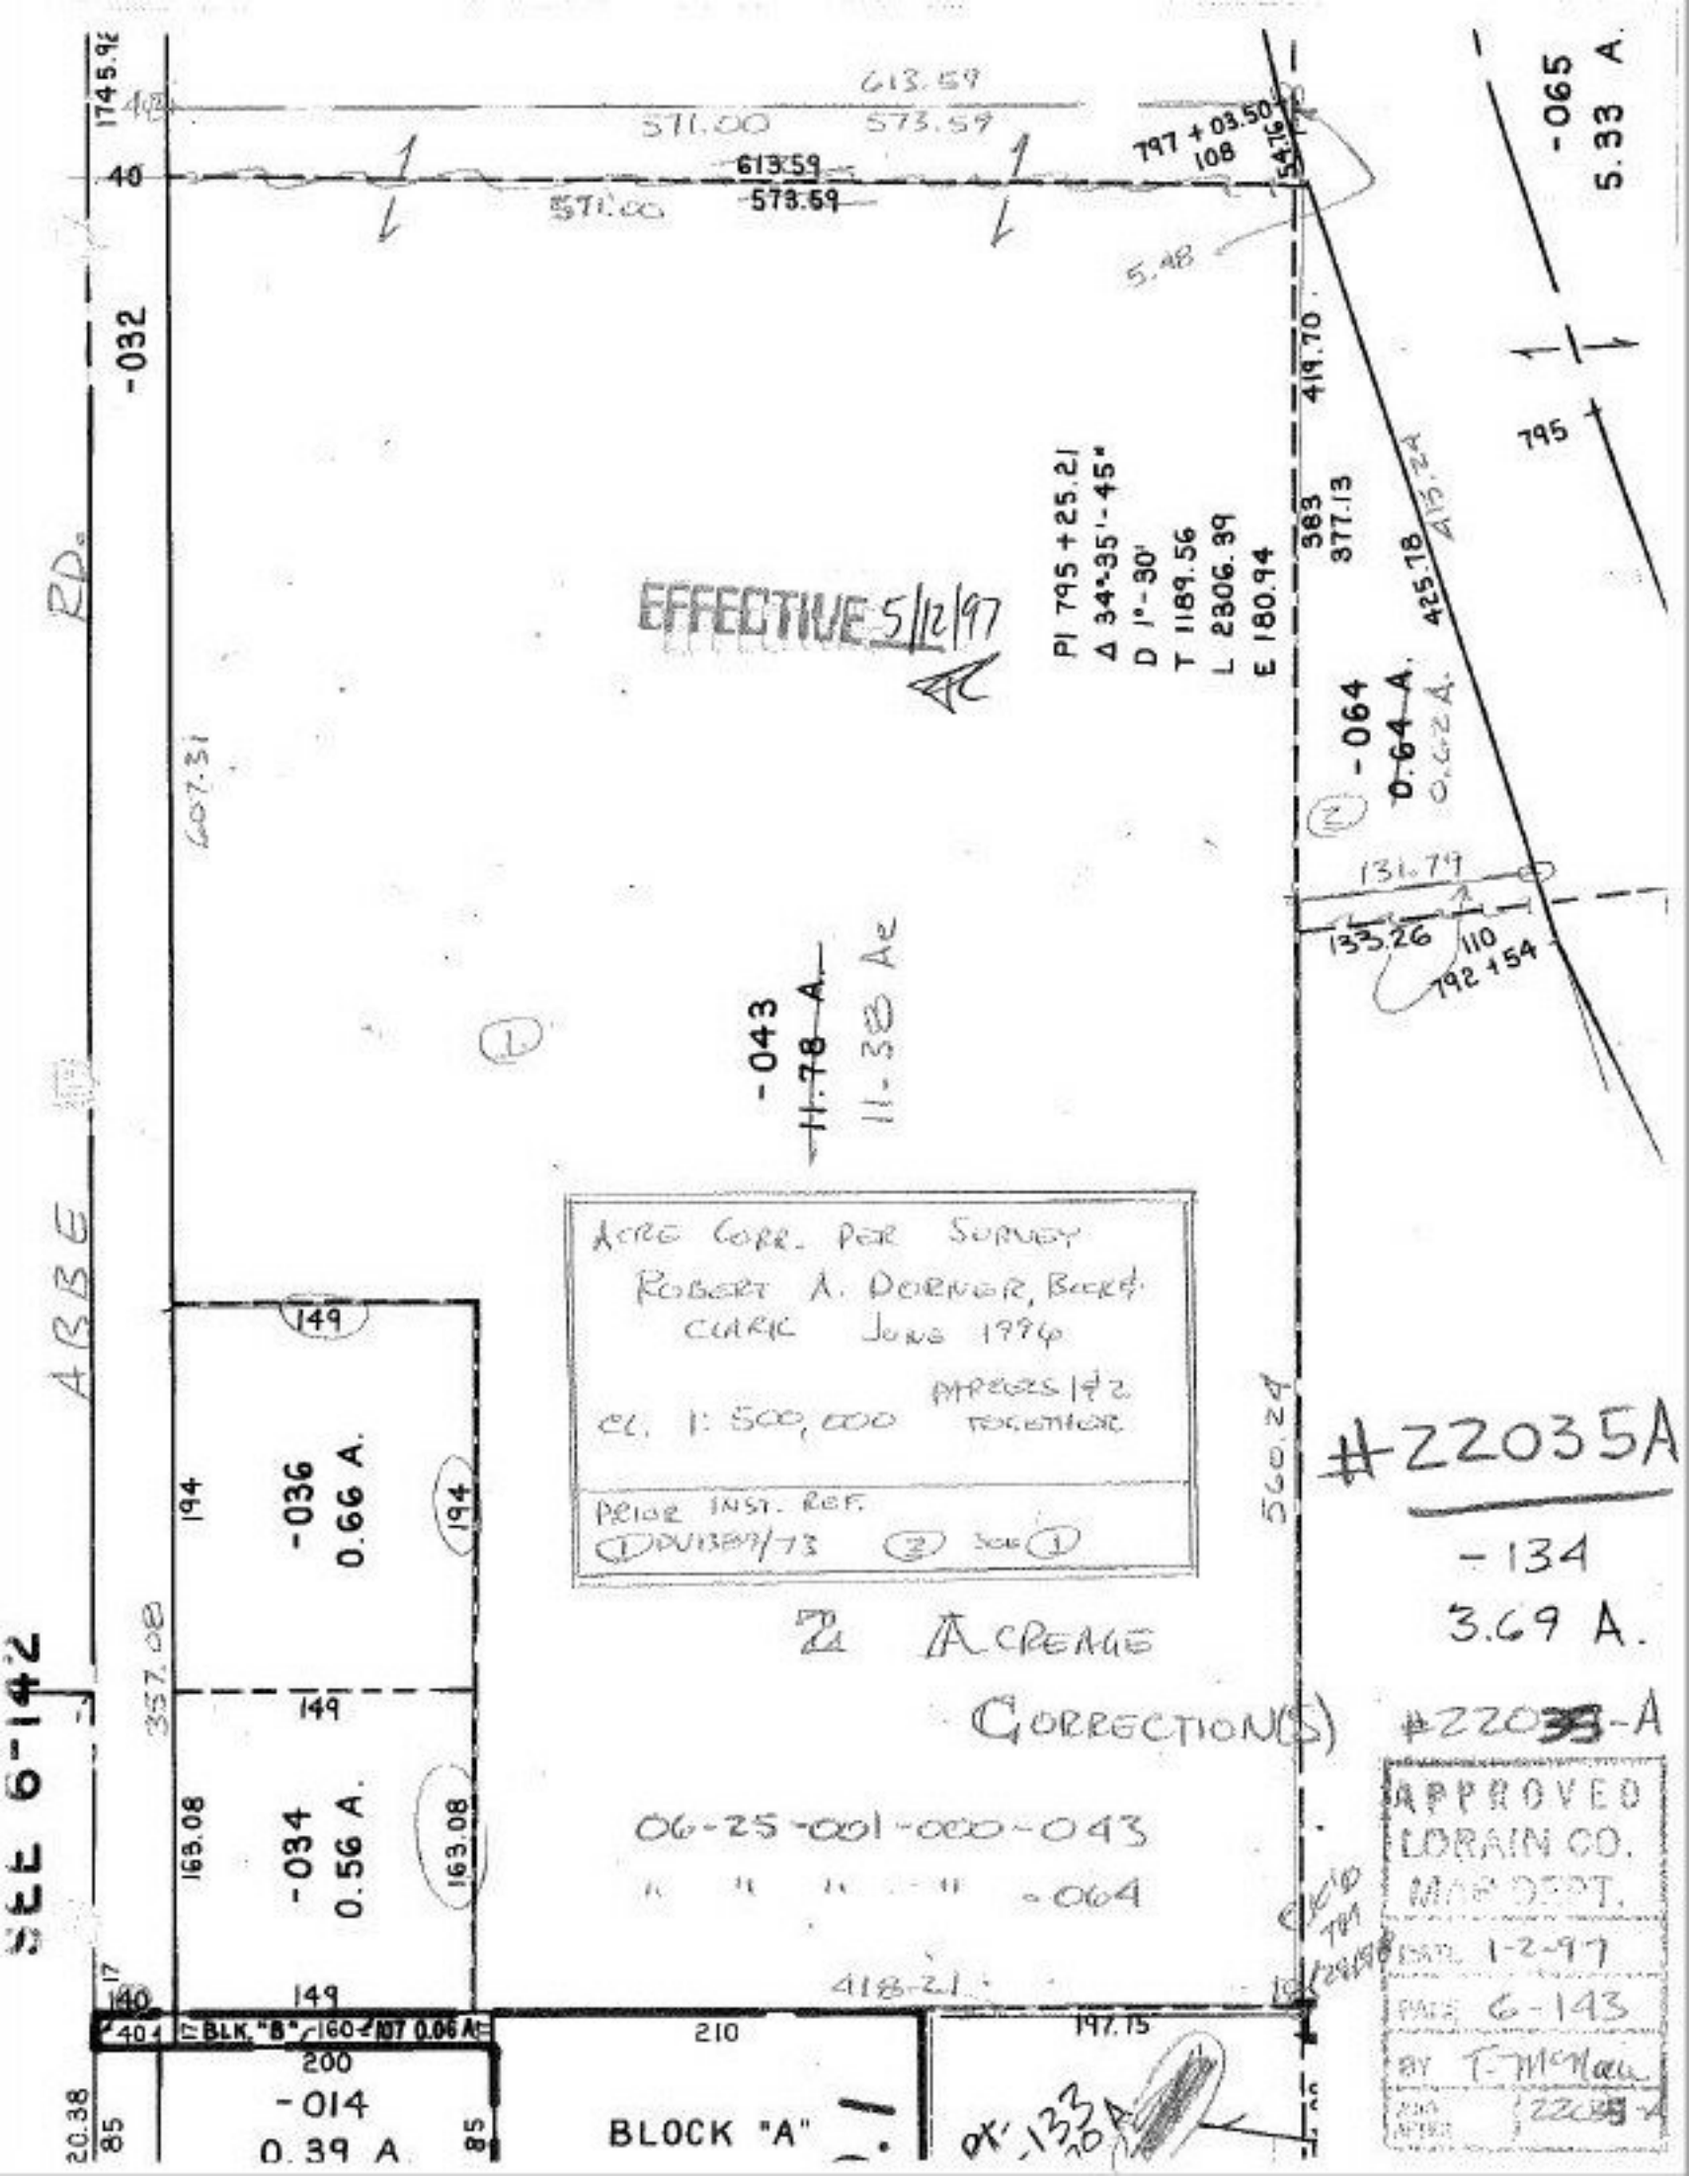

613.59
571.00
573.59
797 + 03.50
108
54.76
-065
5.33 A.
-032
5.48
419.70
795
PI 795 + 25.21
Δ 34°-35'-45"
D 1°-30'
T 1189.56
L 2306.39
E 180.94
383
377.13
415.24
425.78
EFFECTIVE 5/12/97
-064
0.64 A.
0.62 A.
607.31
131.79
133.26
110
792 + 54
-043
11.78 A.
11.38 Ac
ACRE CORR. PER SURVEY
ROBERT A. DORNER, BOOK & CLARK JUNE 1996
CL. 1: 500,000
PARCELS 1 & 2 TOGETHER
PRIOR INST. REF.
1 DV1389/73
2 SEE 1
149
194
-036
0.66 A.
194
560.24
#22035A
-134
3.69 A.
2 ACREAGE
CORRECTION(S)
#22035-A
357.08
149
163.08
-034
0.56 A.
163.08
06-25-001-000-043
" " " " -064
APPROVED
LORAIN CO.
MAP DEPT.
DATE 1-2-97
PAGE 6-143
BY T. McNaw
ZONE
APPROVED
22035-A
SEE 6-142
140
149
418.21
BLK. "B" 160-107 0.06 A.
210
197.15
200
-014
0.39 A.
85
85
BLOCK "A"
20.38