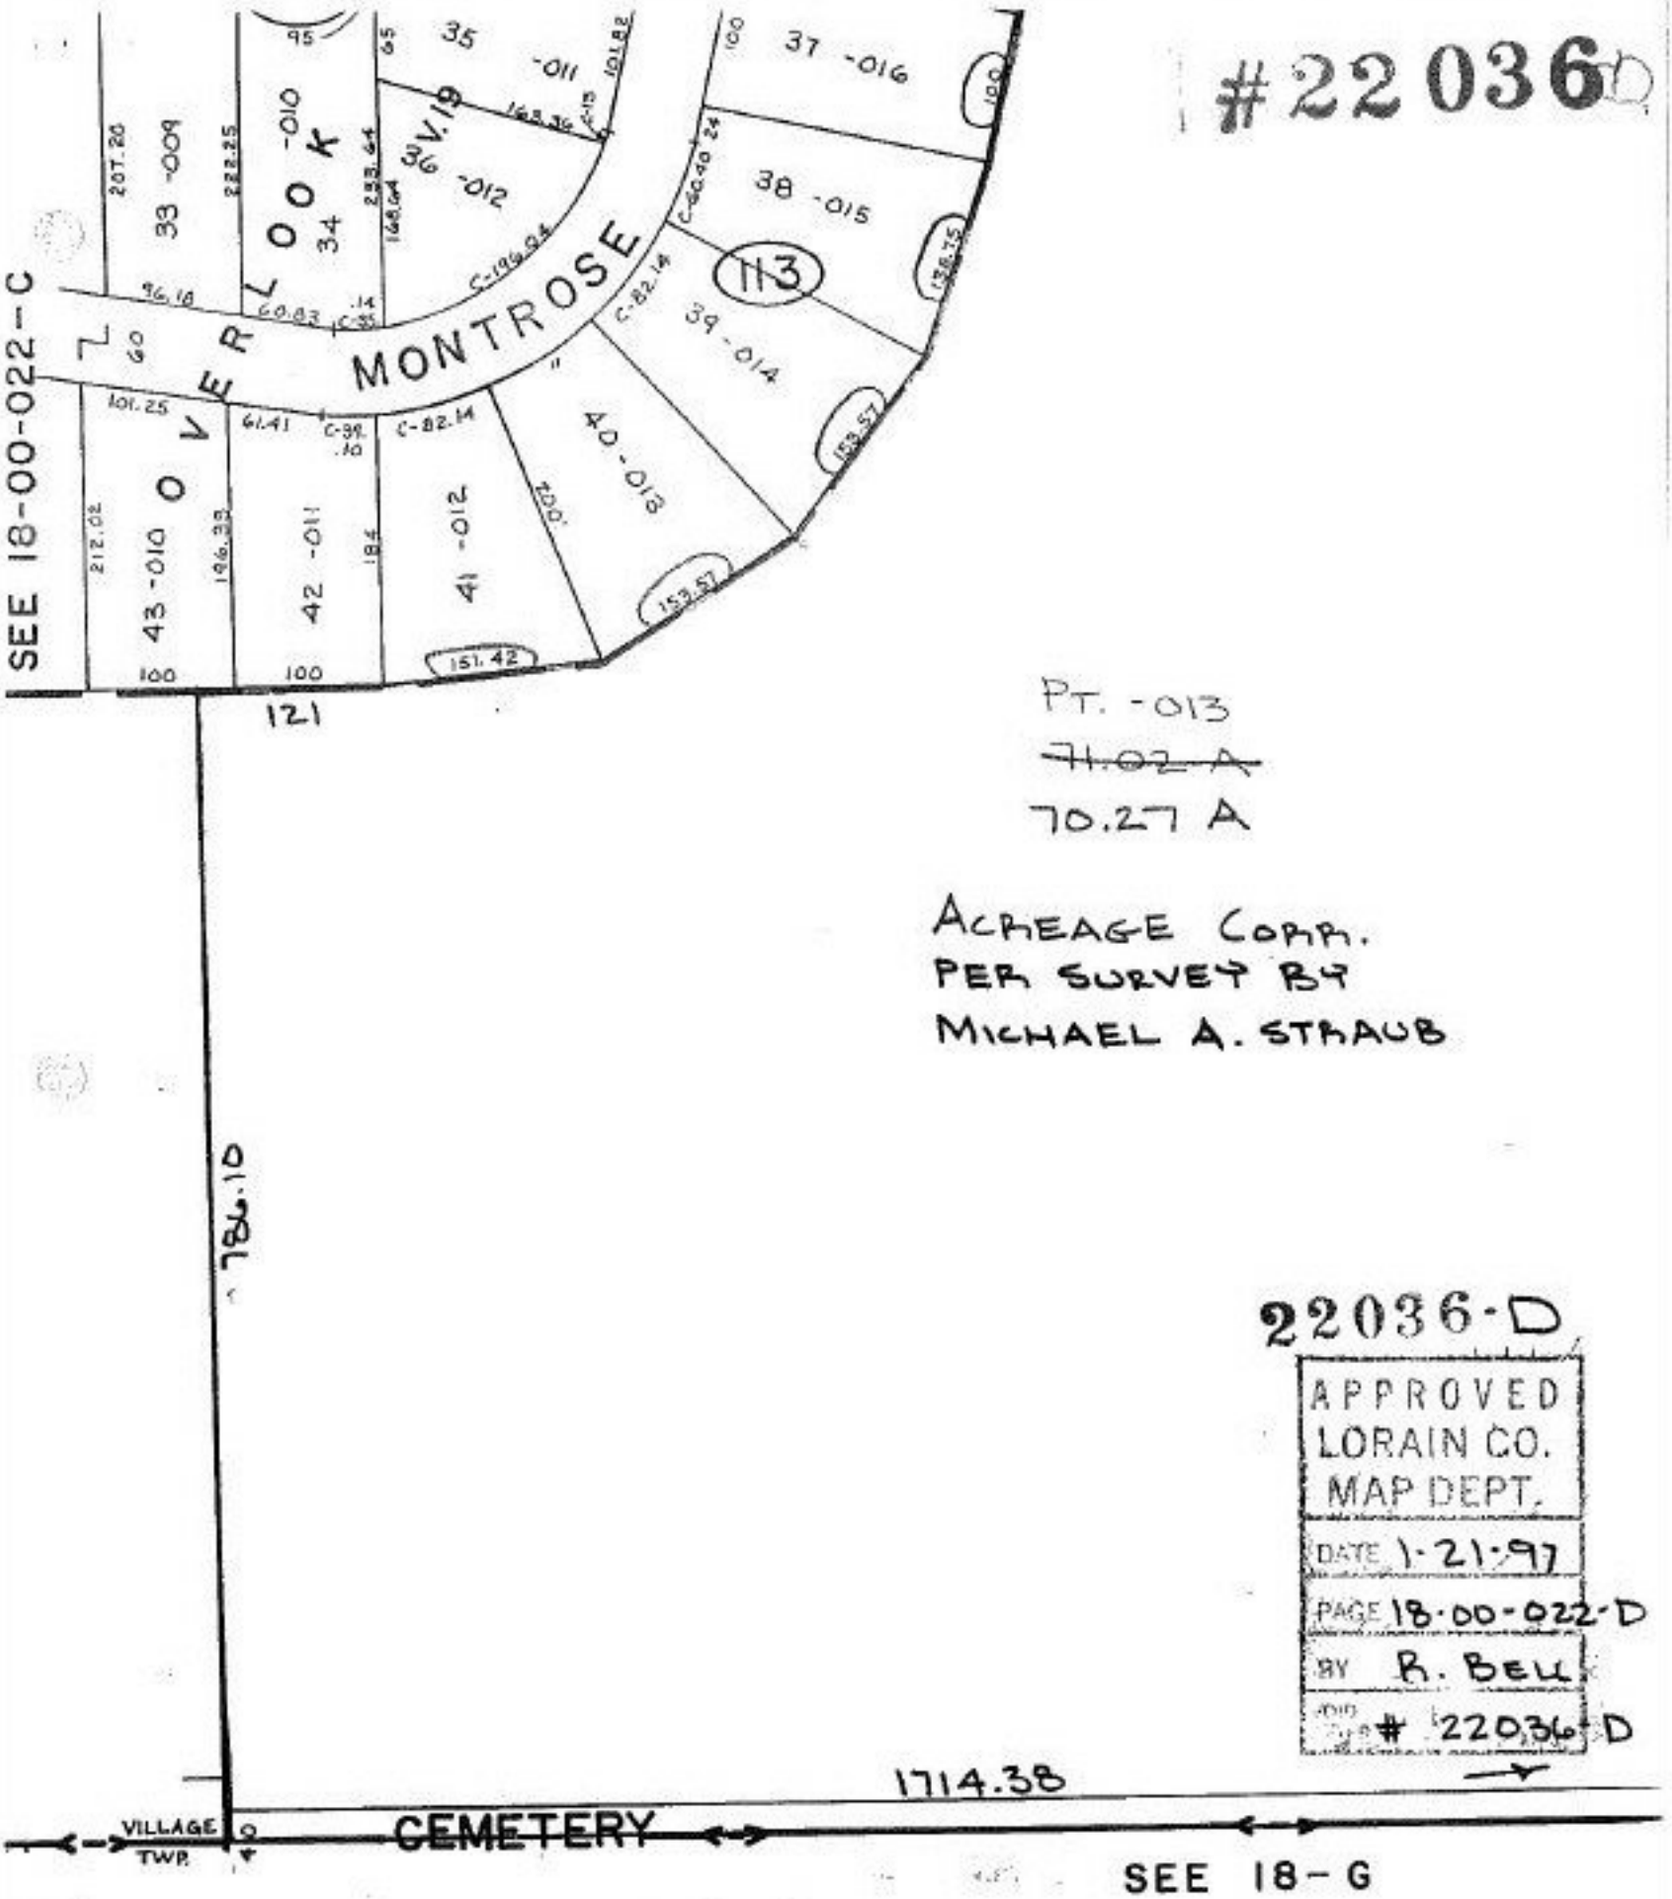

#22036D
SEE 18-00-022-C
OVERLOOK
MONTROSE
V.19
33 -009
34 -010
35 -011
36 -012
37 -016
38 -015
39 -014
40 -013
41 -012
42 -011
43 -010
113
121
786.10
1714.38
VILLAGE TWP.
CEMETERY
SEE 18-G
PT. -013
~~71.02 A~~
70.27 A
ACREAGE CORR.
PER SURVEY BY
MICHAEL A. STRAUB
22036-D
APPROVED
LORAIN CO.
MAP DEPT.
DATE 1-21-97
PAGE 18-00-022-D
BY R. BELL
22036-D

REDUCED

3/6