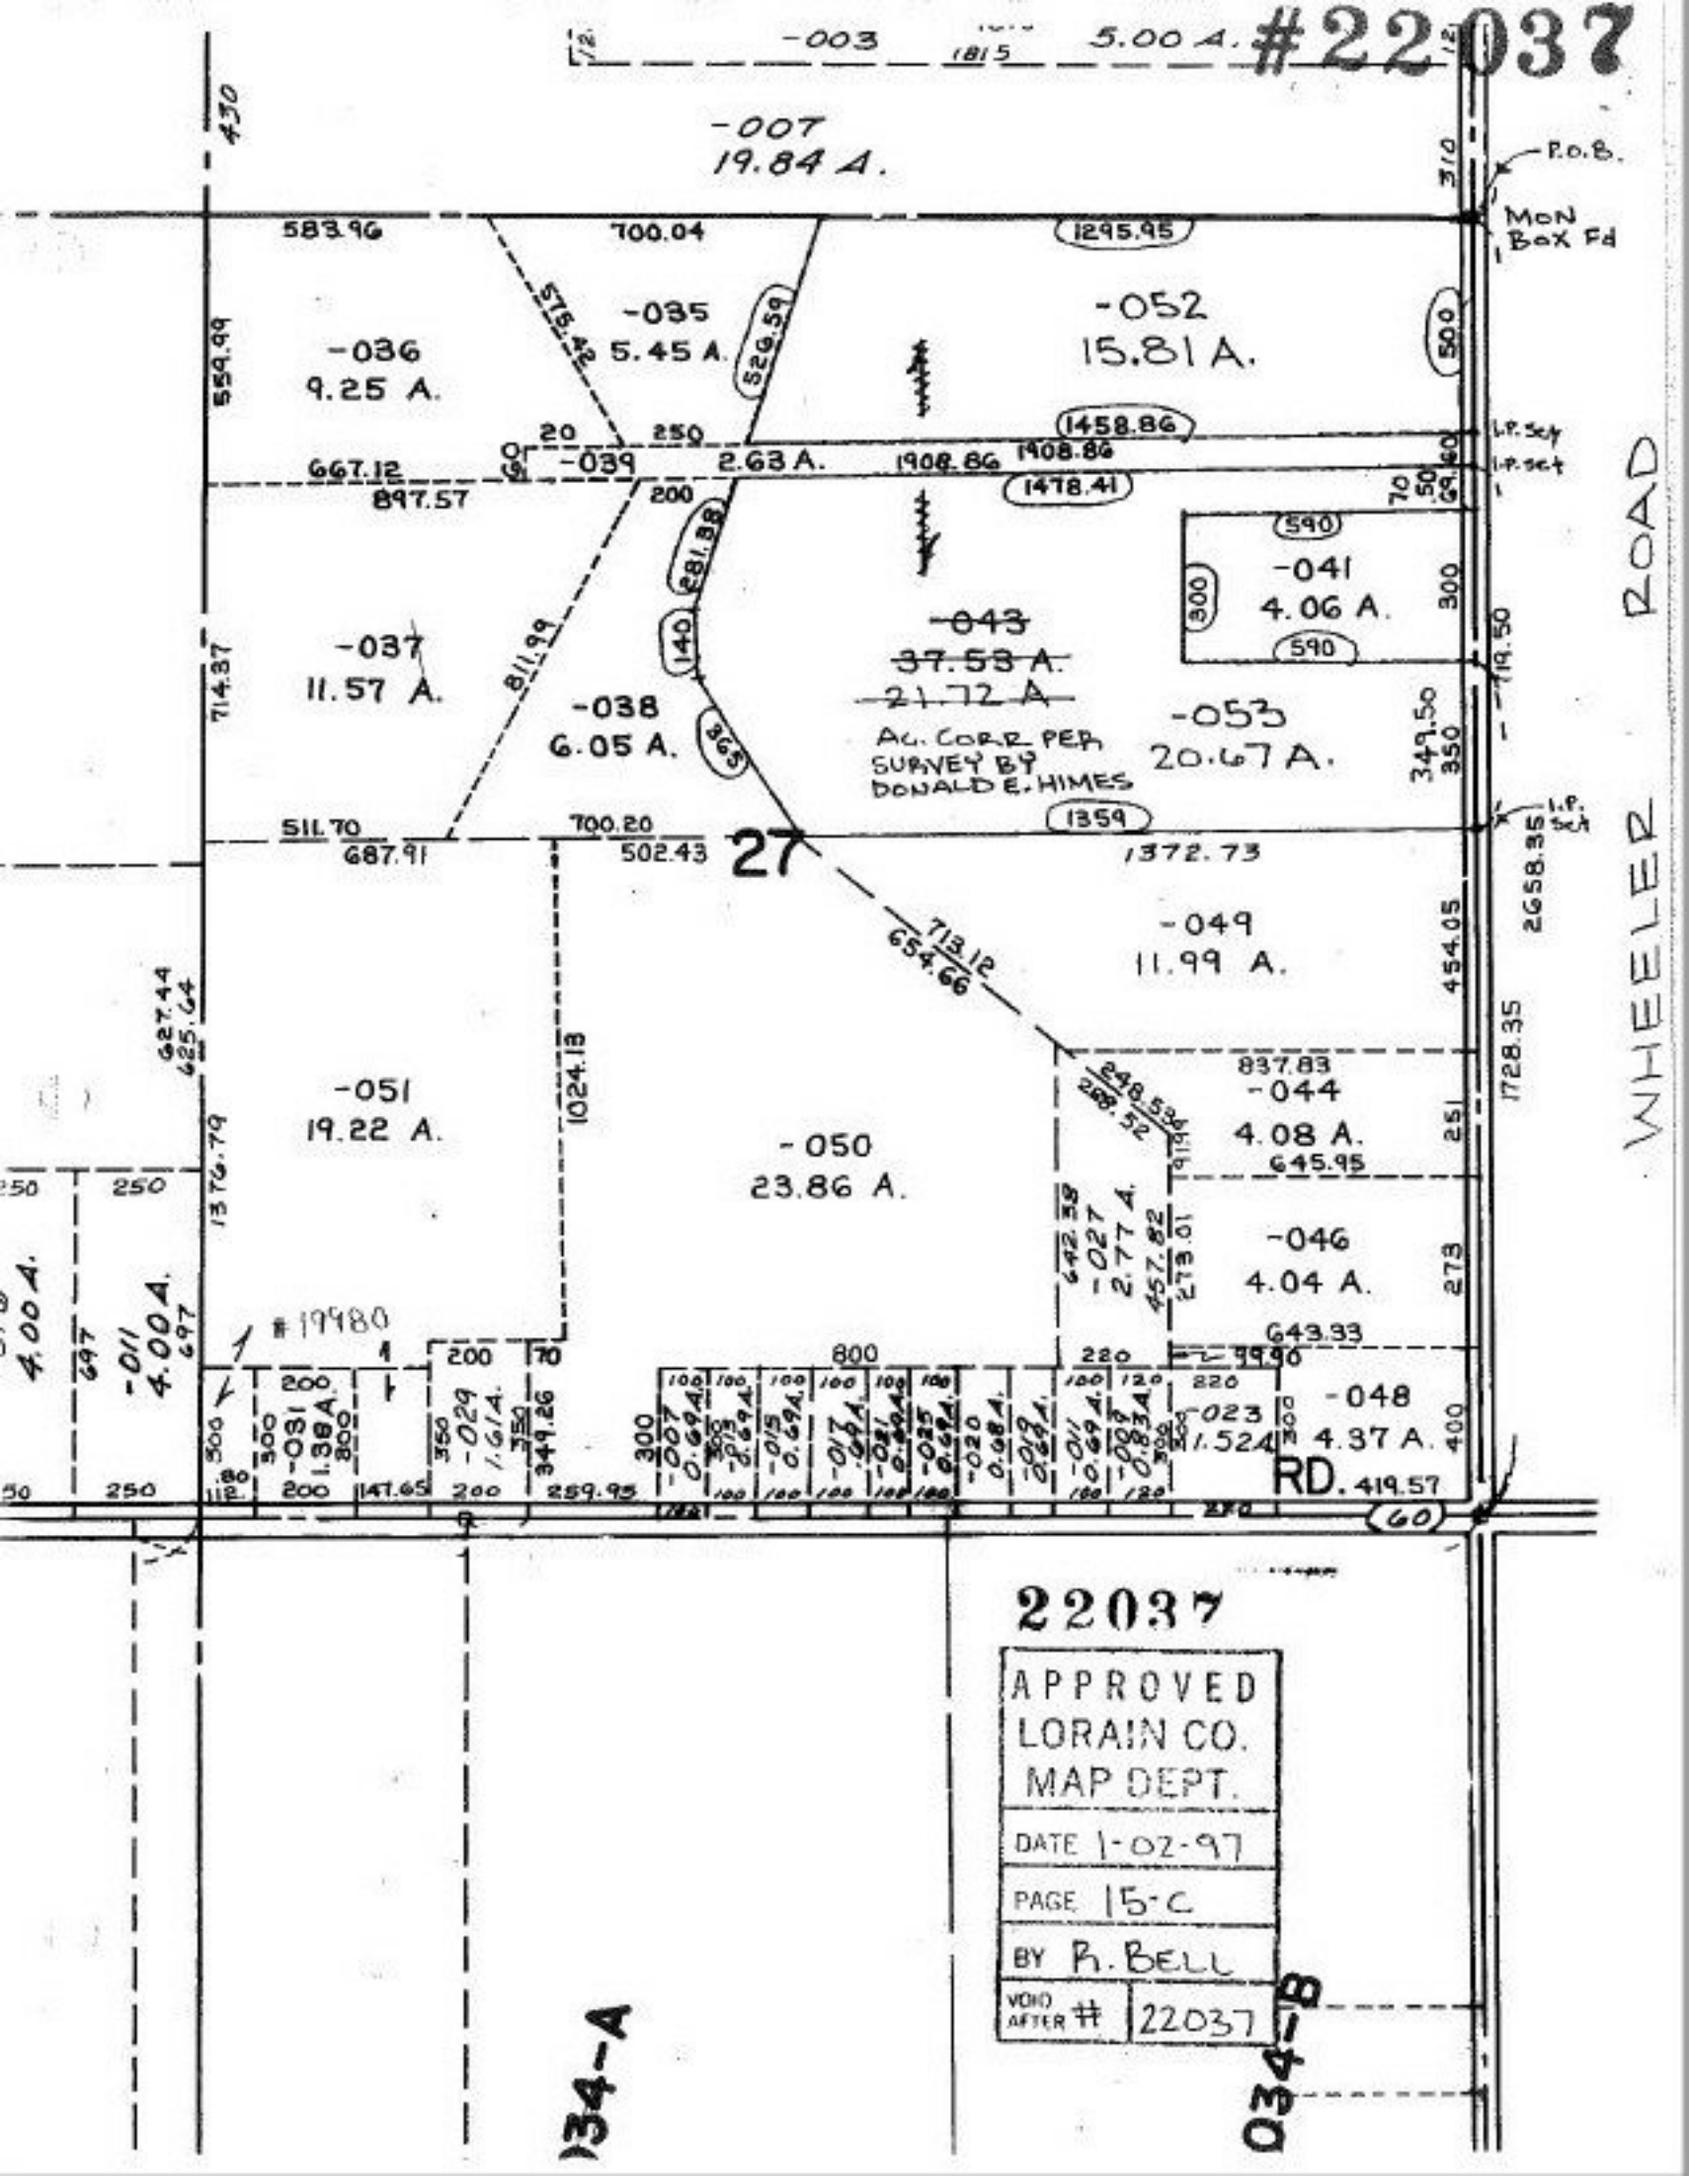
#22037
-003
5.00 A.
-007
19.84 A.
P.O.B.
Mon Box Fd
-036
9.25 A.
-035
5.45 A.
-052
15.81 A.
-039
2.63 A.
-041
4.06 A.
-037
11.57 A.
-038
6.05 A.
-043
37.53 A.
21.72 A.
AC. CORR. PER SURVEY BY DONALD E. HIMES
-053
20.67 A.
27
-049
11.99 A.
-051
19.22 A.
-050
23.86 A.
-044
4.08 A.
-027
2.77 A.
-046
4.04 A.
-011
4.004 A.
#19980
-031
1.38 A.
-029
1.614 A.
-023
1.524
-048
4.37 A.
RD. 419.57
WHEELER ROAD
22037
APPROVED
LORAIN CO.
MAP DEPT.
DATE 1-02-97
PAGE 15-C
BY R. BELL
VOID AFTER # 22037
034-A
034-B