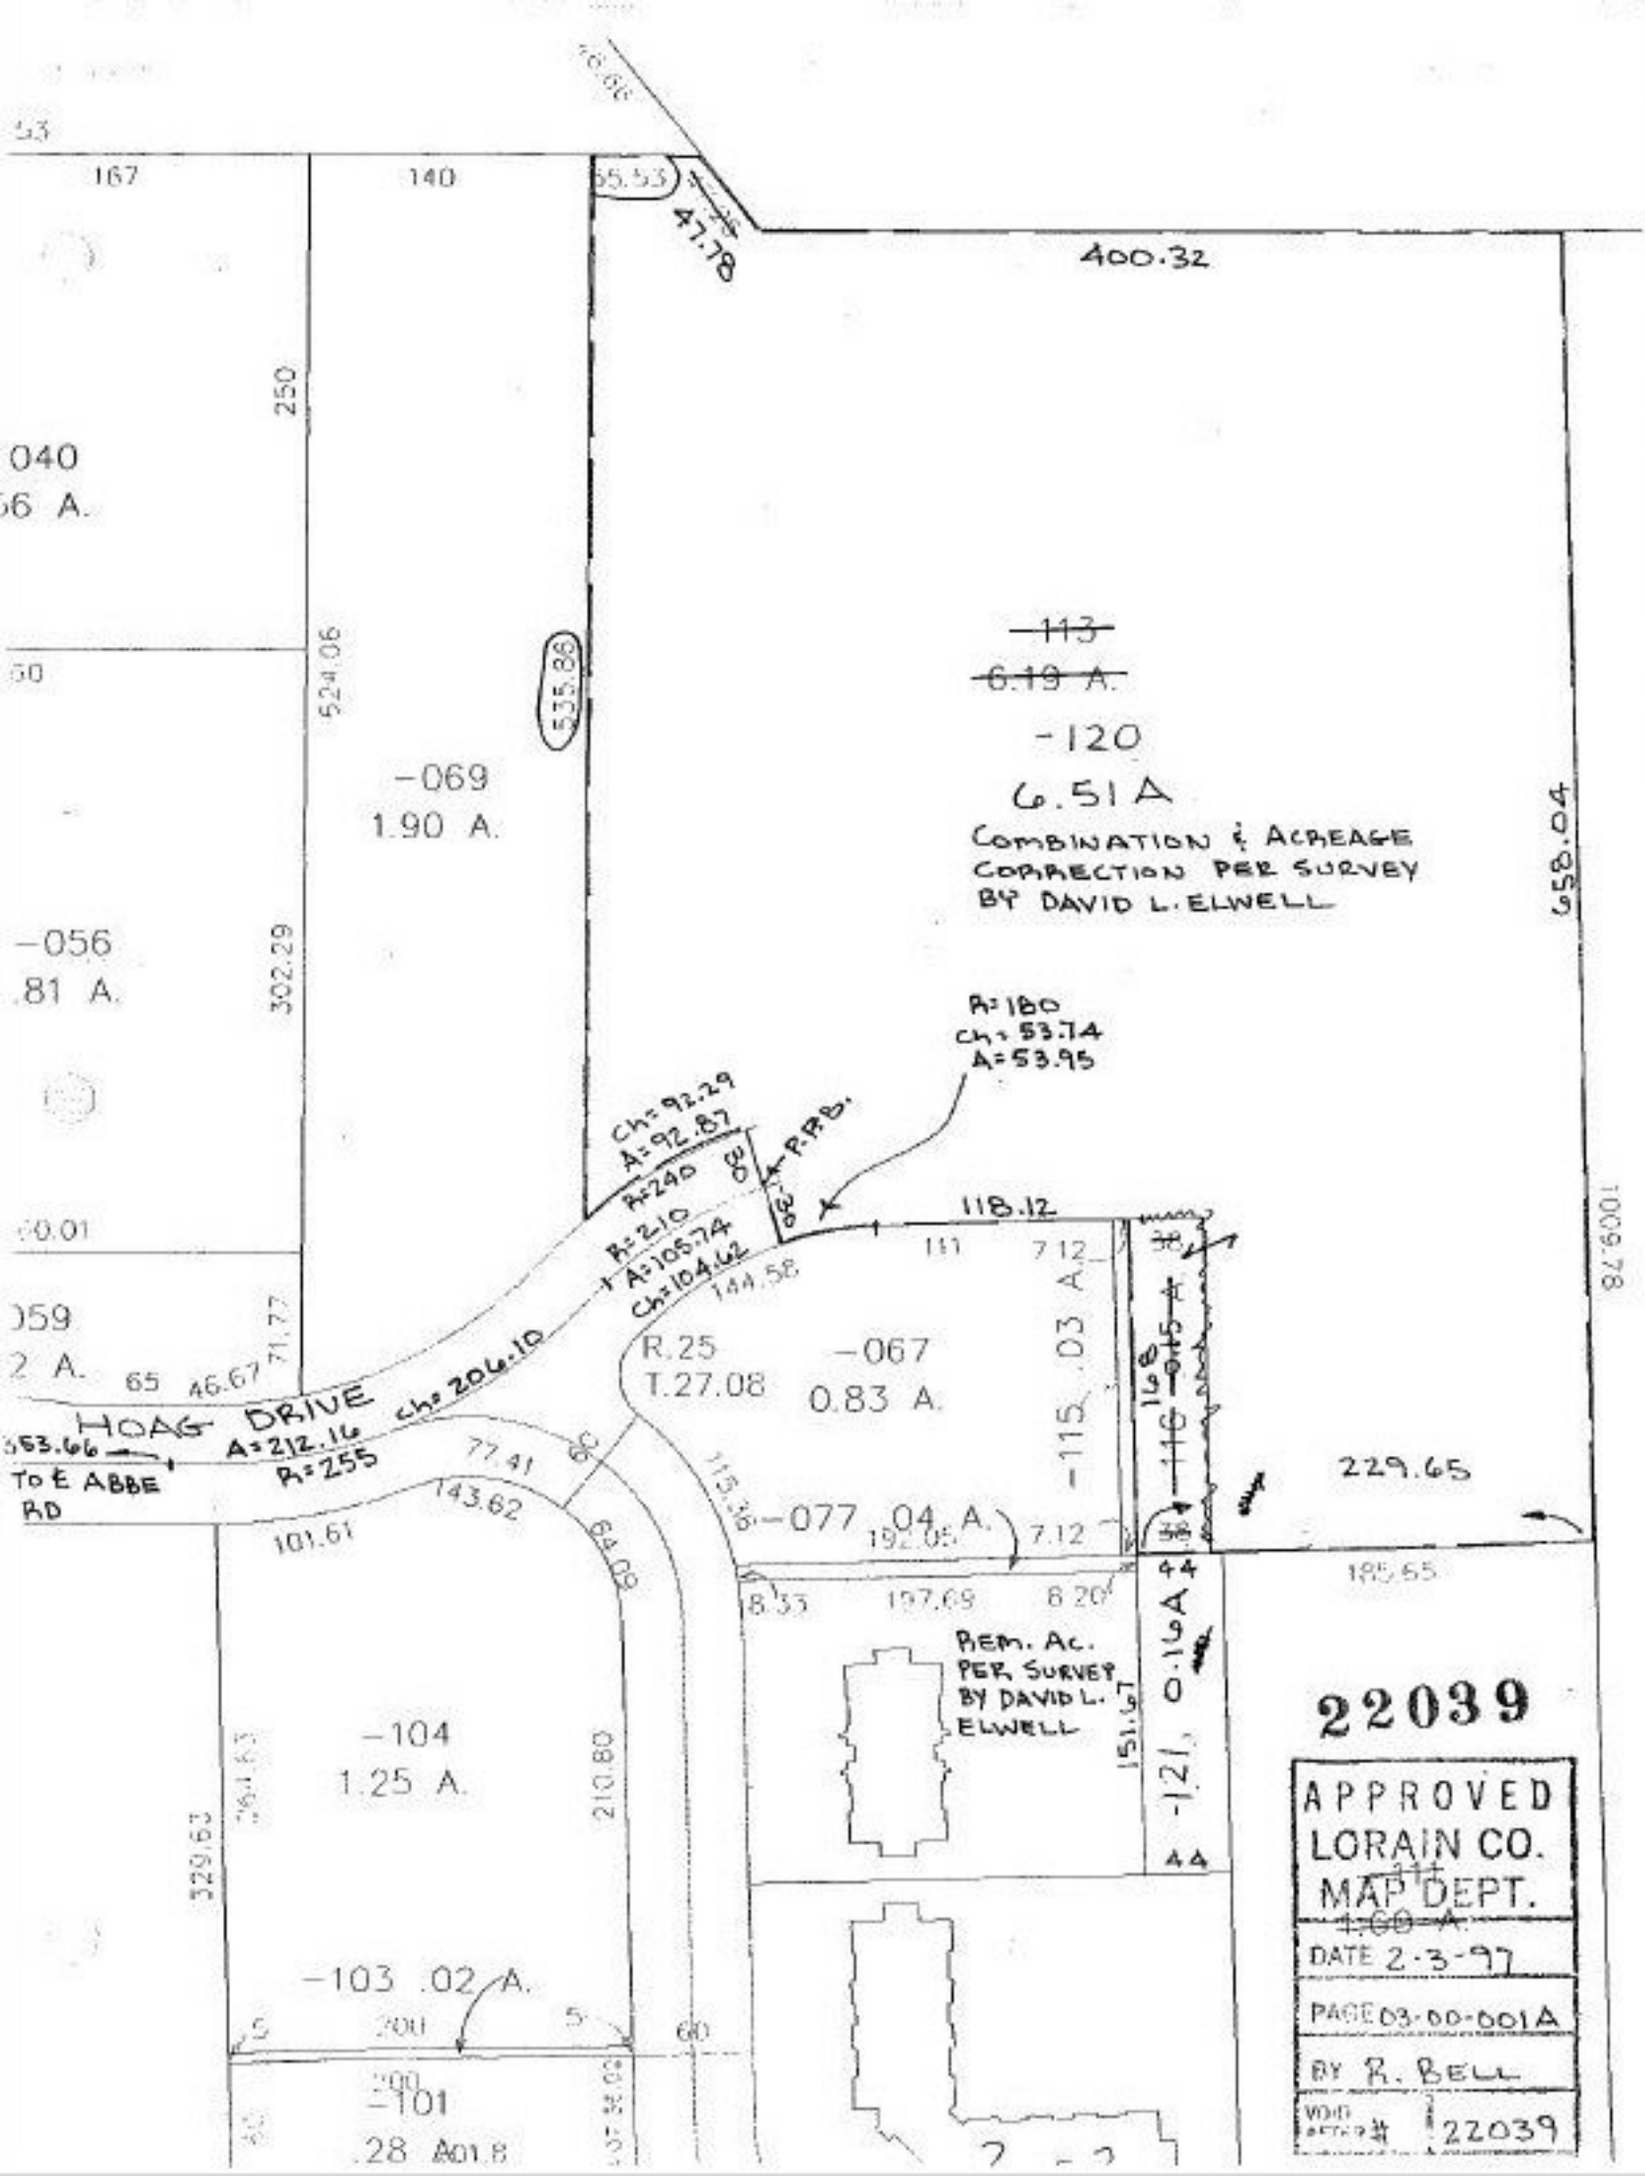
167
140
55.53
47.78
400.32
250
040
6 A.
524.06
535.86
-069
1.90 A.
-113
6.19 A.
-120
6.51 A
COMBINATION & ACREAGE CORRECTION PER SURVEY BY DAVID L. ELWELL
658.04
-056
.81 A.
302.29
R=180
Ch=53.74
A=53.95
Ch=92.29
A=92.87
R=240
P.O.B.
R=210
A=105.74
Ch=104.62
118.12
144.58
R.25
T.27.08
-067
0.83 A.
-115 .03 A.
HOAG DRIVE
Ch=206.10
A=212.16
R=255
563.66
TO E ABBE RD
77.41
143.62
101.61
64.09
115.36
-077 .04 A.
192.05
7.12
229.65
185.65
8.33
197.69
8.20
REM. AC. PER SURVEY BY DAVID L. ELWELL
151.57
-121, 0.16 A
329.63
264.63
-104
1.25 A.
210.80
-103 .02 A.
200
-101
.28 A01.8
22039
APPROVED
LORAIN CO.
MAP DEPT.
1.60 A.
DATE 2-3-97
PAGE 03-00-001A
BY R. BELL
WORK ORDER # 22039