#22039

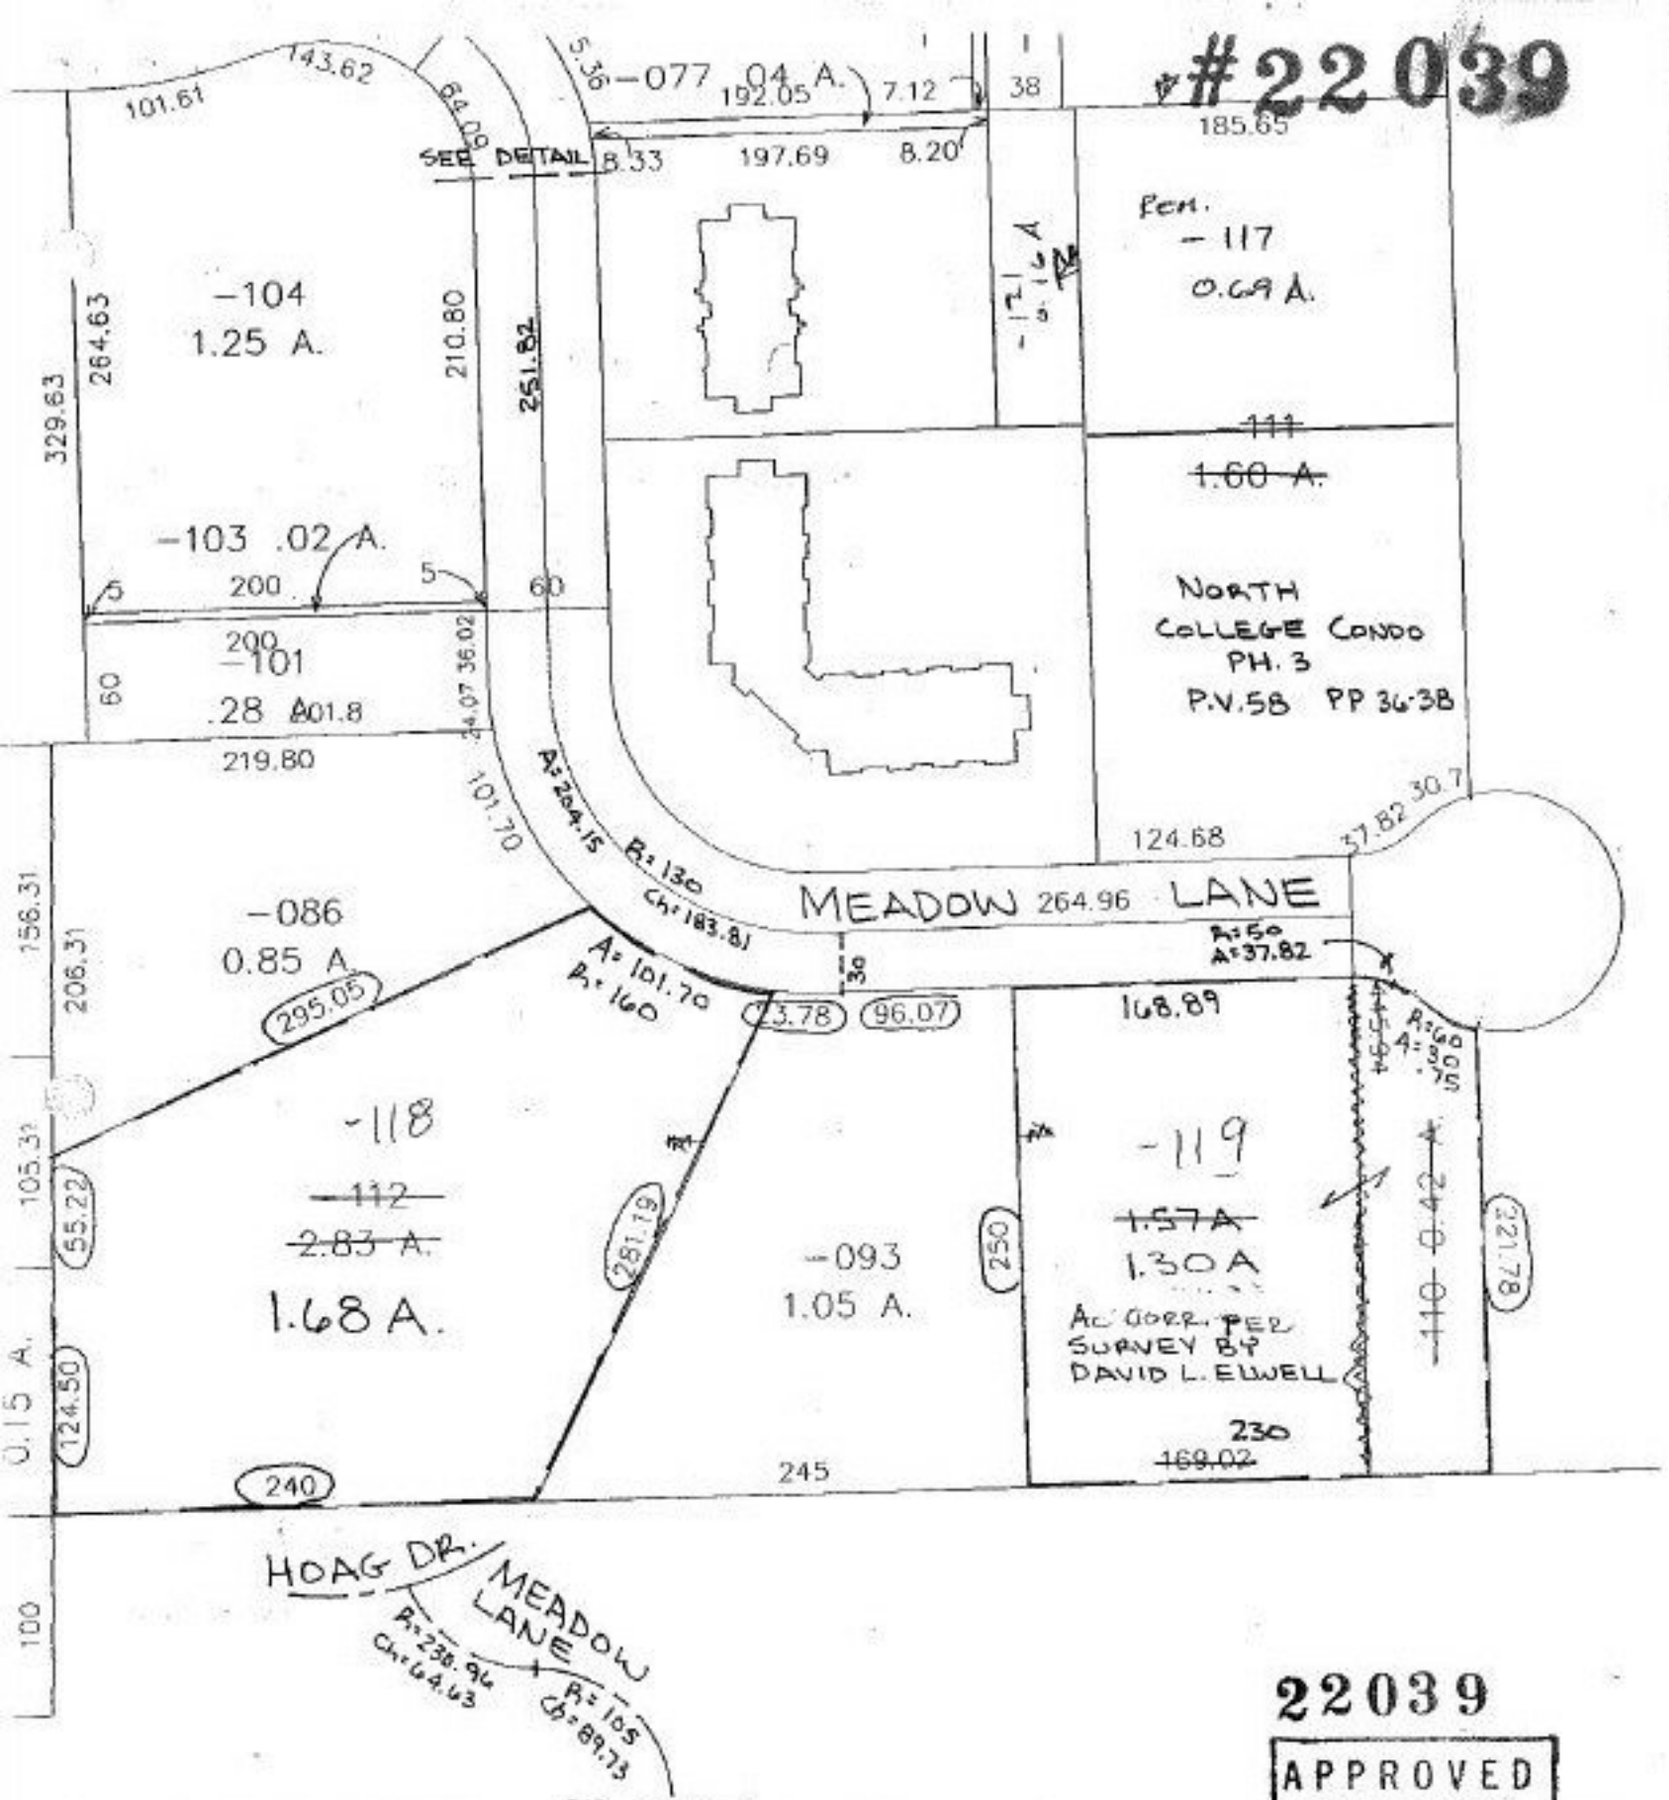

DETAIL No SCALE

PRIOR INSTRUMENT DR 293/865 1101/228

CLOSURE 0.07 PER 10,000

SURVEYED BY DAVID L ELWELL

22039

APPROVED LORAIN CO. MAP DEPT.
DATE 2-3-97
PAGE 03-00-001A
BY R. BELL
VOID AFTER # 22039