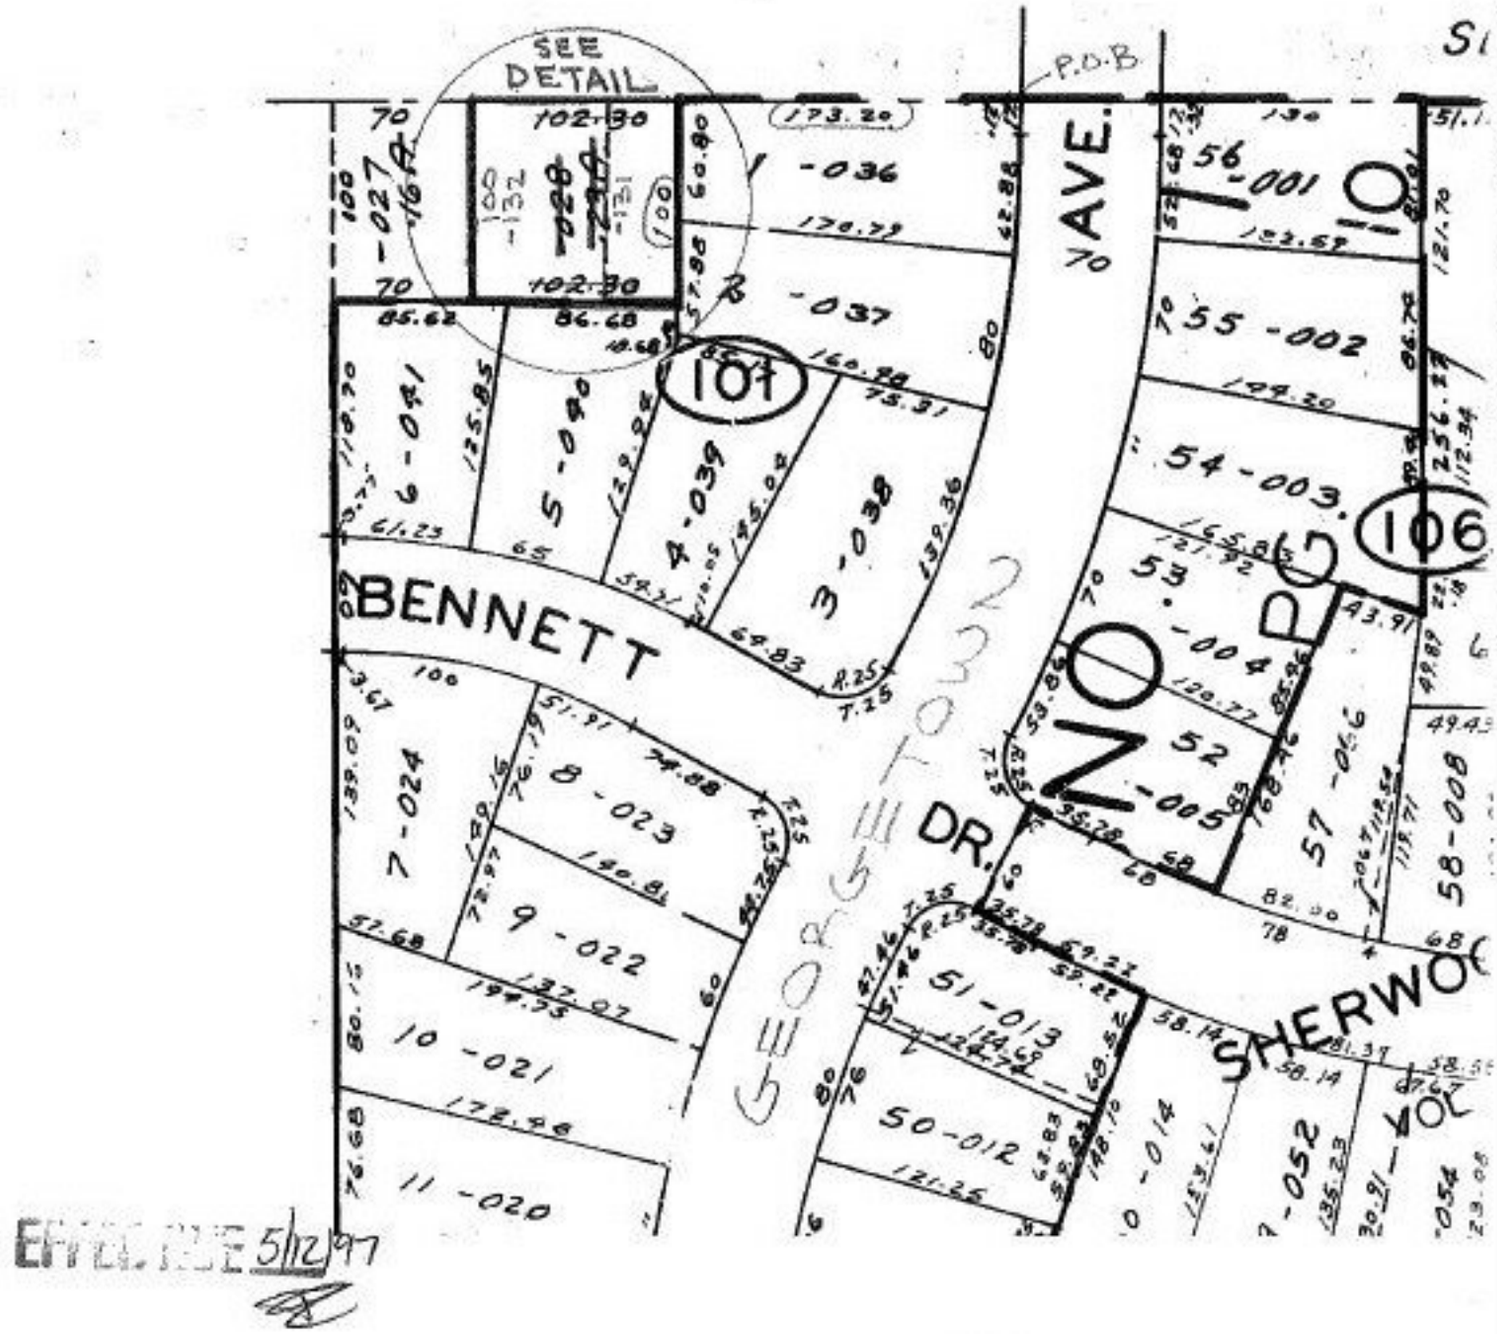

EFFECTIVE 5/12/97

NW. CORNER S/L 1

PRIOR INSTRUMENT 935/110

CLOSURE 0.00 PER 10,000

SURVEYED BY RODGER G SIMON

DP 9-24-98

22042

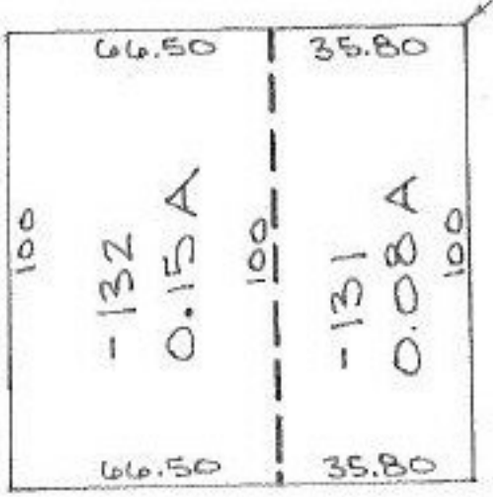

DETAIL

NO SCALE

APPROVED
LORAIN CO.
MAP DEPT.
DATE 1-16-97
PAGE 6-72
BY R. BELL
MAP # 22042