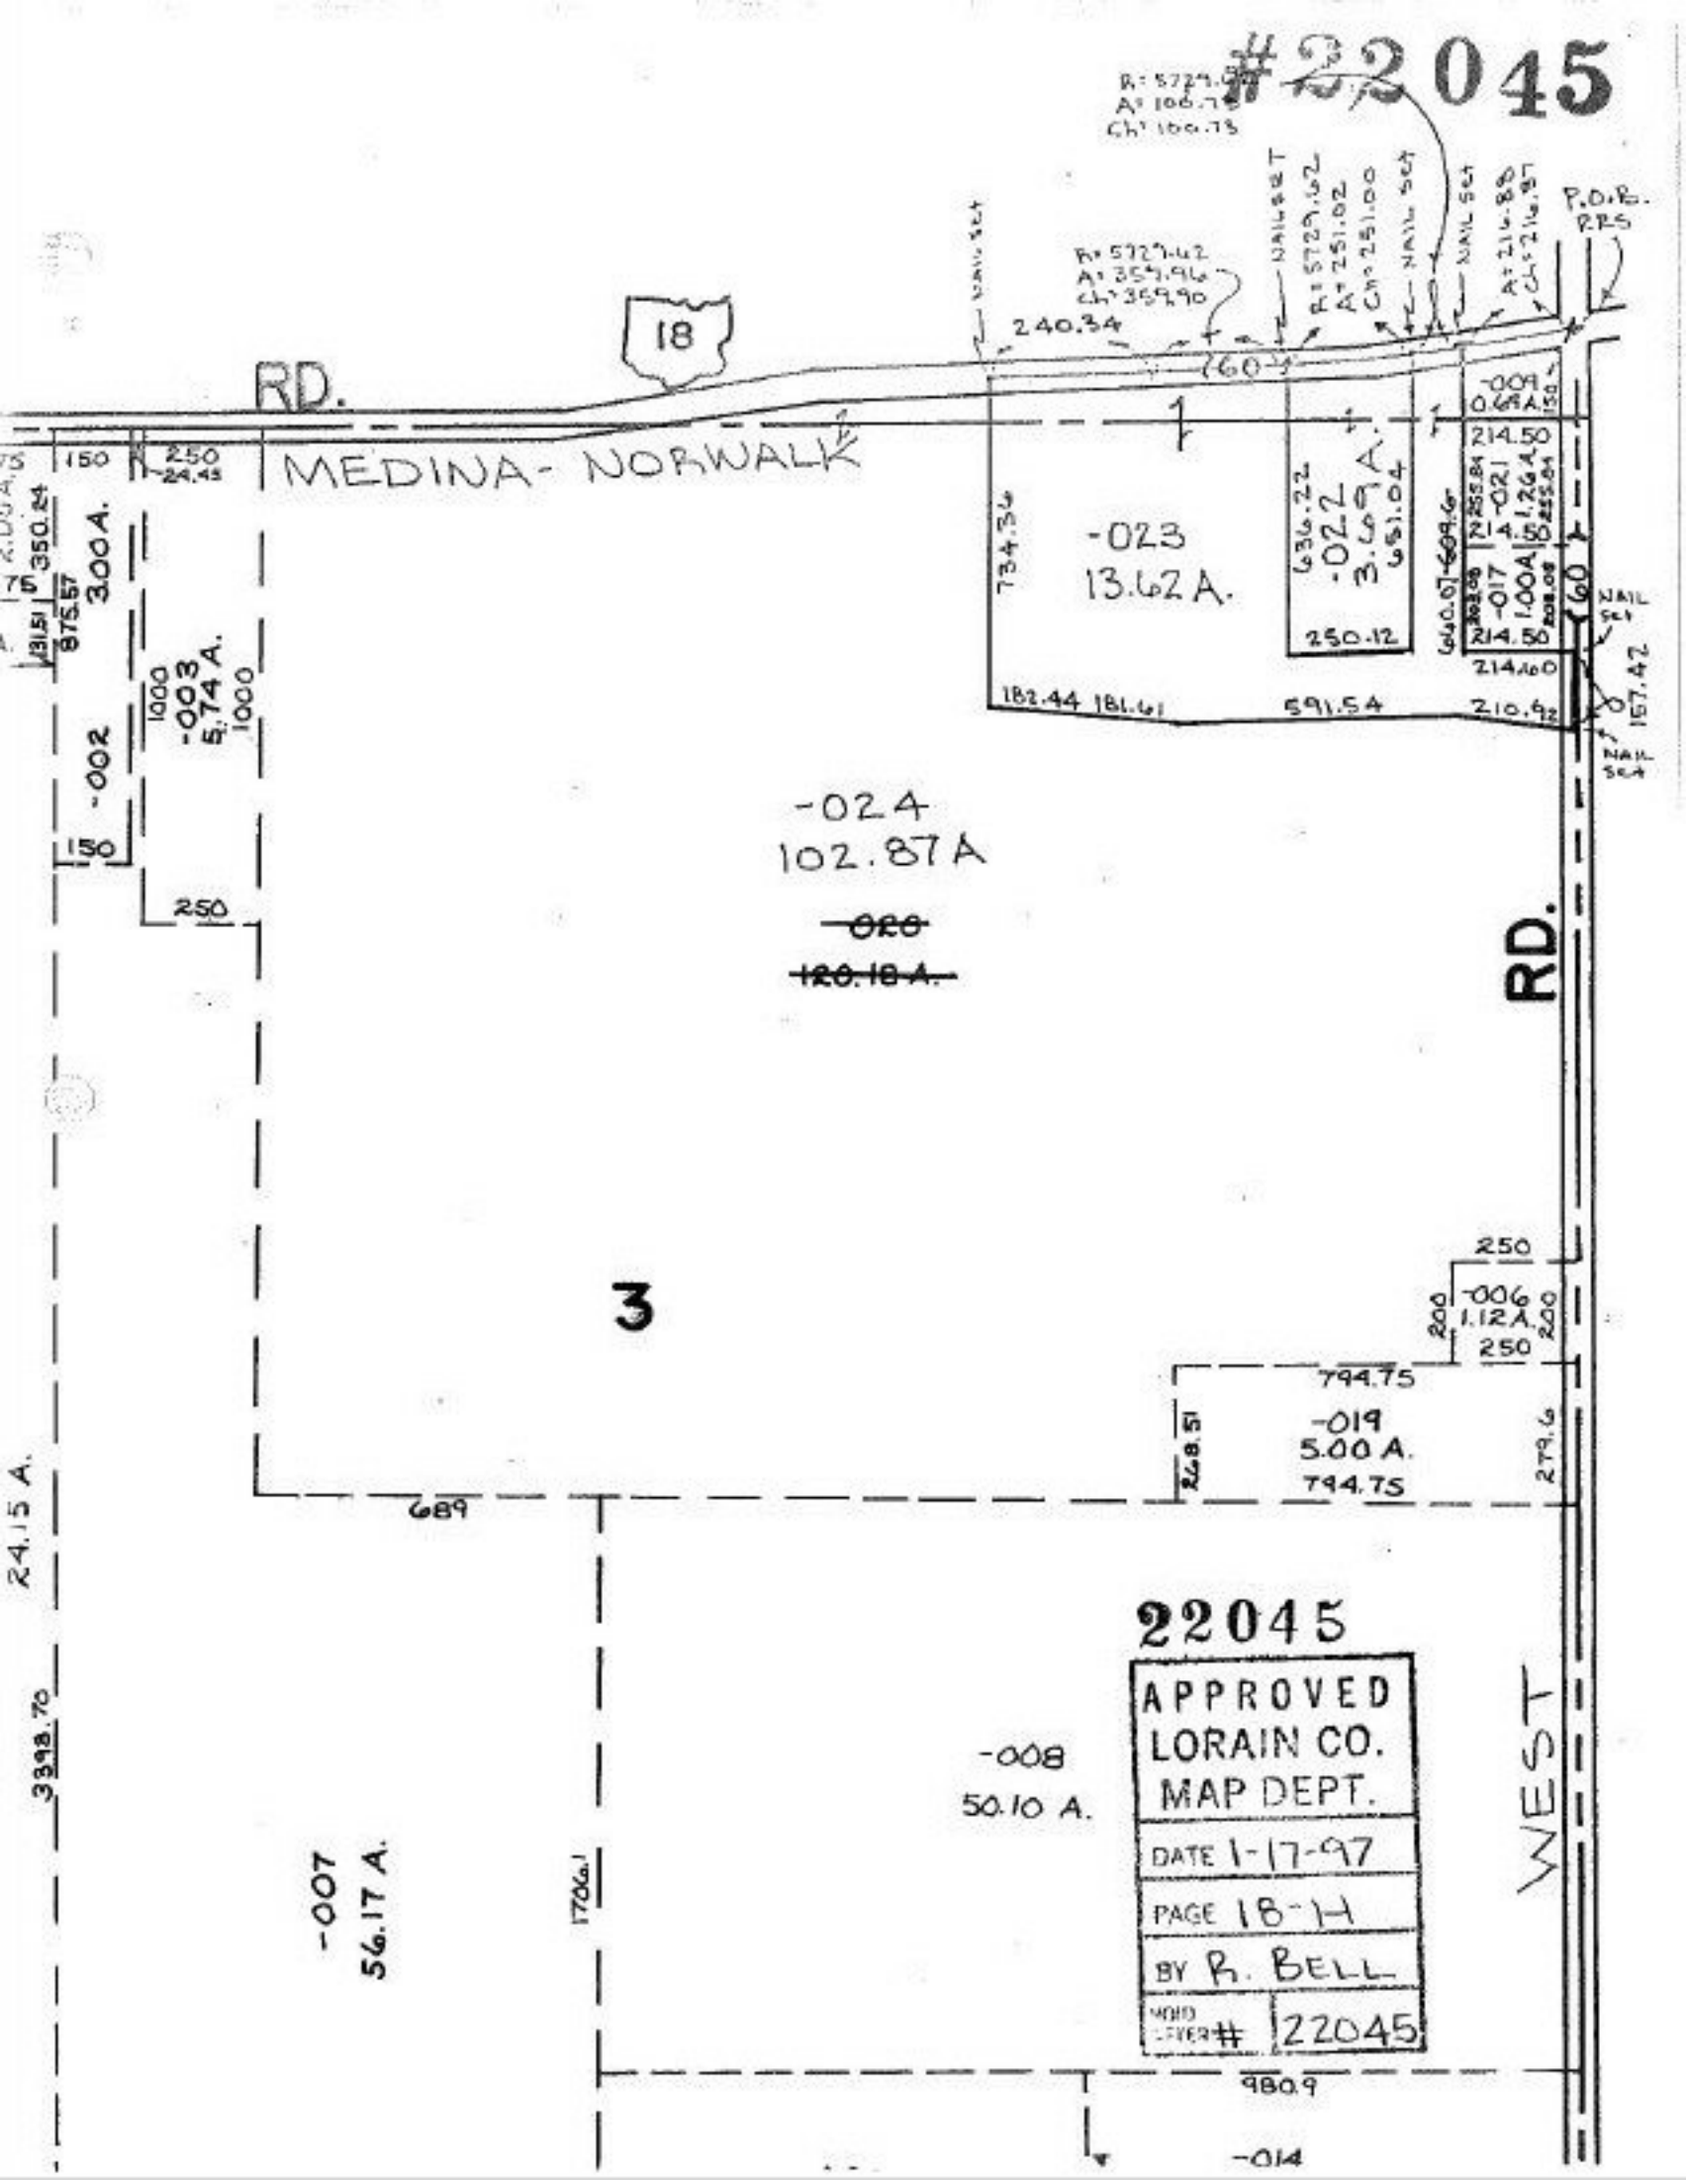
#22045
18
RD.
MEDINA- NORWALK
P.O.B. RRS
NAIL SET
240.34
-023
13.62 A.
-022
3.69 A.
-021
1.26 A.
-017
1.00 A.
-009
0.69 A.
-024
102.87 A
~~-020~~
~~120.18 A.~~
-002
3.00 A.
-003
5.74 A.
-006
1.12 A.
-019
5.00 A.
-008
50.10 A.
-007
56.17 A.
-014
3
24.15 A.
3398.70
689
1706.1
980.9
794.75
268.51
279.6
250
150
214.50
214.60
182.44
181.61
591.54
210.92
157.42
734.36
636.22
651.04
250.12
-009
-014
WEST
22045
APPROVED
LORAIN CO.
MAP DEPT.
DATE 1-17-97
PAGE 18-H
BY R. BELL
VOID LEVER # 22045