


SEE 12-00-046-A

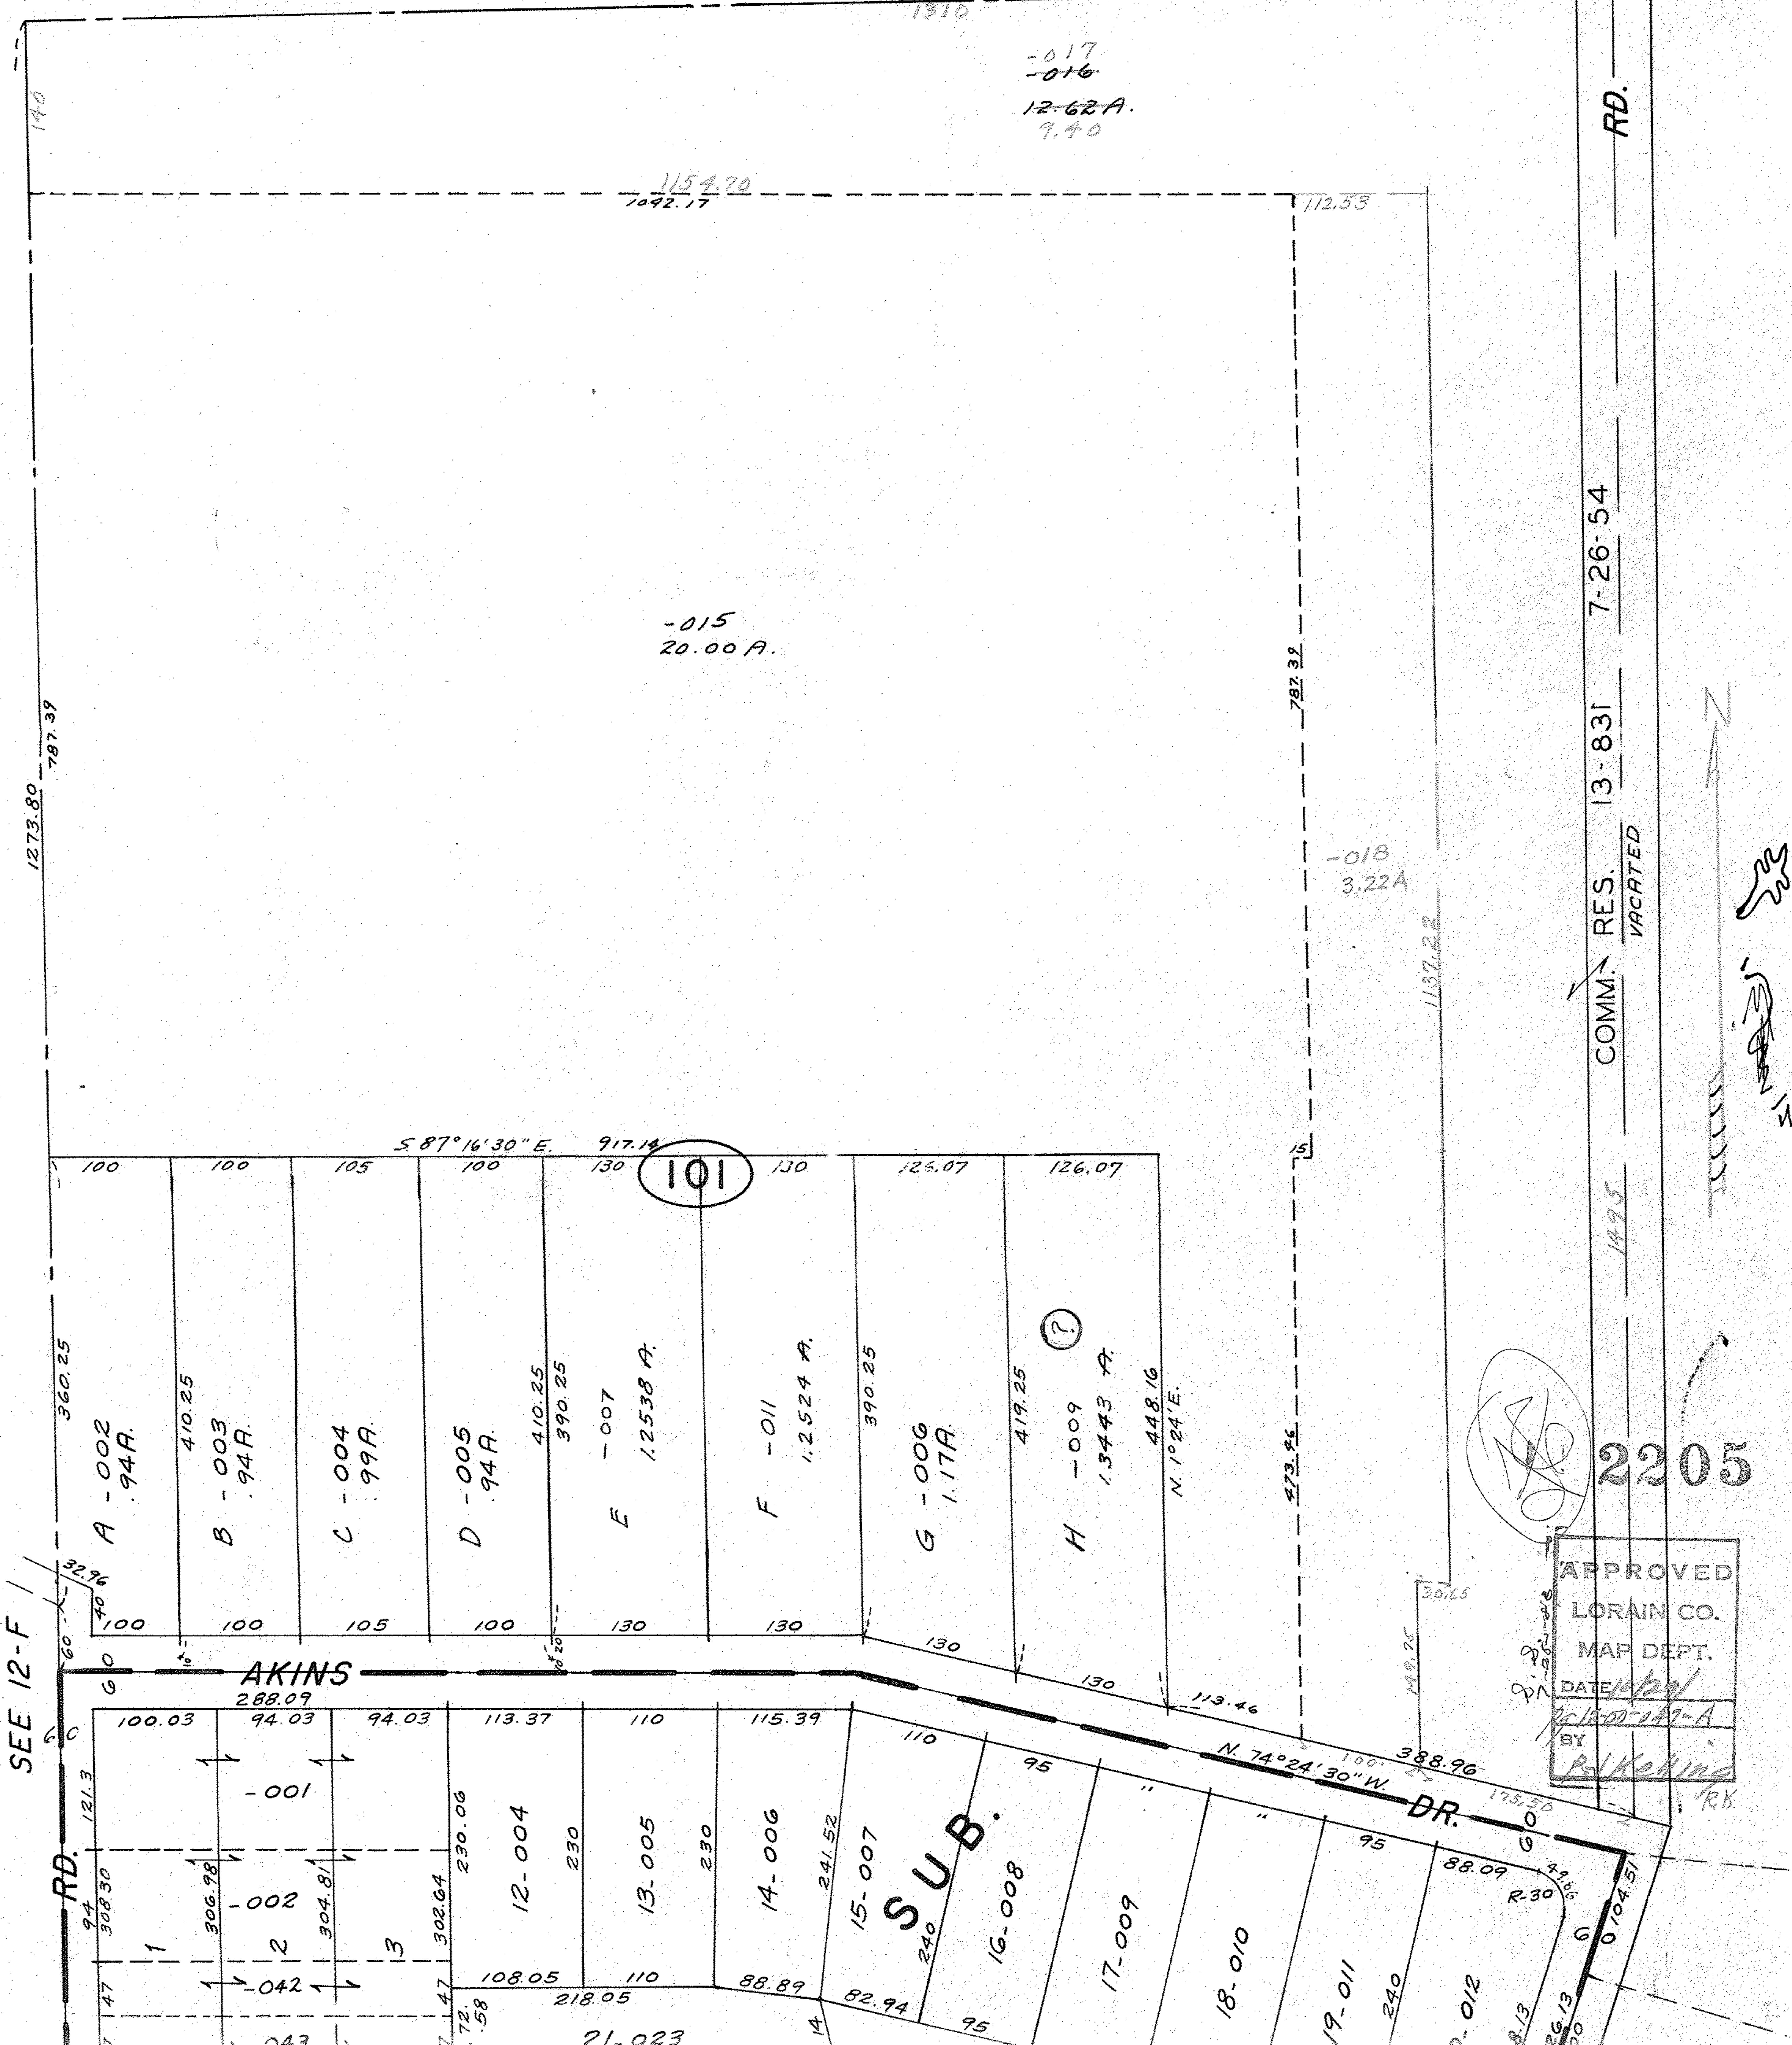

-015  
20.00 A.

1310  
-017  
-016  
12-62A.  
9.40

1154.70  
1092.17

112.55

787.32

-018  
3.22A

1137.22

RD.

13-831

COMM. RES. VACATED

7-26-54

1995

2205

APPROVED  
LORAIN CO.  
MAP DEPT.

DATE 4/24/01  
BY R. K. King

SEE 12-F

RD.

AKINS

SUB.

DR.

30.65

149.25

149.25

