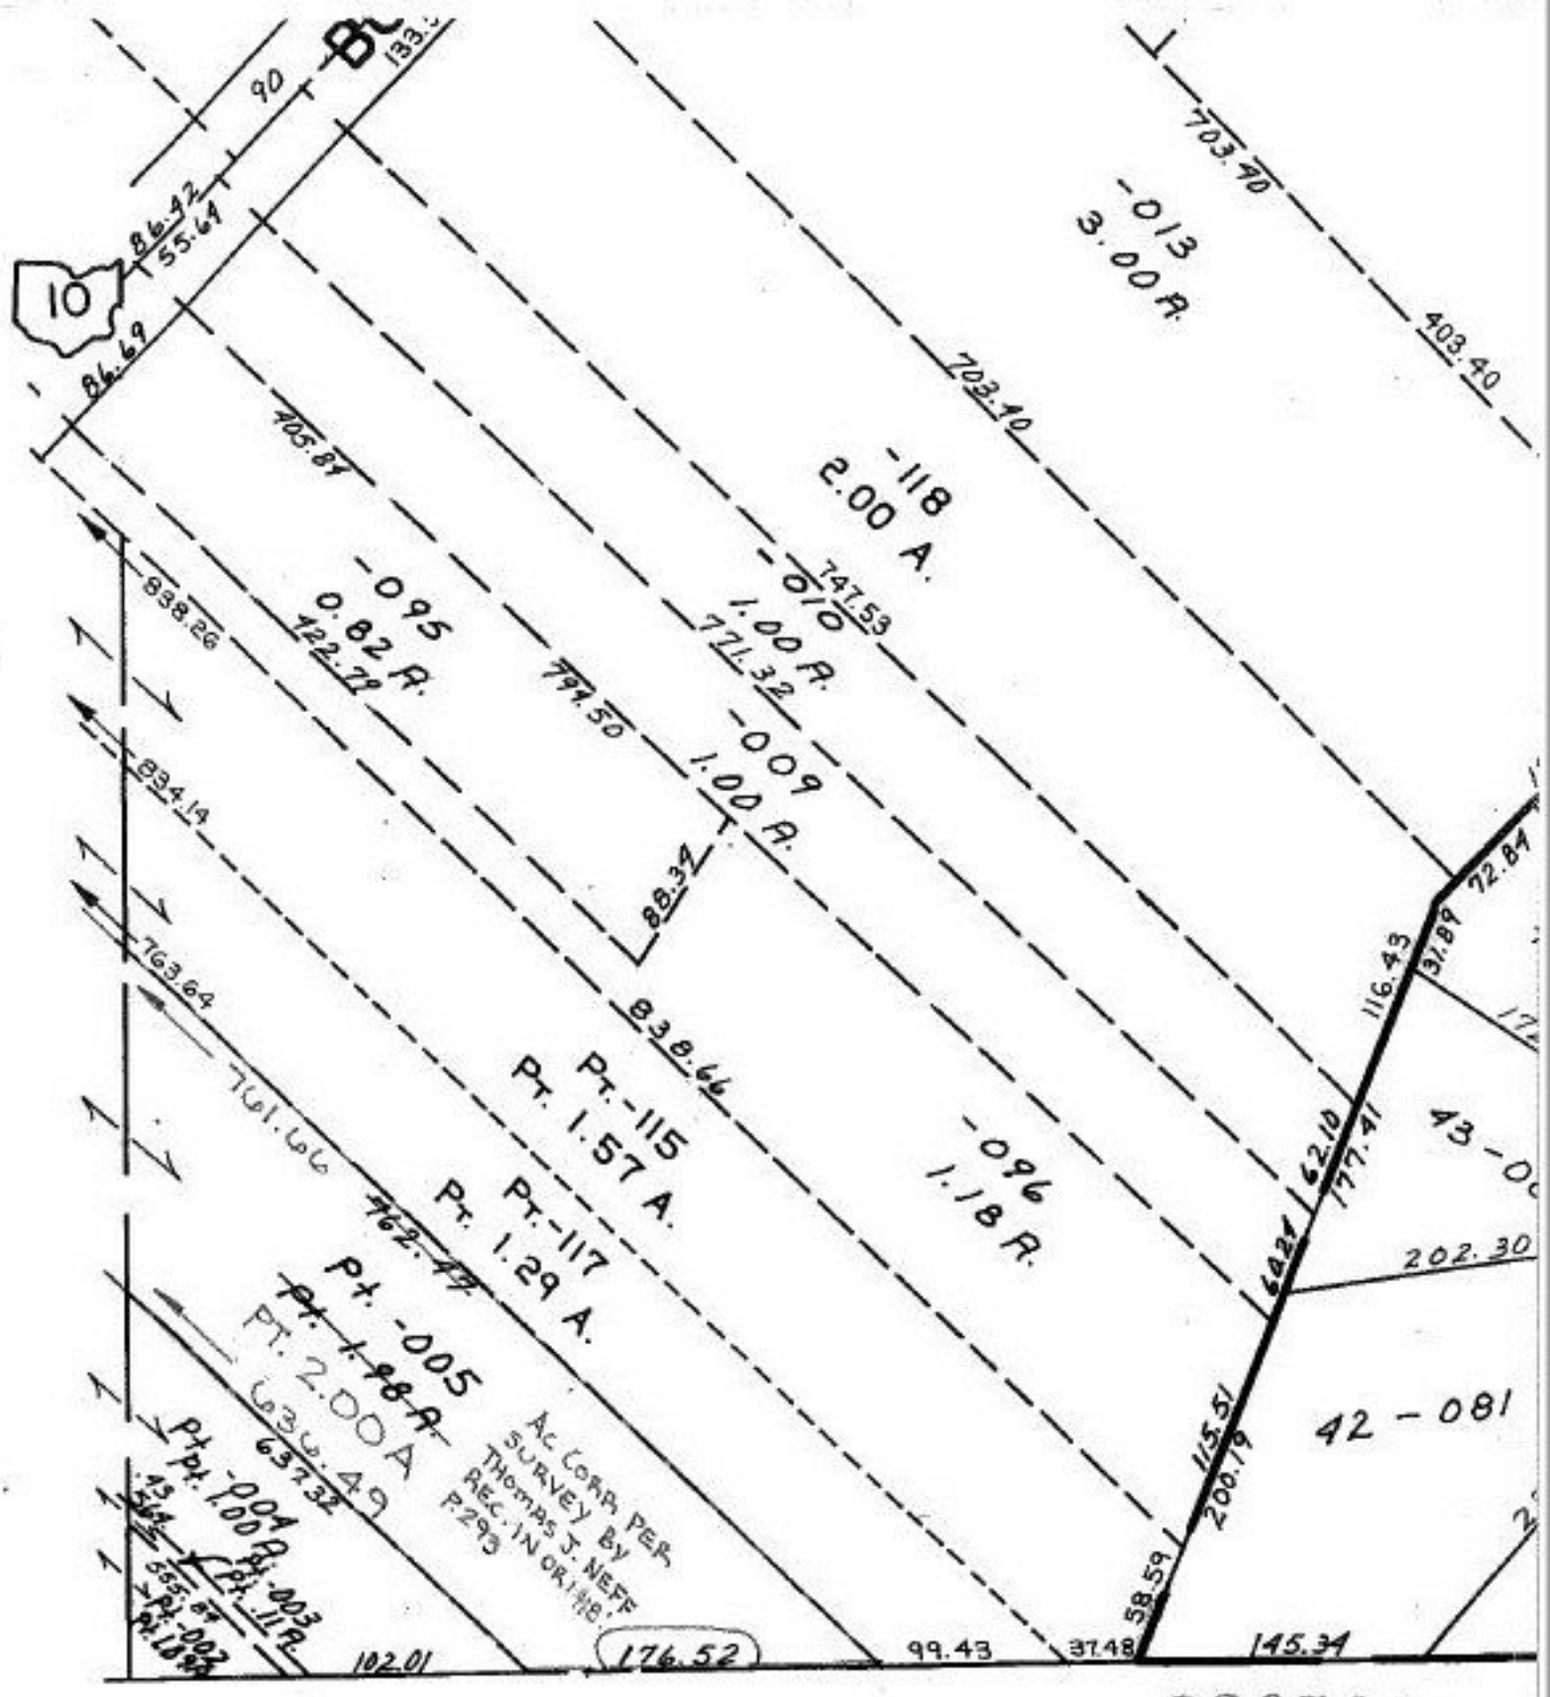

22050-D

EFFECTIVE ACS
R 9-3-97

R. Bell
5/2/97

APPROVED LORAIN CO. MAP DEPT.
DATE 1-30-97
PAGE 07-00-014D
BY R. BELL
22050-D