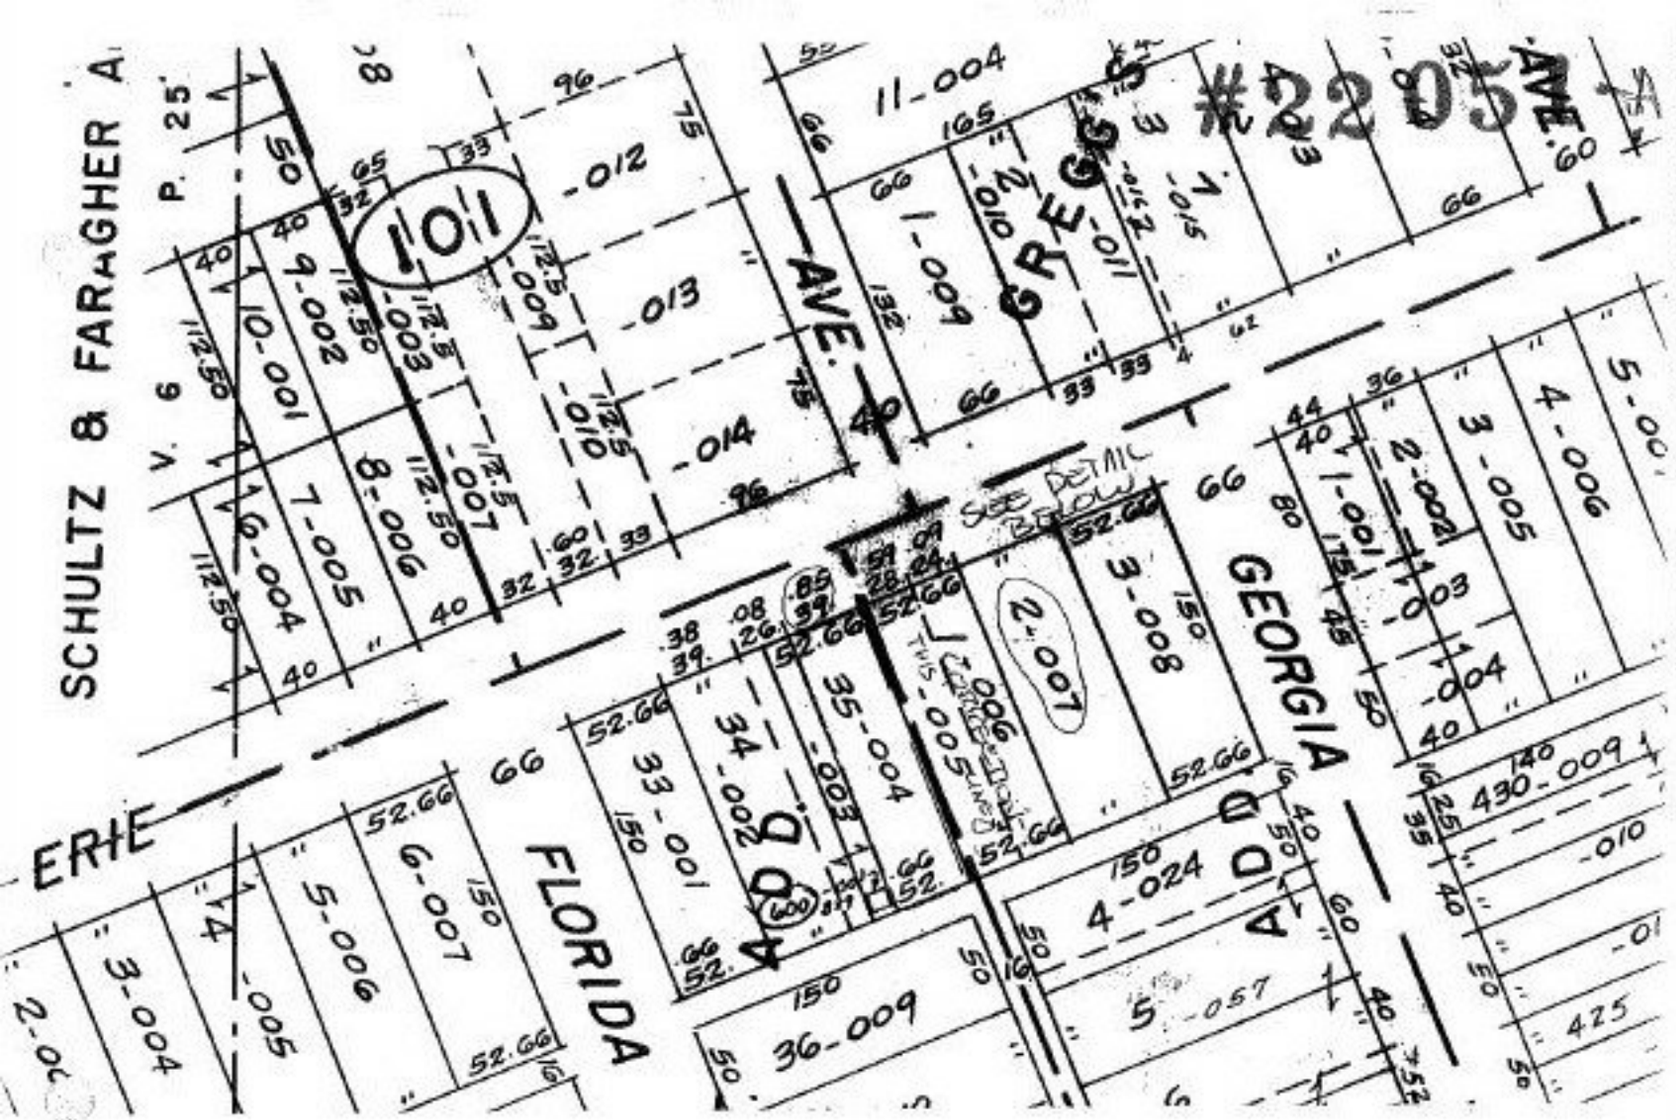

DETAIL 1"=50'

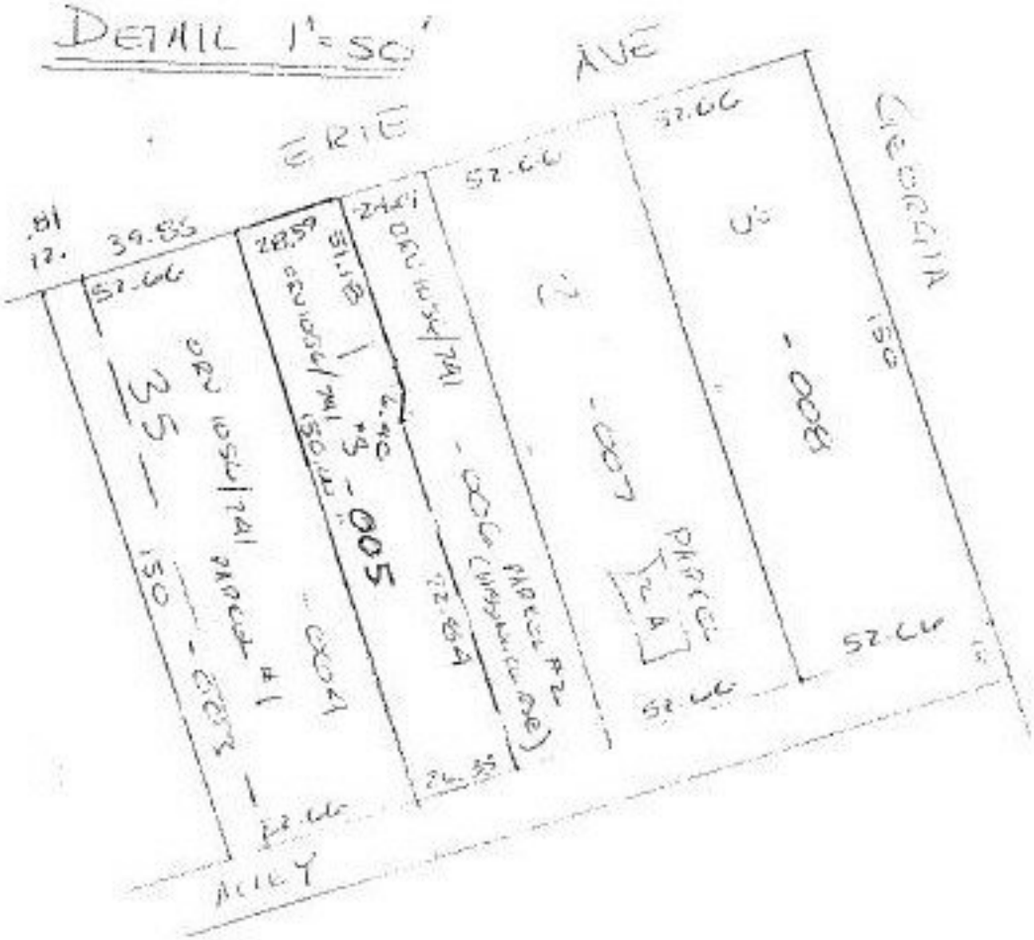

22051-A

APPROVED
LORAIN CO.
MAP DEPT.
DATE 2-14-97
PAGE 2-01-003-B
BY T. McNair
JOB NO. # 22051-A