SEE 1-A

BROWNHELM STATION RD

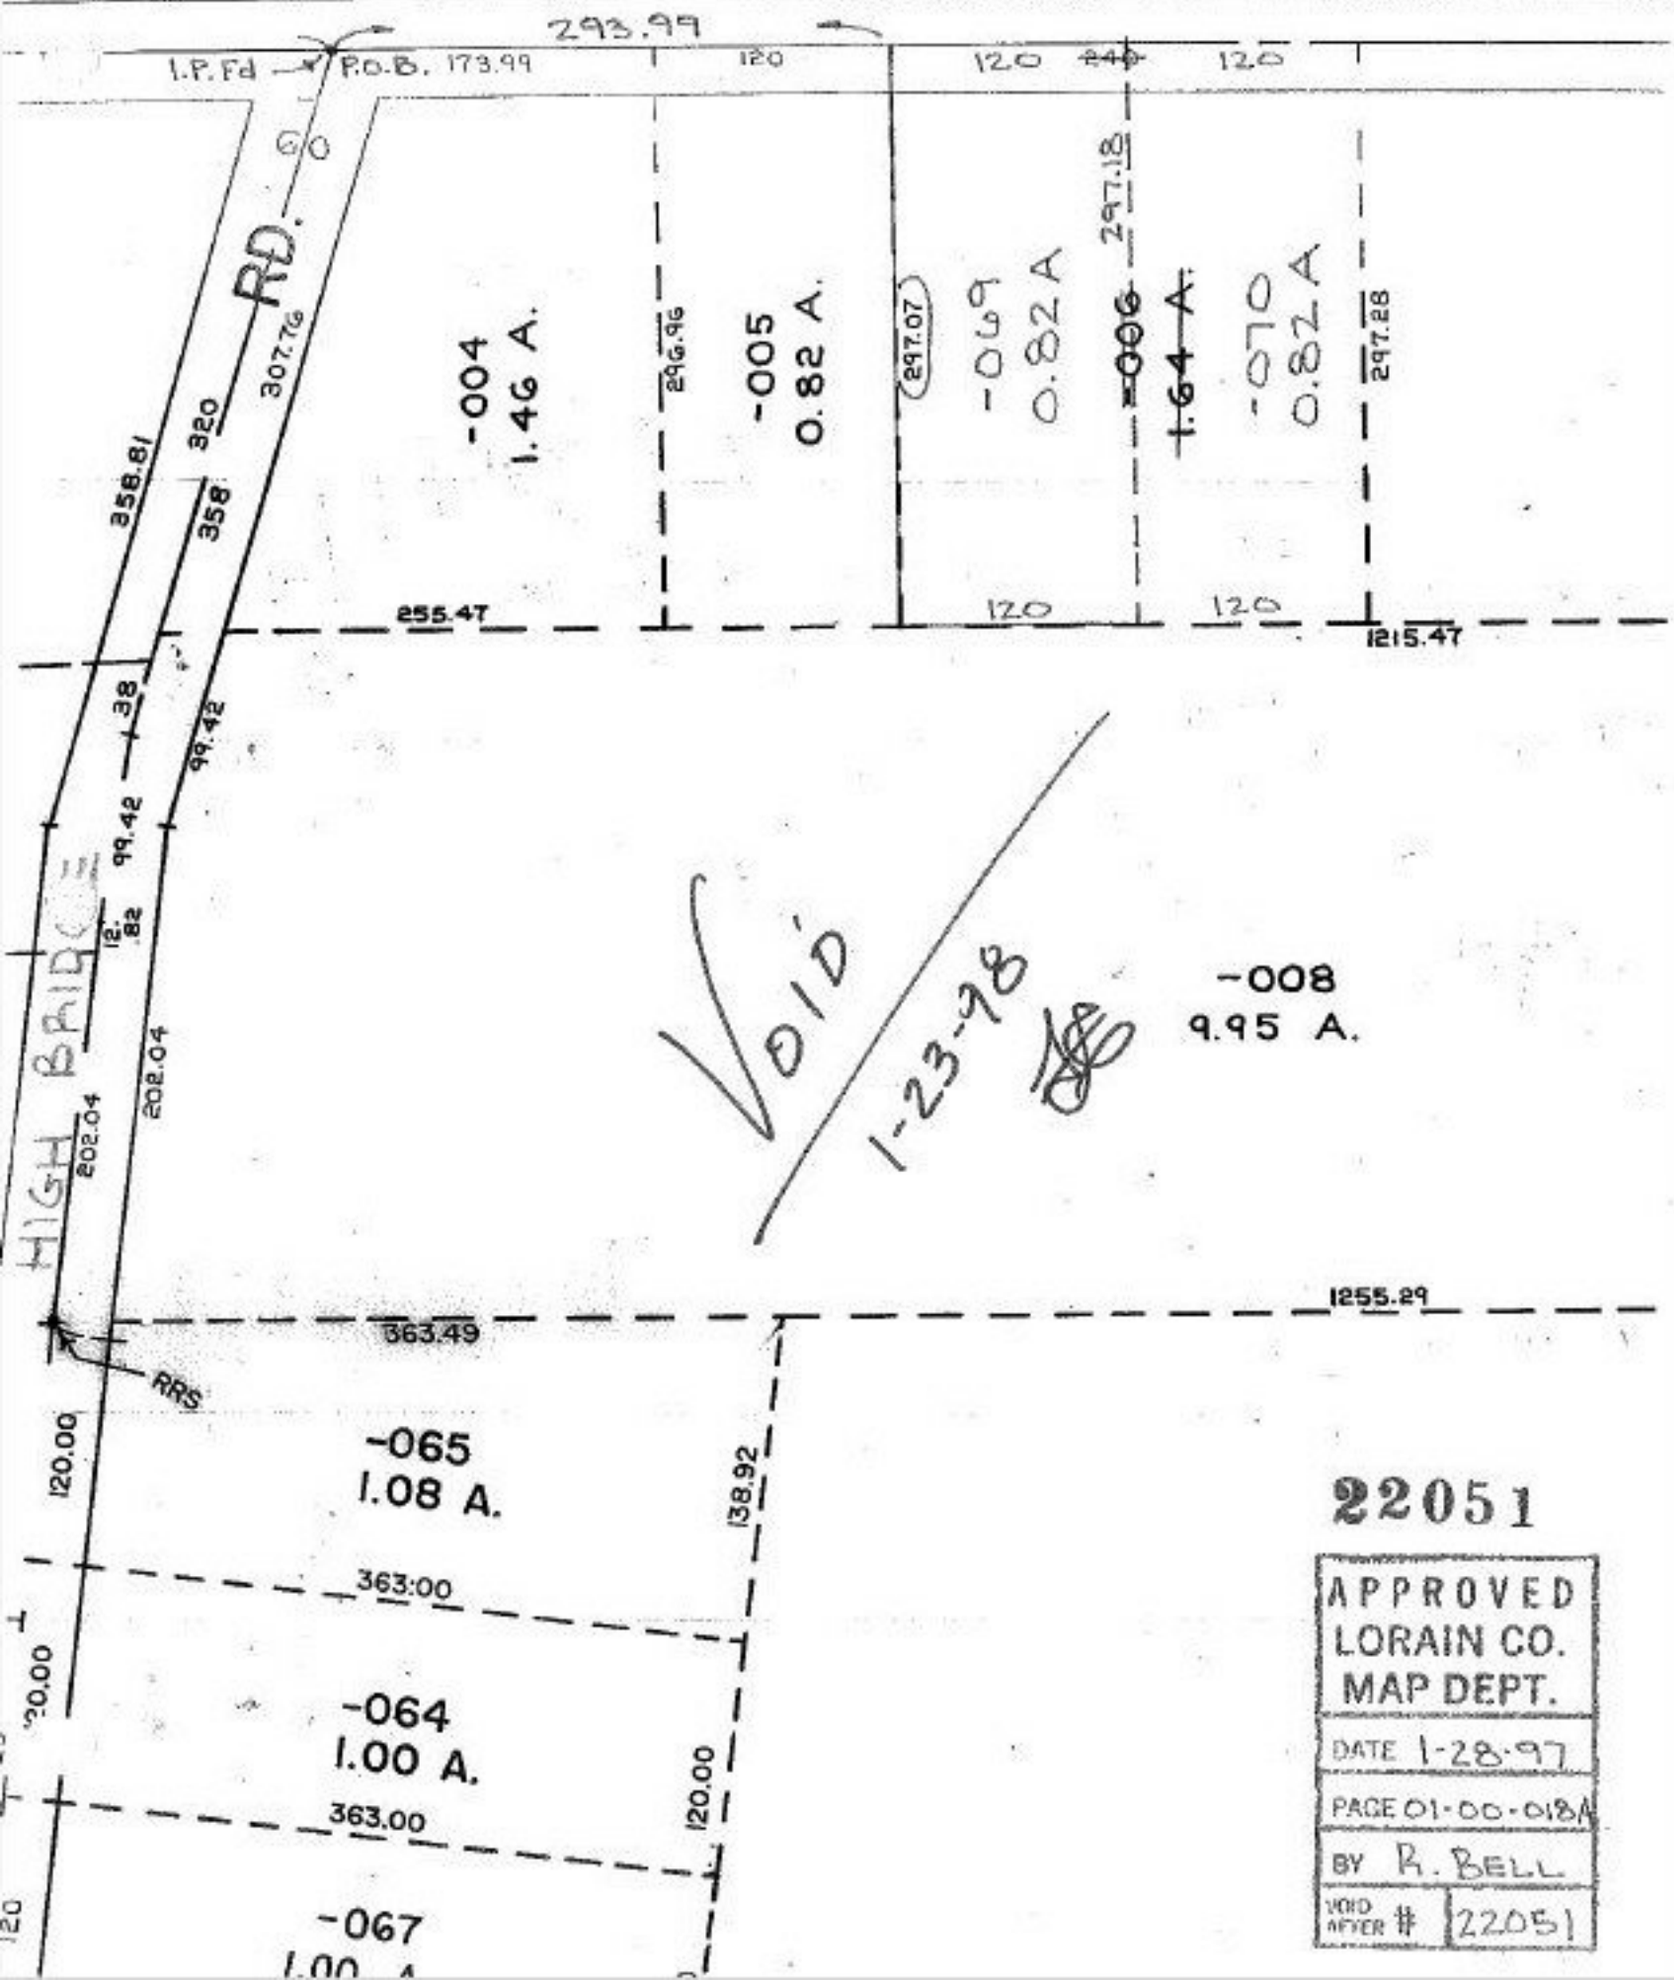

22051

APPROVED
LORAIN CO.
MAP DEPT.

DATE 1-28-97

PAGE 01-00-018A

BY R. BELL

VOID AFTER # 22051