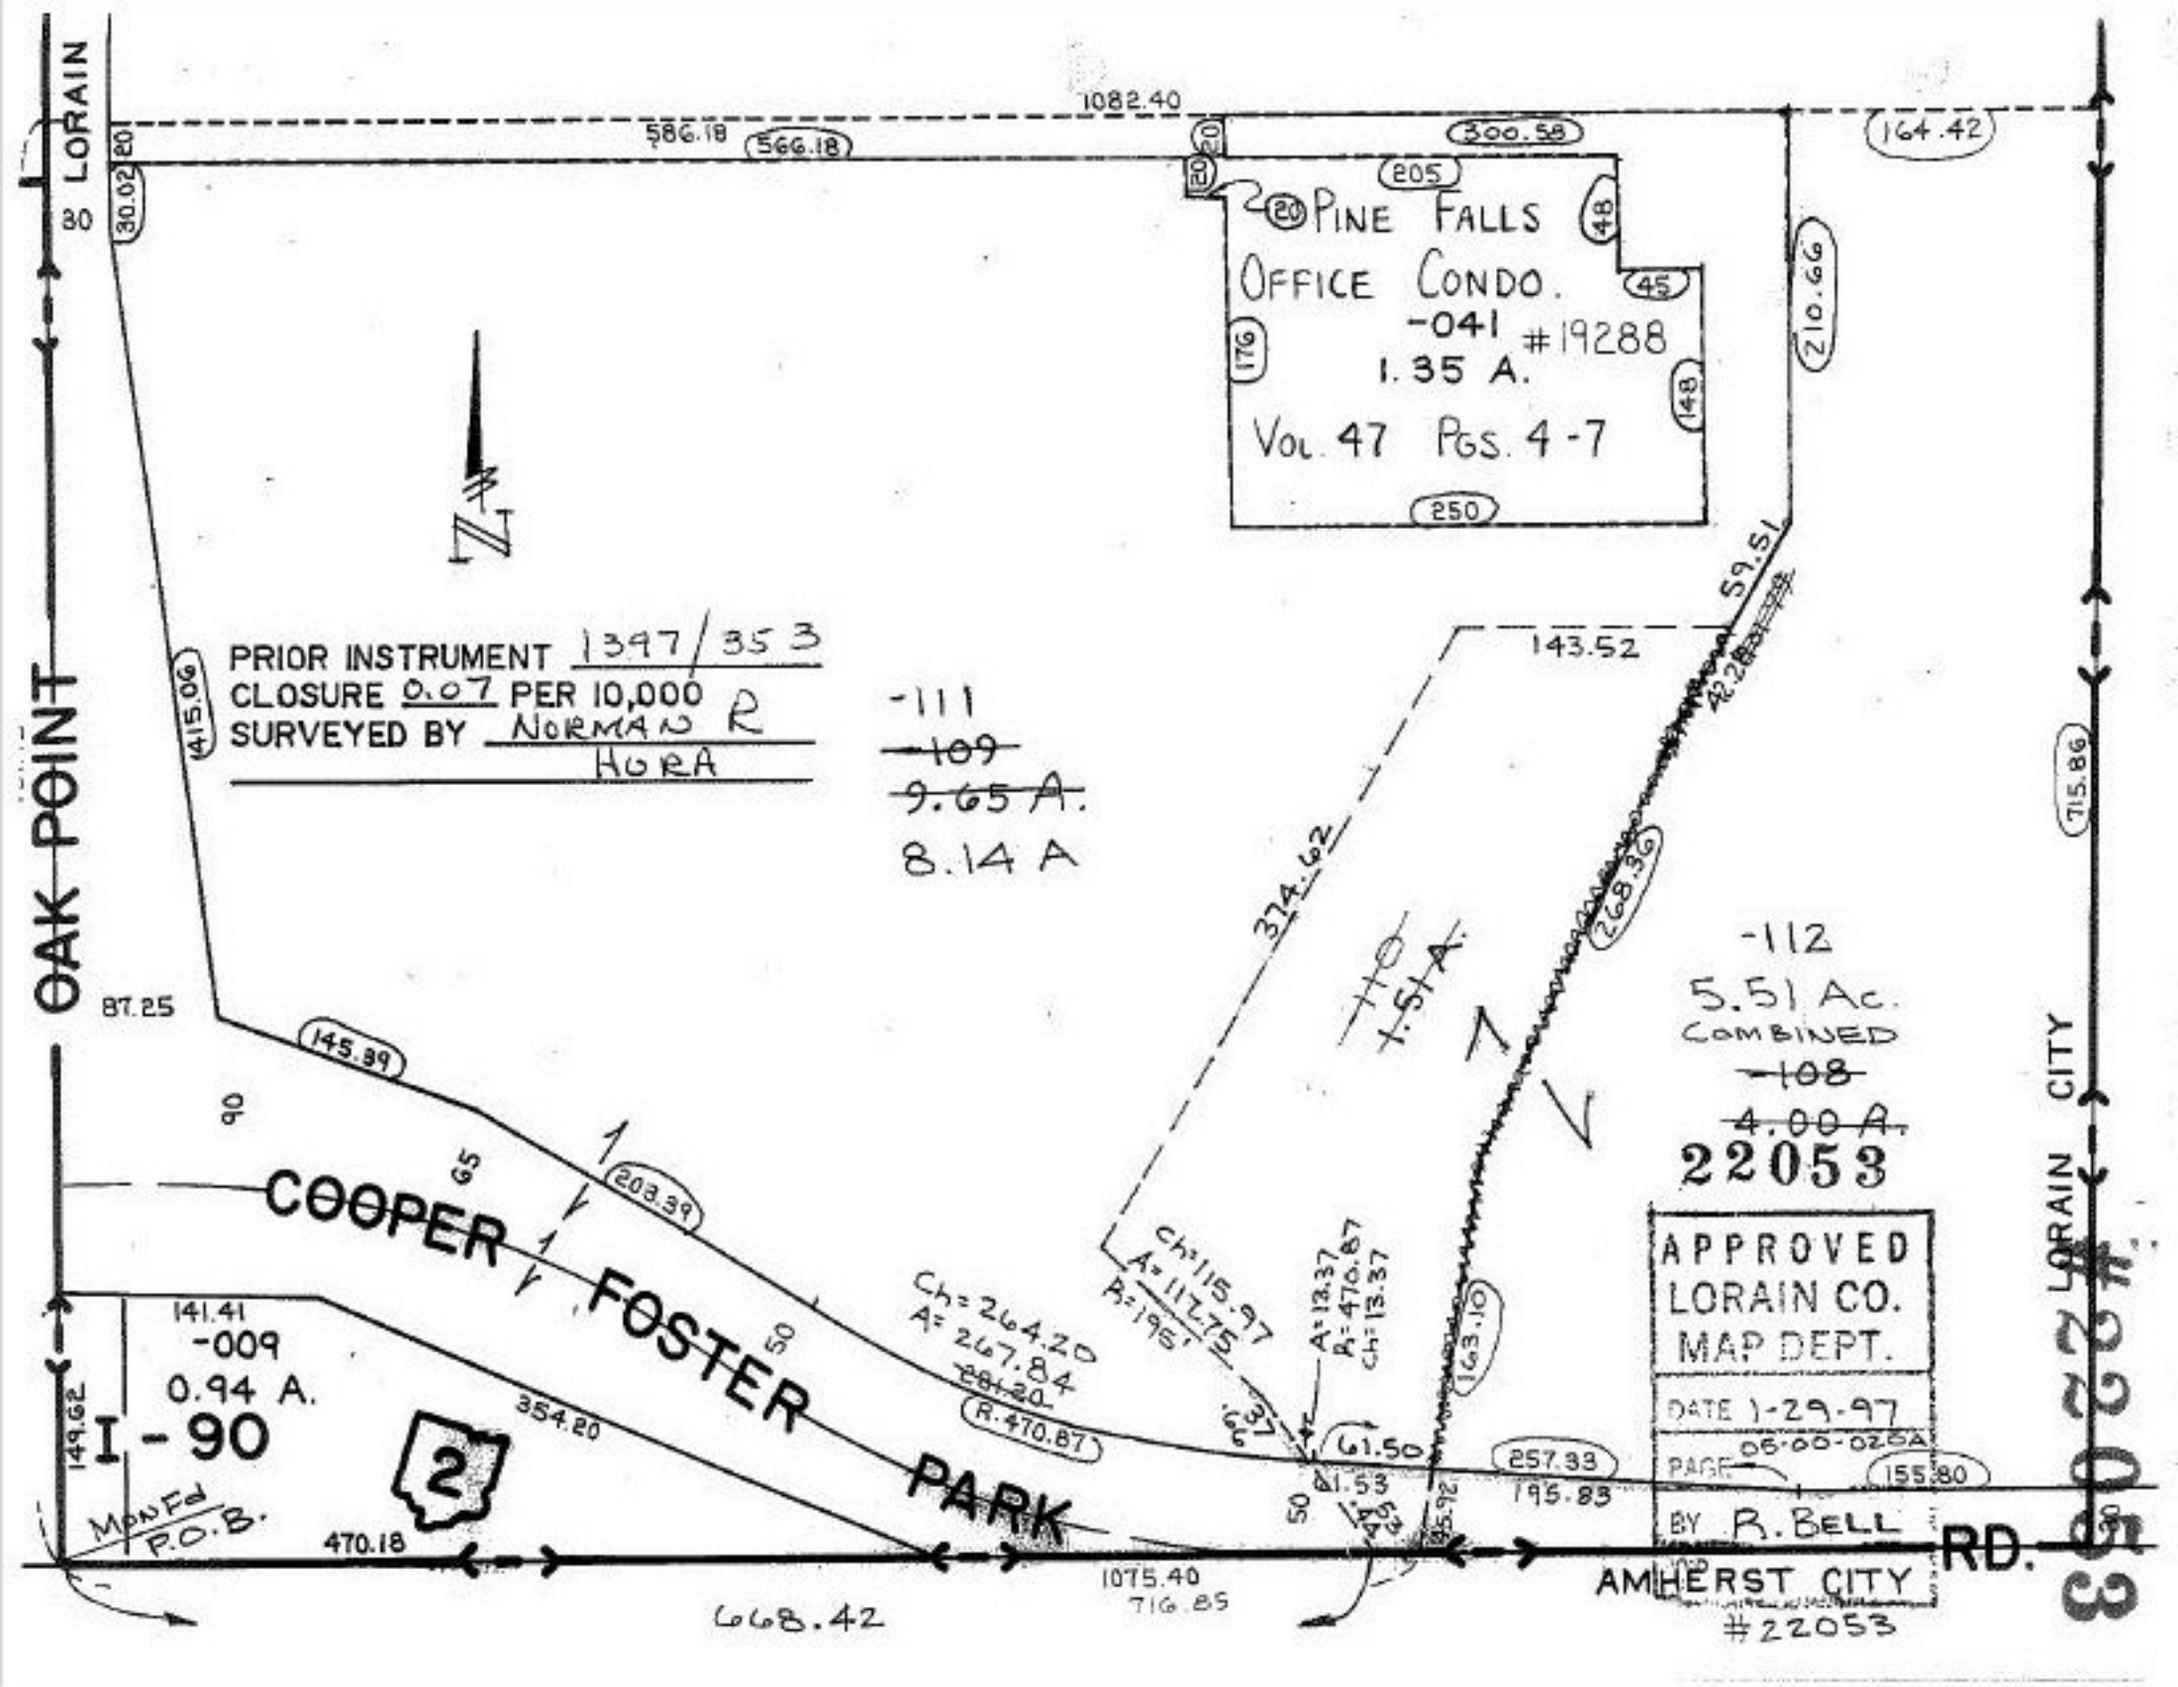
OAK POINT
LORAIN
80
1082.40
586.18
566.18
20
30.02
415.06
PINE FALLS
OFFICE CONDO.
-041 #19288
1.35 A.
Vol. 47 Pgs. 4-7
300.58
205
48
45
176
148
250
164.42
210.66
59.51
143.52
374.62
268.36
715.86
PRIOR INSTRUMENT 1397/353
CLOSURE 0.07 PER 10,000
SURVEYED BY NORMAN R HORA
-111
~~109~~
~~9.65 A.~~
8.14 A
-112
5.51 Ac.
COMBINED
~~108~~
~~4.00 A.~~
22053
87.25
145.89
90
65
COOPER
FOSTER
PARK
208.39
Ch=264.20
A=267.84
~~281.20~~
(R.470.87)
Ch=115.97
A=117.75
R=196'
A=13.37
R=470.87
Ch=13.37
163.10
61.50
61.53
257.33
195.83
155.80
141.41
-009
0.94 A.
I-90
354.20
149.62
MonFd
P.O.B.
470.18
668.42
1075.40
716.85
RD.
AMHERST CITY
#22053
LORAIN CITY
APPROVED
LORAIN CO.
MAP DEPT.
DATE 1-29-97
PAGE 06-00-025A
BY R. BELL