#22055

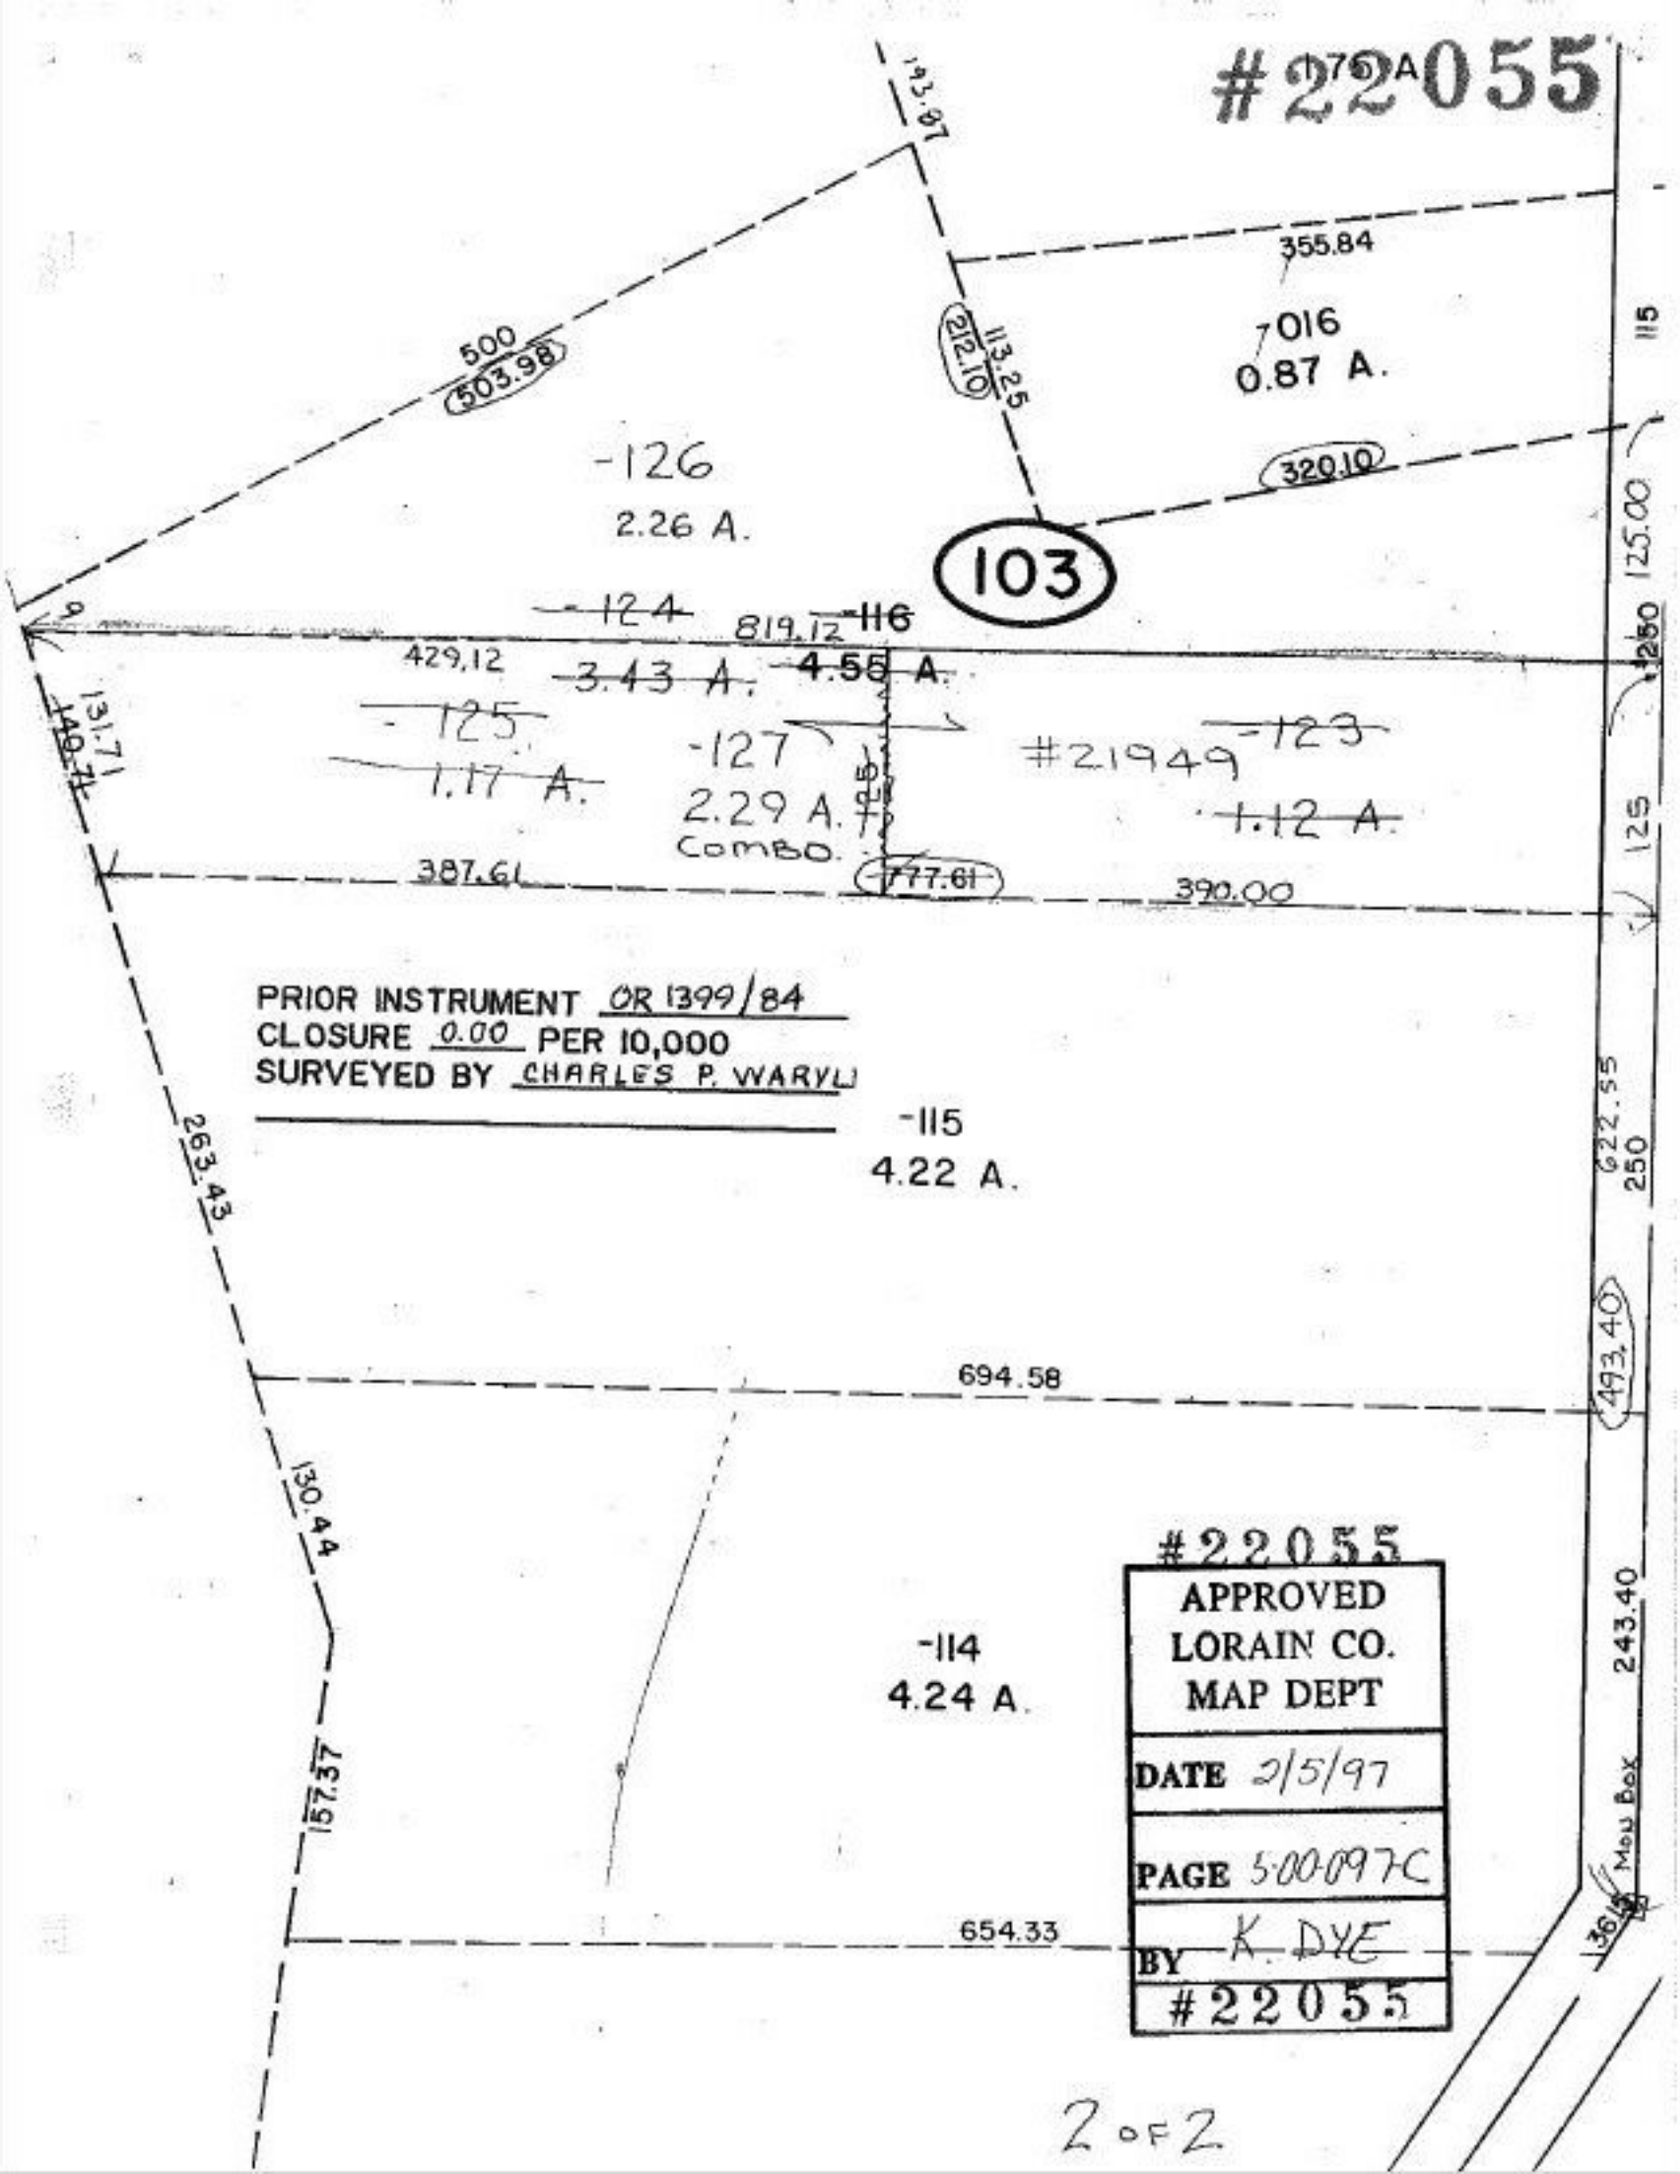
193.97
355.84
016
0.87 A.
500
503.98
113.25
212.10
115
-126
2.26 A.
320.10
125.00
103
-124
819.12
-116
429.12
3.43 A.
4.56 A.
250
131.71
148.71
-125
1.17 A.
-127
2.29 A.
COMBO.
#21949
-123
1.12 A.
387.61
777.61
390.00
125
PRIOR INSTRUMENT OR 1399/84
CLOSURE 0.00 PER 10,000
SURVEYED BY CHARLES P. WARYU
-115
4.22 A.
263.43
622.55
250
493.40
694.58
130.44
-114
4.24 A.
157.37
654.33
243.40
Mail Box
APPROVED
LORAIN CO.
MAP DEPT
DATE 2/5/97
PAGE 5-00-097C
BY K. DYE
#22055