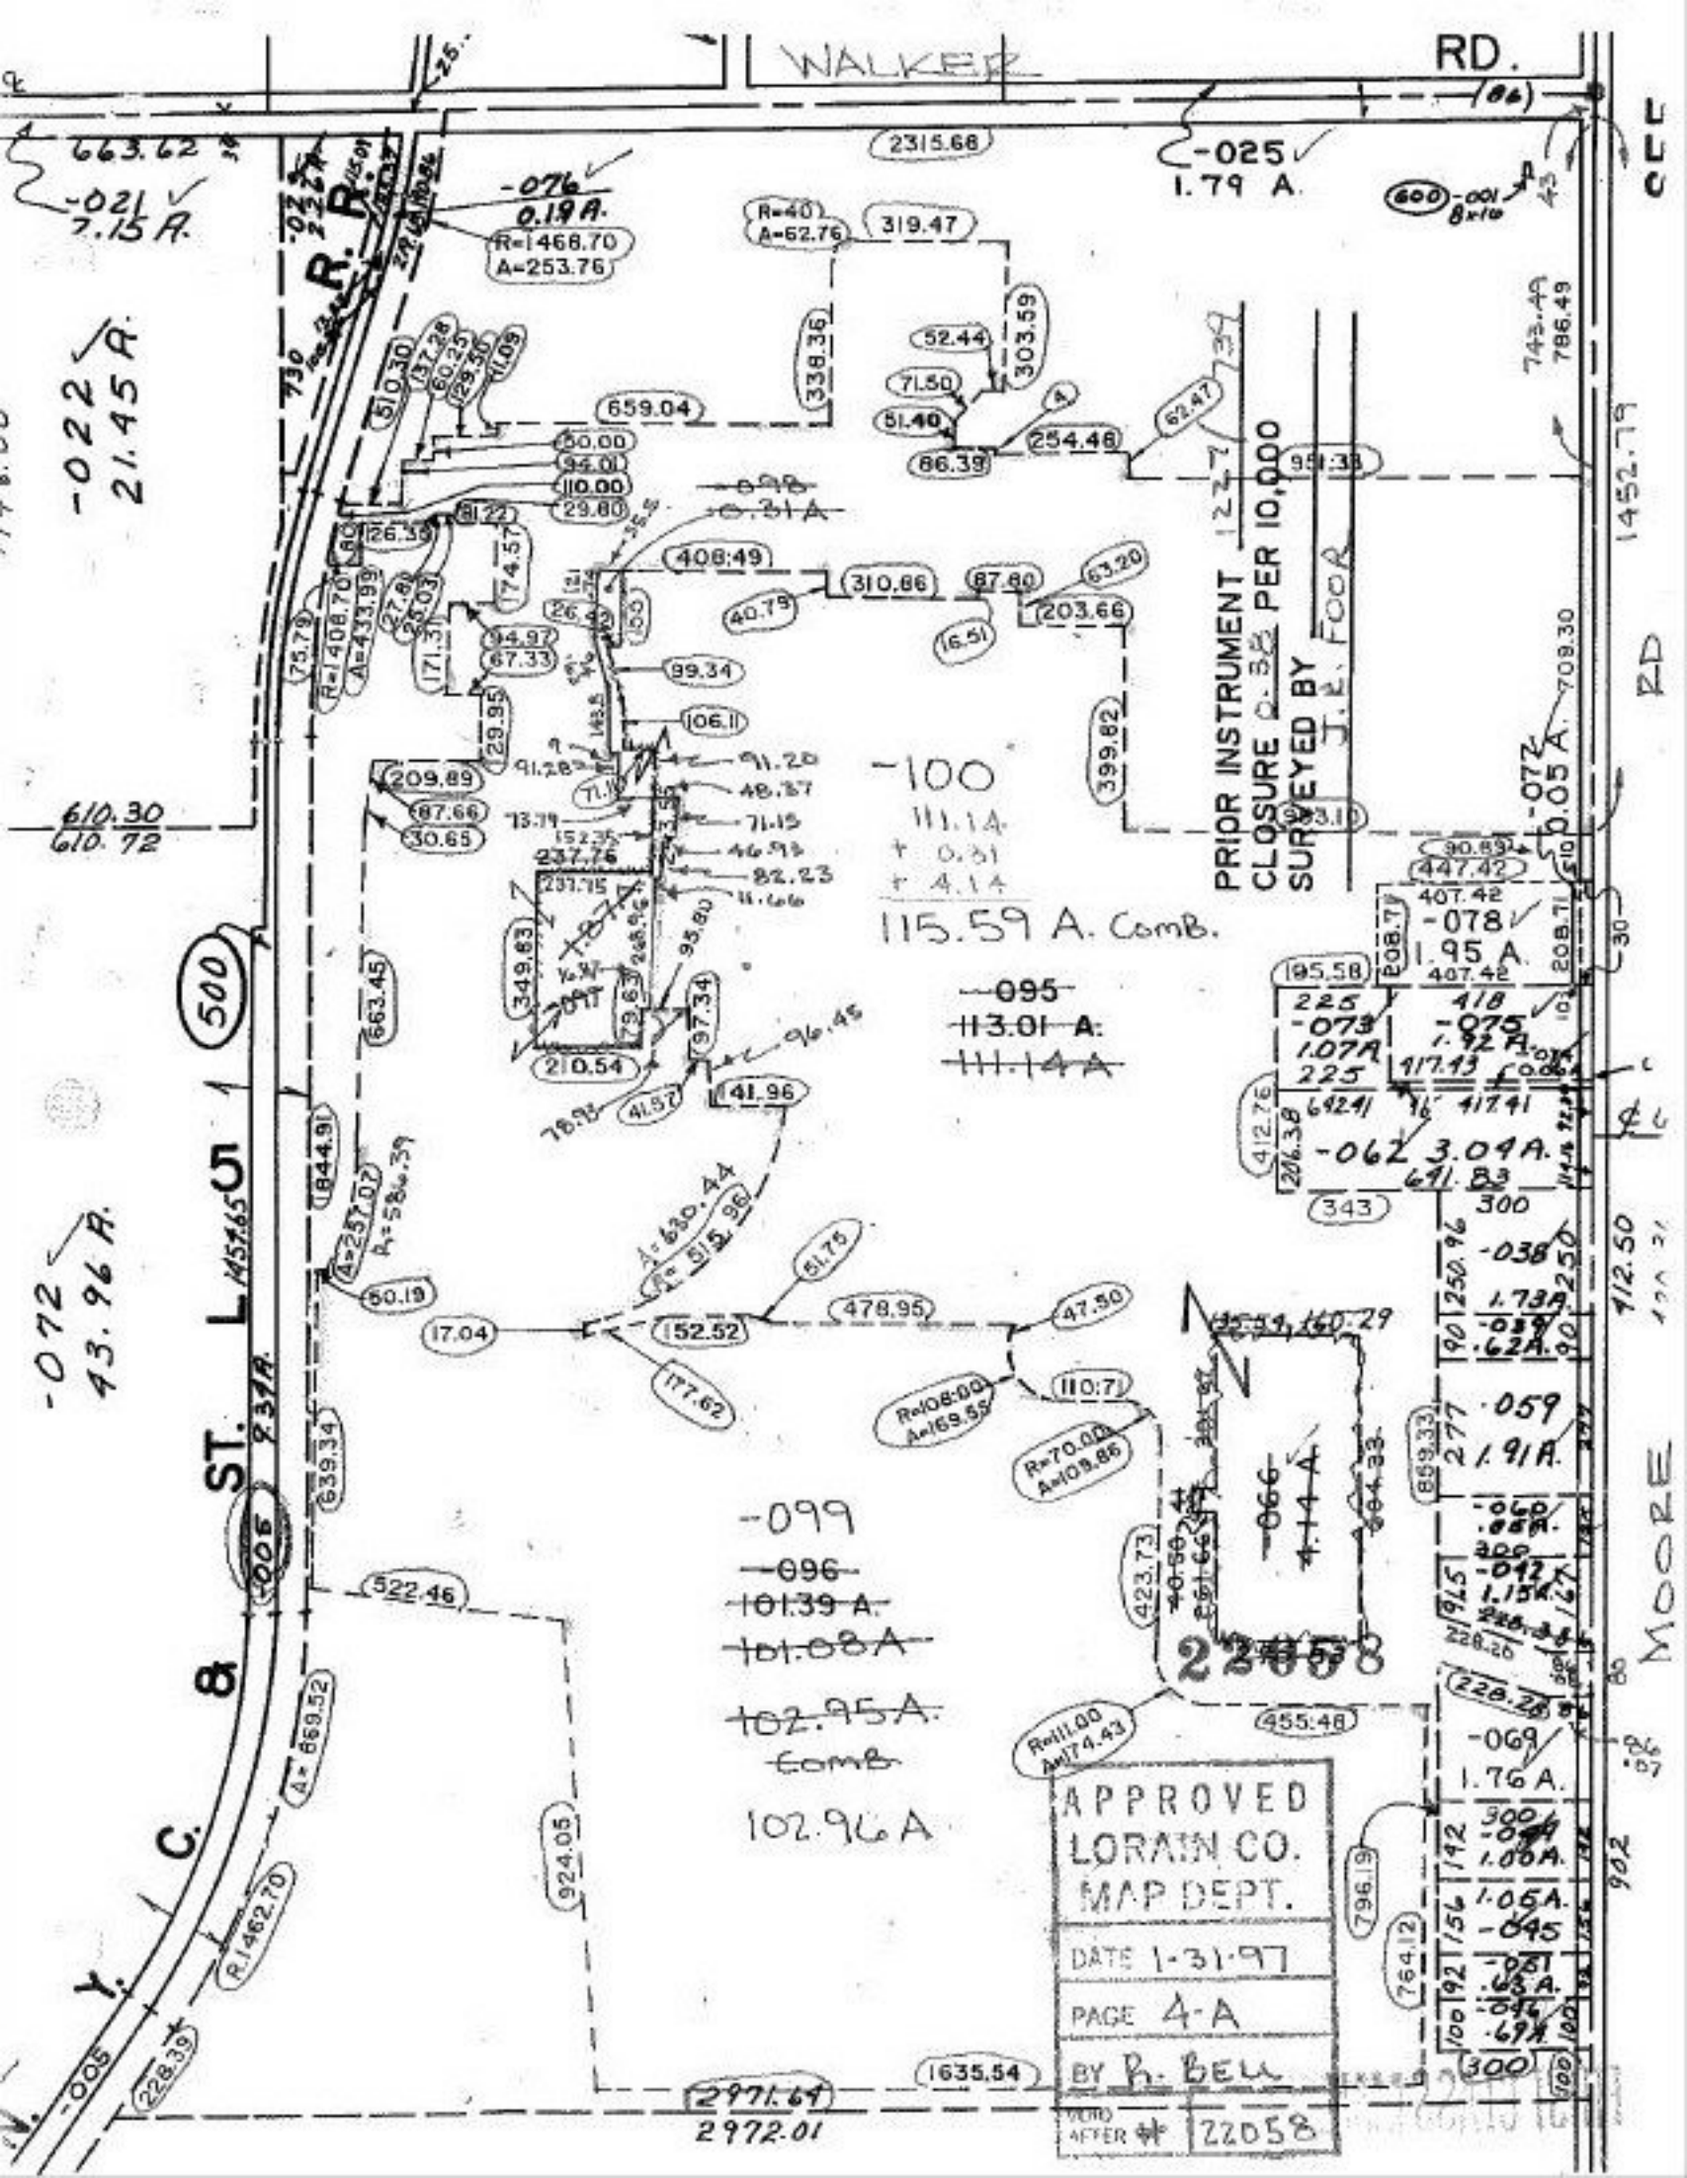
WALKER RD.
R. R.
-025
1.79 A.
-076
0.19 A.
R=1468.70
A=253.76
-021
7.15 A.
-022
21.45 A.
-072
43.96 A.
-078
.95 A.
-062
3.04 A.
-100
111.1 A
+ 0.31
+ 4.14
115.59 A. Comb.
-095
113.01 A.
111.14 A
-099
-096
101.39 A.
101.08 A
102.95 A.
Comb
102.96 A
PRIOR INSTRUMENT
CLOSURE D-32 PER 10,000
SURVEYED BY J.E. FOOR
APPROVED
LORAIN CO.
MAP DEPT.
DATE 1-31-97
PAGE 4-A
BY R. BELL
RETURN AFTER #
22058
MOORE RD
663.62
2315.66
319.47
659.04
1452.79
743.49
786.49
1277
951.38
709.30
447.42
407.42
917.13
412.76
691.83
343
300
250
712.50
844.91
663.45
639.34
522.46
924.05
869.52
1462.70
228.39
2971.64
2972.01
1635.54
796.19
764.12
902
610.30
610.72
-059
1.91 A.
-069
1.76 A.
-038
1.73 A.
-039
.62 A.
-045
1.05 A.
-063
.63 A.
-067
.69 A.
-012
1.15 A.
-005
-006
