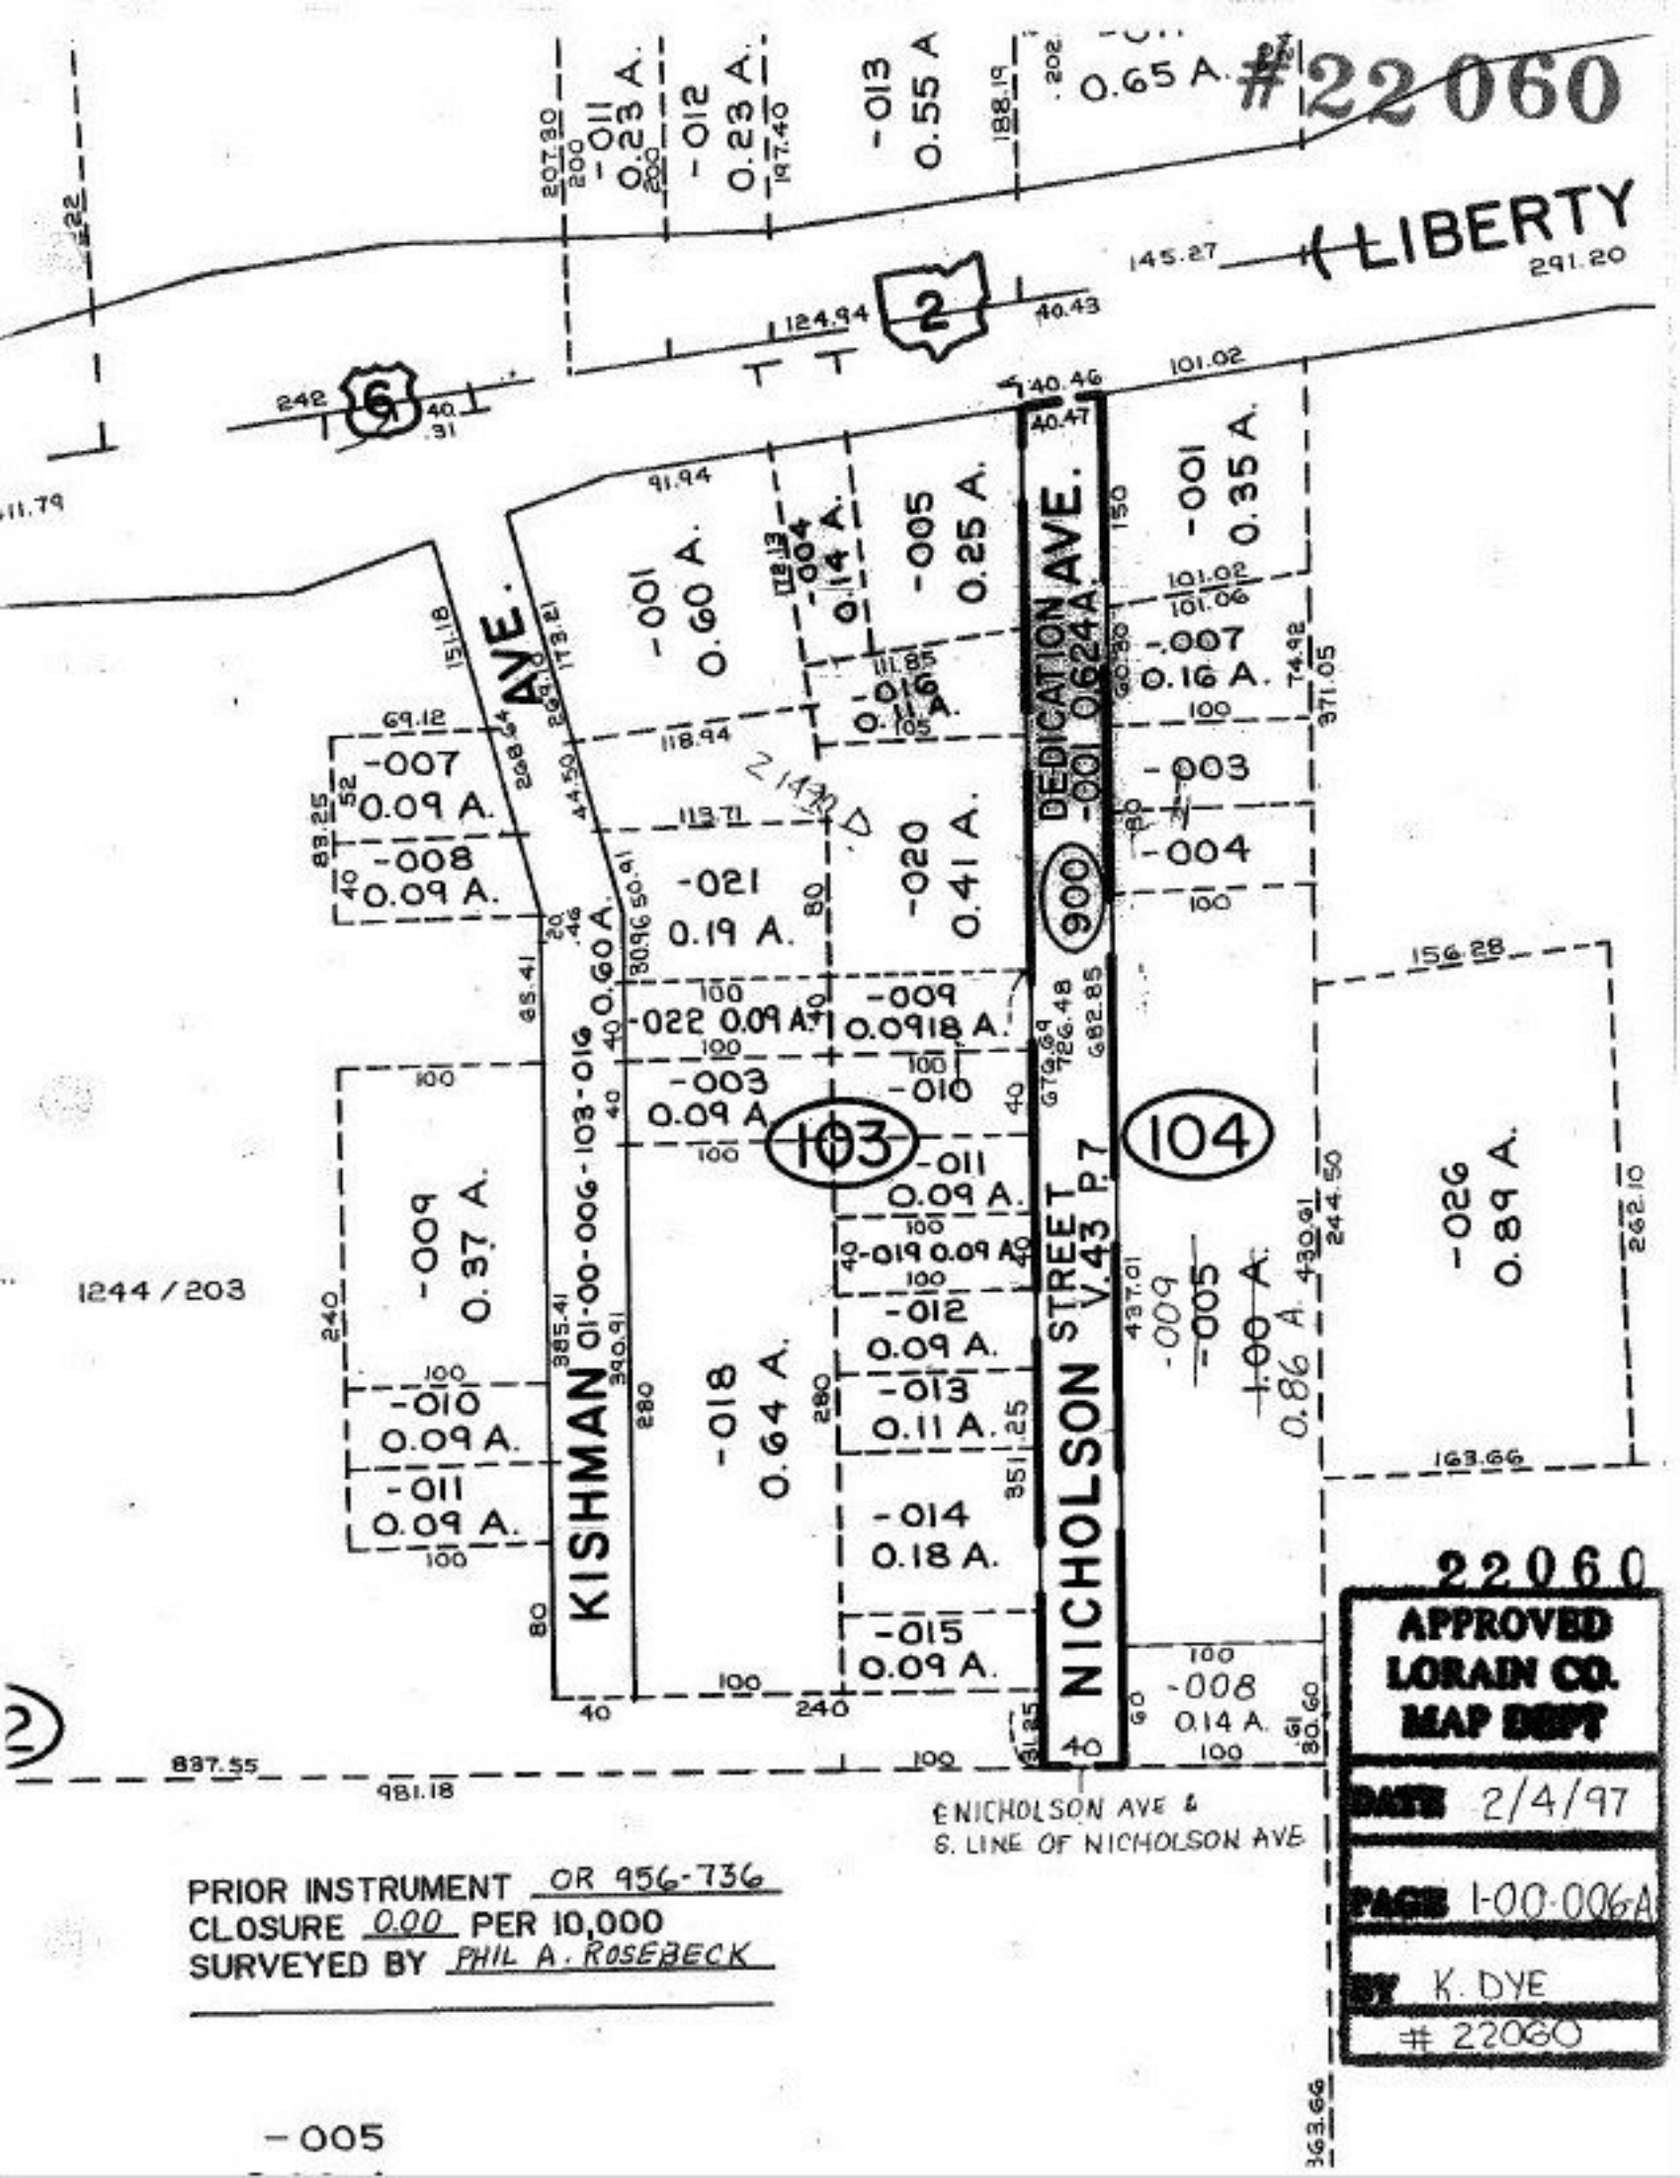

PRIOR INSTRUMENT OR 956-736
CLOSURE 0.00 PER 10,000
SURVEYED BY PHIL A. ROSEBECK

-005