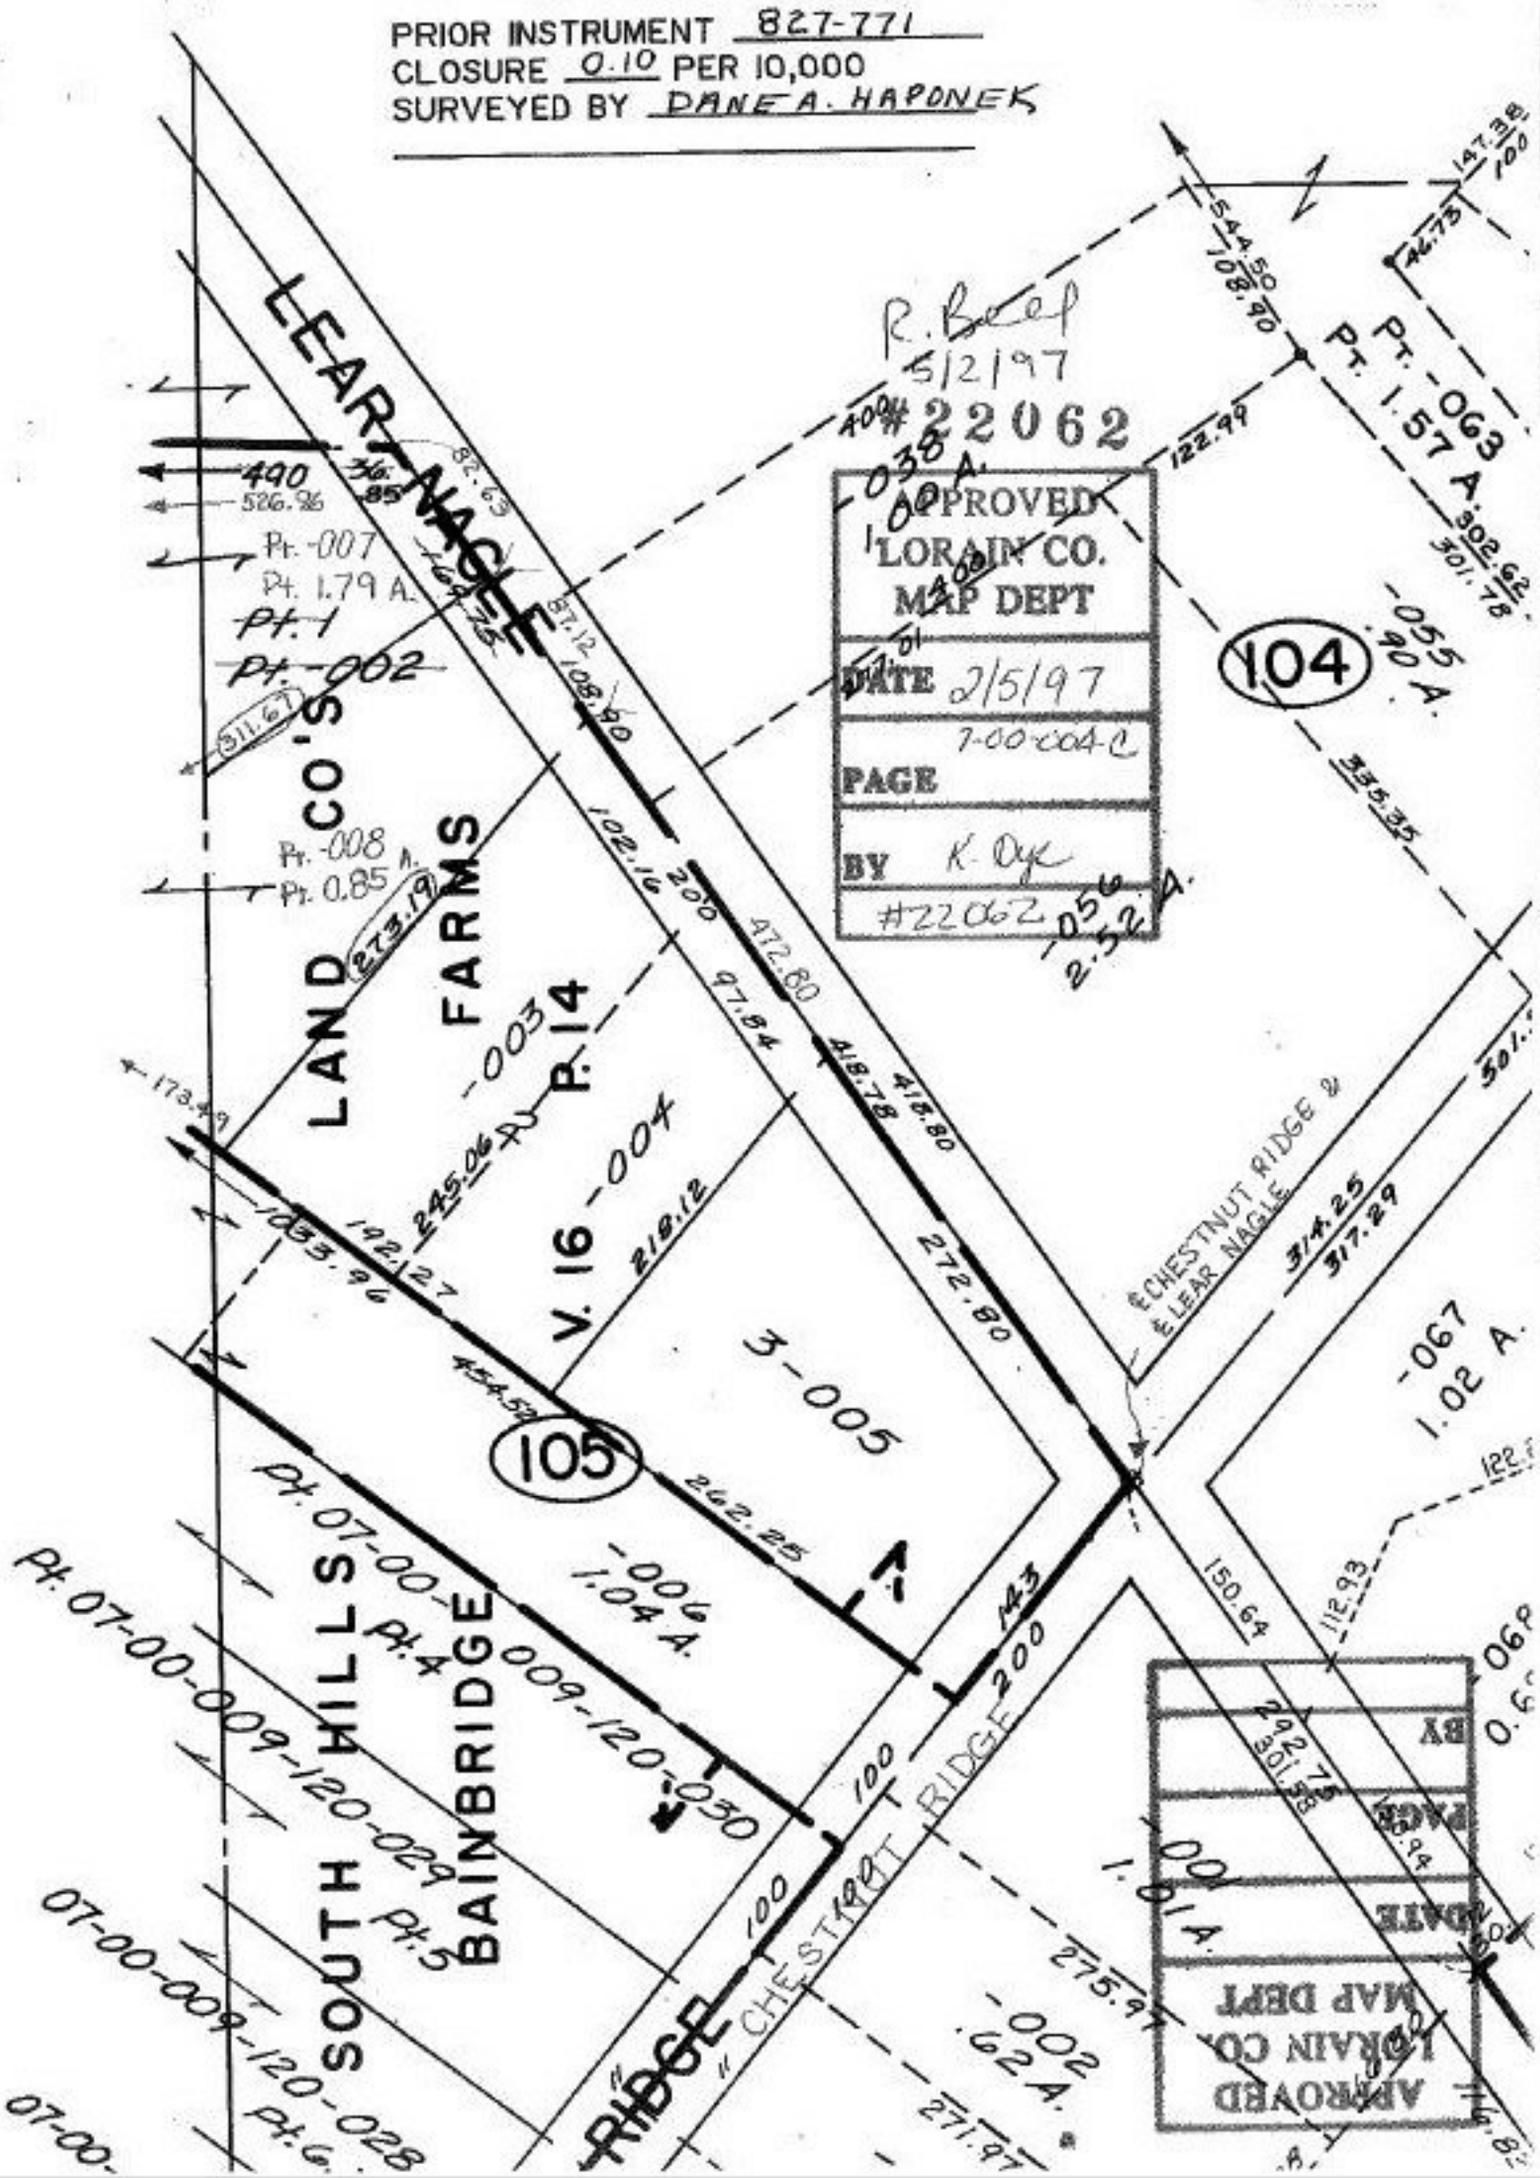PRIOR INSTRUMENT 827-771
CLOSURE 0.10 PER 10,000
SURVEYED BY DANE A. HAPONEK