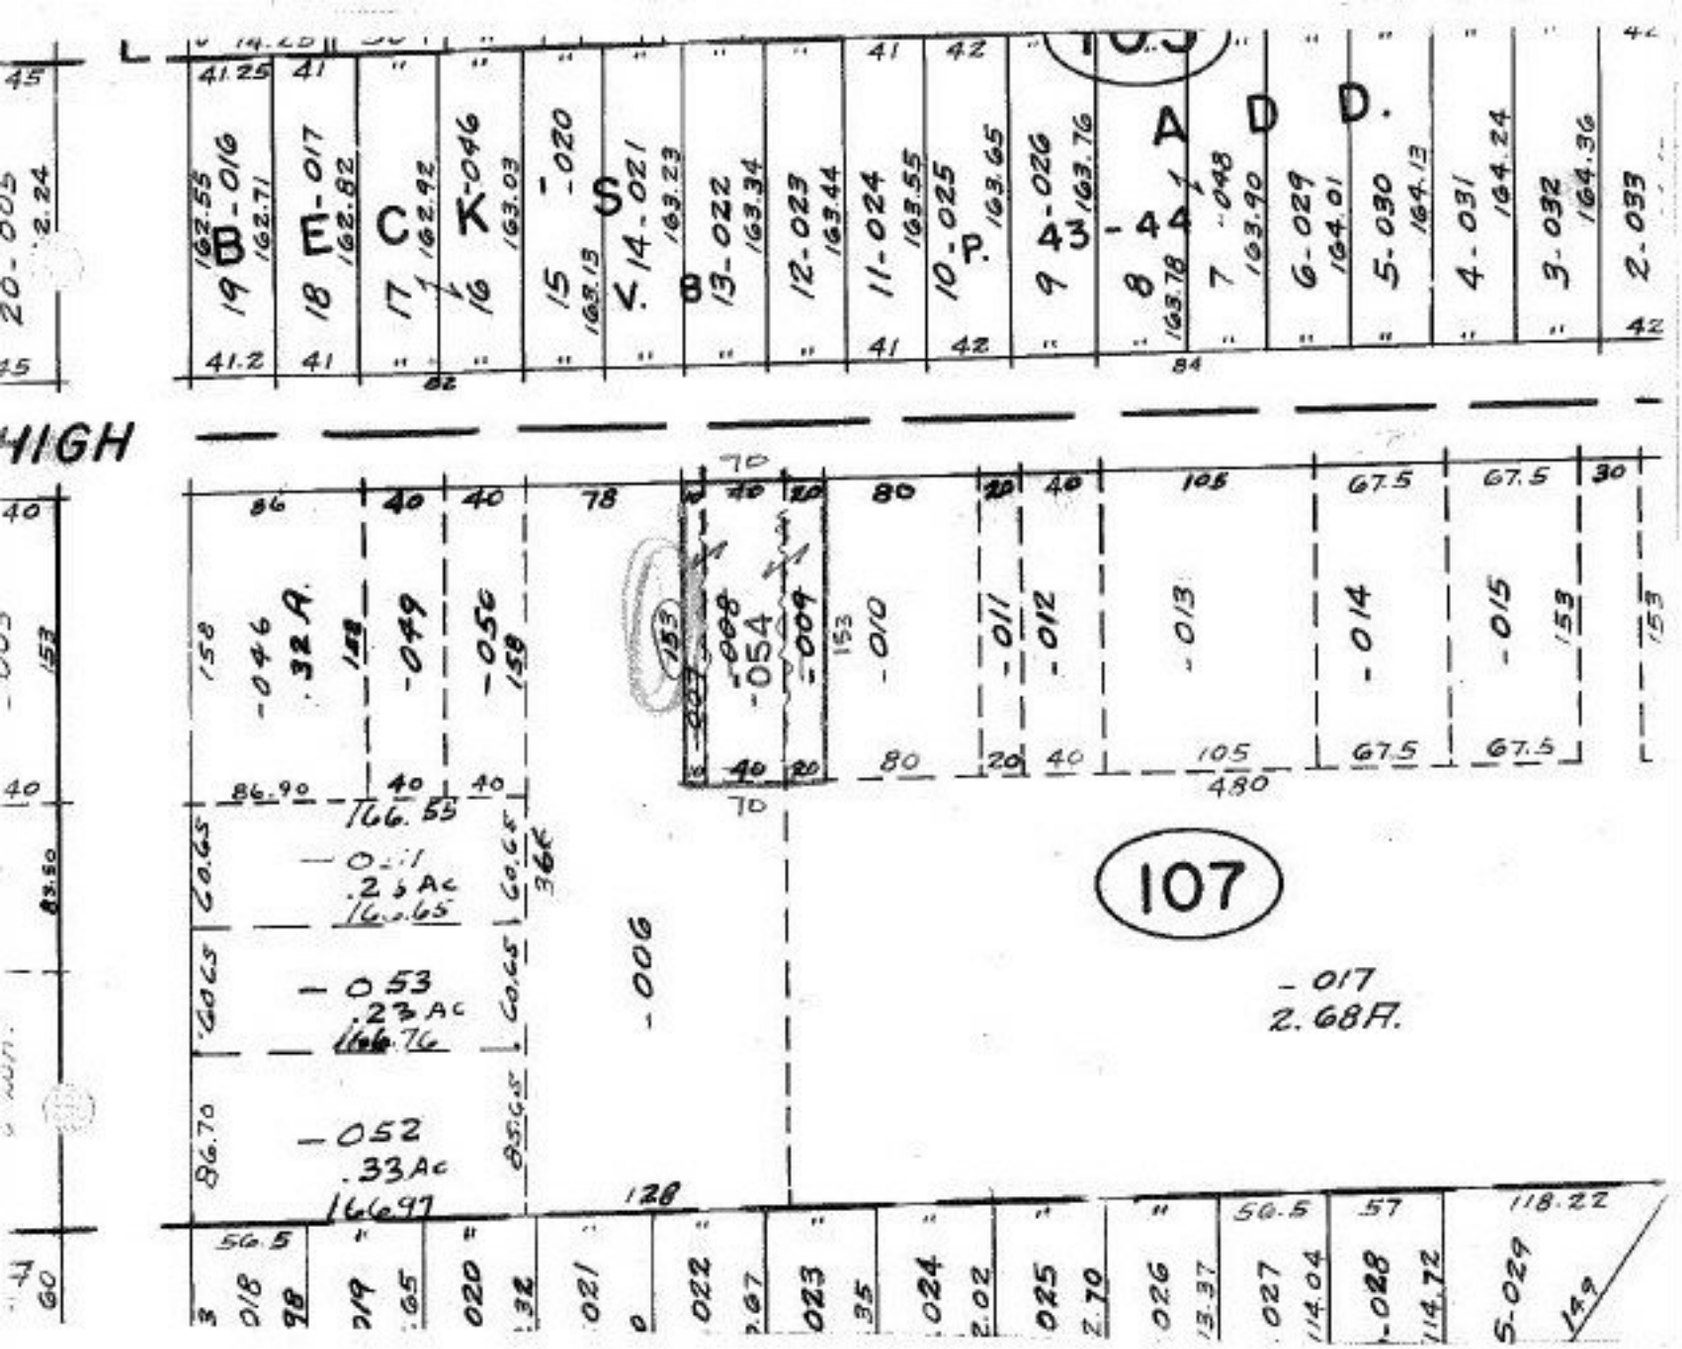

EFFECTIVE 5/12/97

pp 9-24-98

#22069-C

APPROVED
LORAIN CO.
MAP DEPT.

DATE 2-19-97

PAGE 6-79

BYT. McNAIR/P. BELL

VOID AFTER # 22069-C