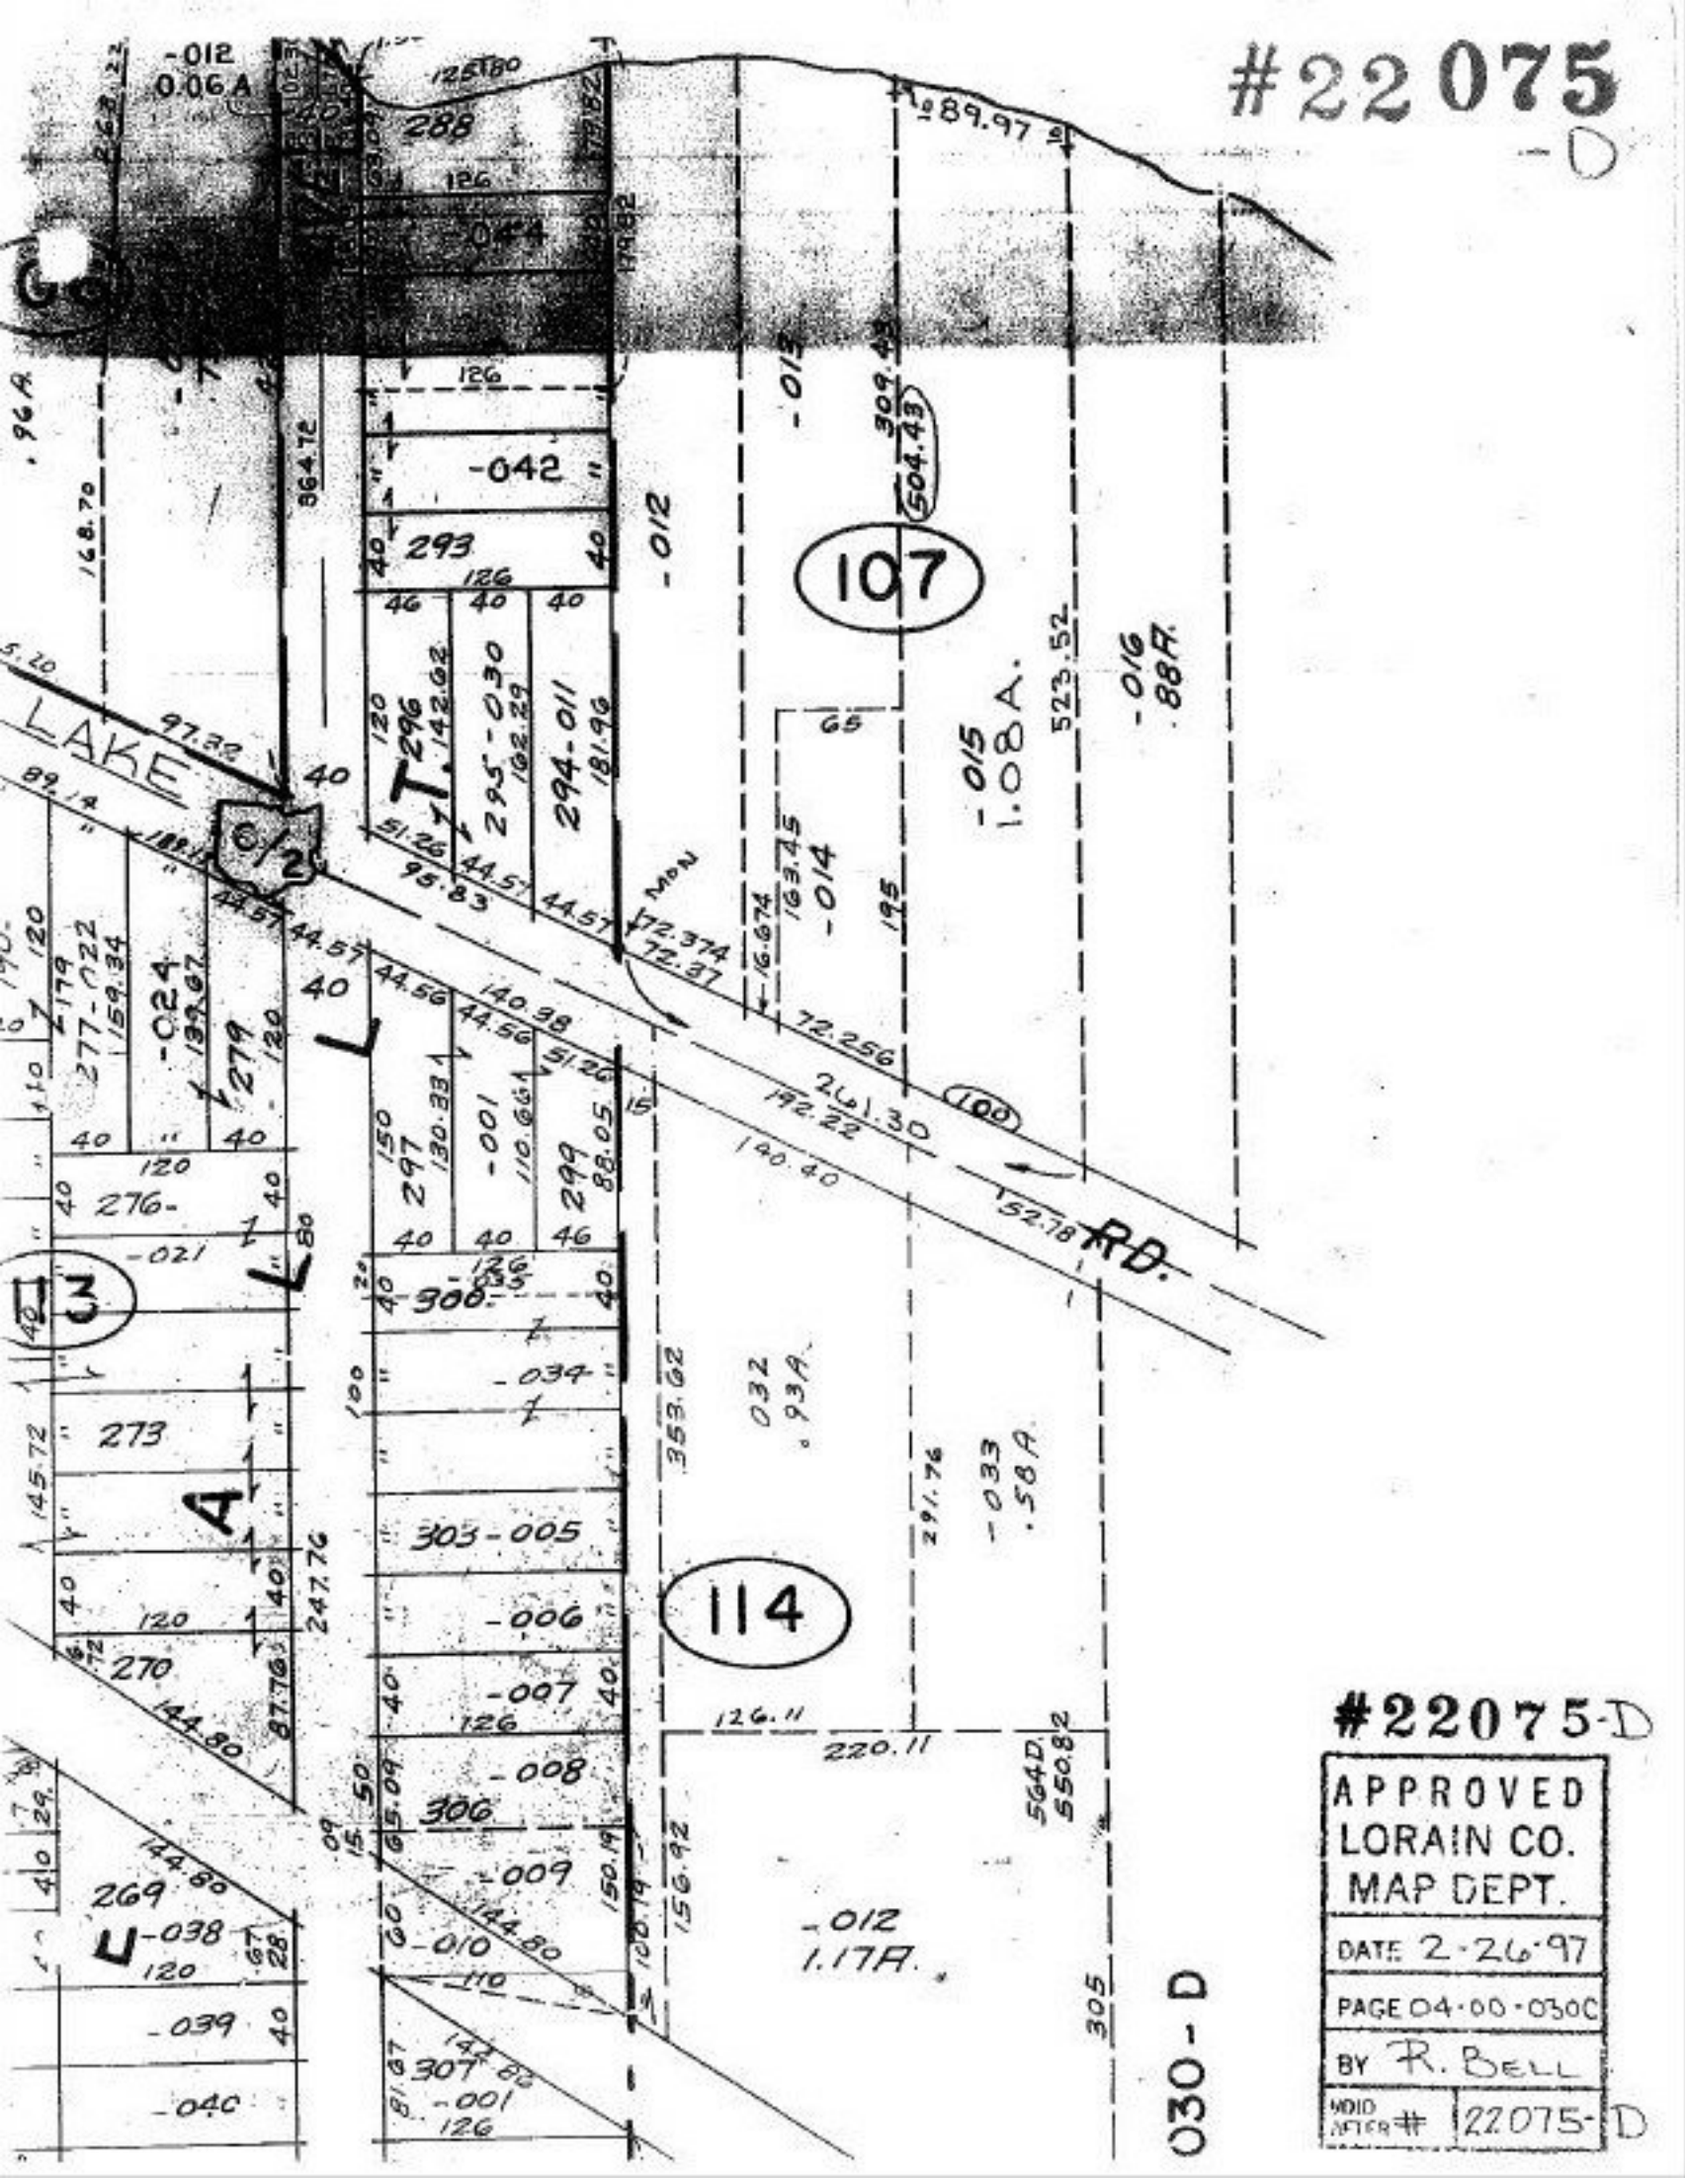
#22075
-D
-012
0.06 A
288
126
-044
89.97
-013
309.43
504.43
-042
293
-012
107
-016
.88A.
523.52
-015
1.08A.
LAKE
97.32
296
142.02
295-030
102.29
294-011
181.96
-014
163.45
72.374
72.37
72.256
241.30
192.22
140.40
140.98
RD.
152.78
-024
277-022
159.34
279
276-
-021
3
L
A
K
E
297
130.33
-001
110.66
299
88.05
300
-034
273
303-005
-006
-007
270
144.80
247.76
87.76
306
-008
-009
-010
269
-038
-039
-040
307
-001
114
032
.93A.
353.62
-033
.58A.
291.76
126.11
220.11
564D.
550.82
-012
1.17A.
305
030-D
#22075-D
APPROVED
LORAIN CO.
MAP DEPT.
DATE 2-26-97
PAGE 04-00-030C
BY R. BELL
VOID AFTER # 22075-D