SEE 18-00-022-D

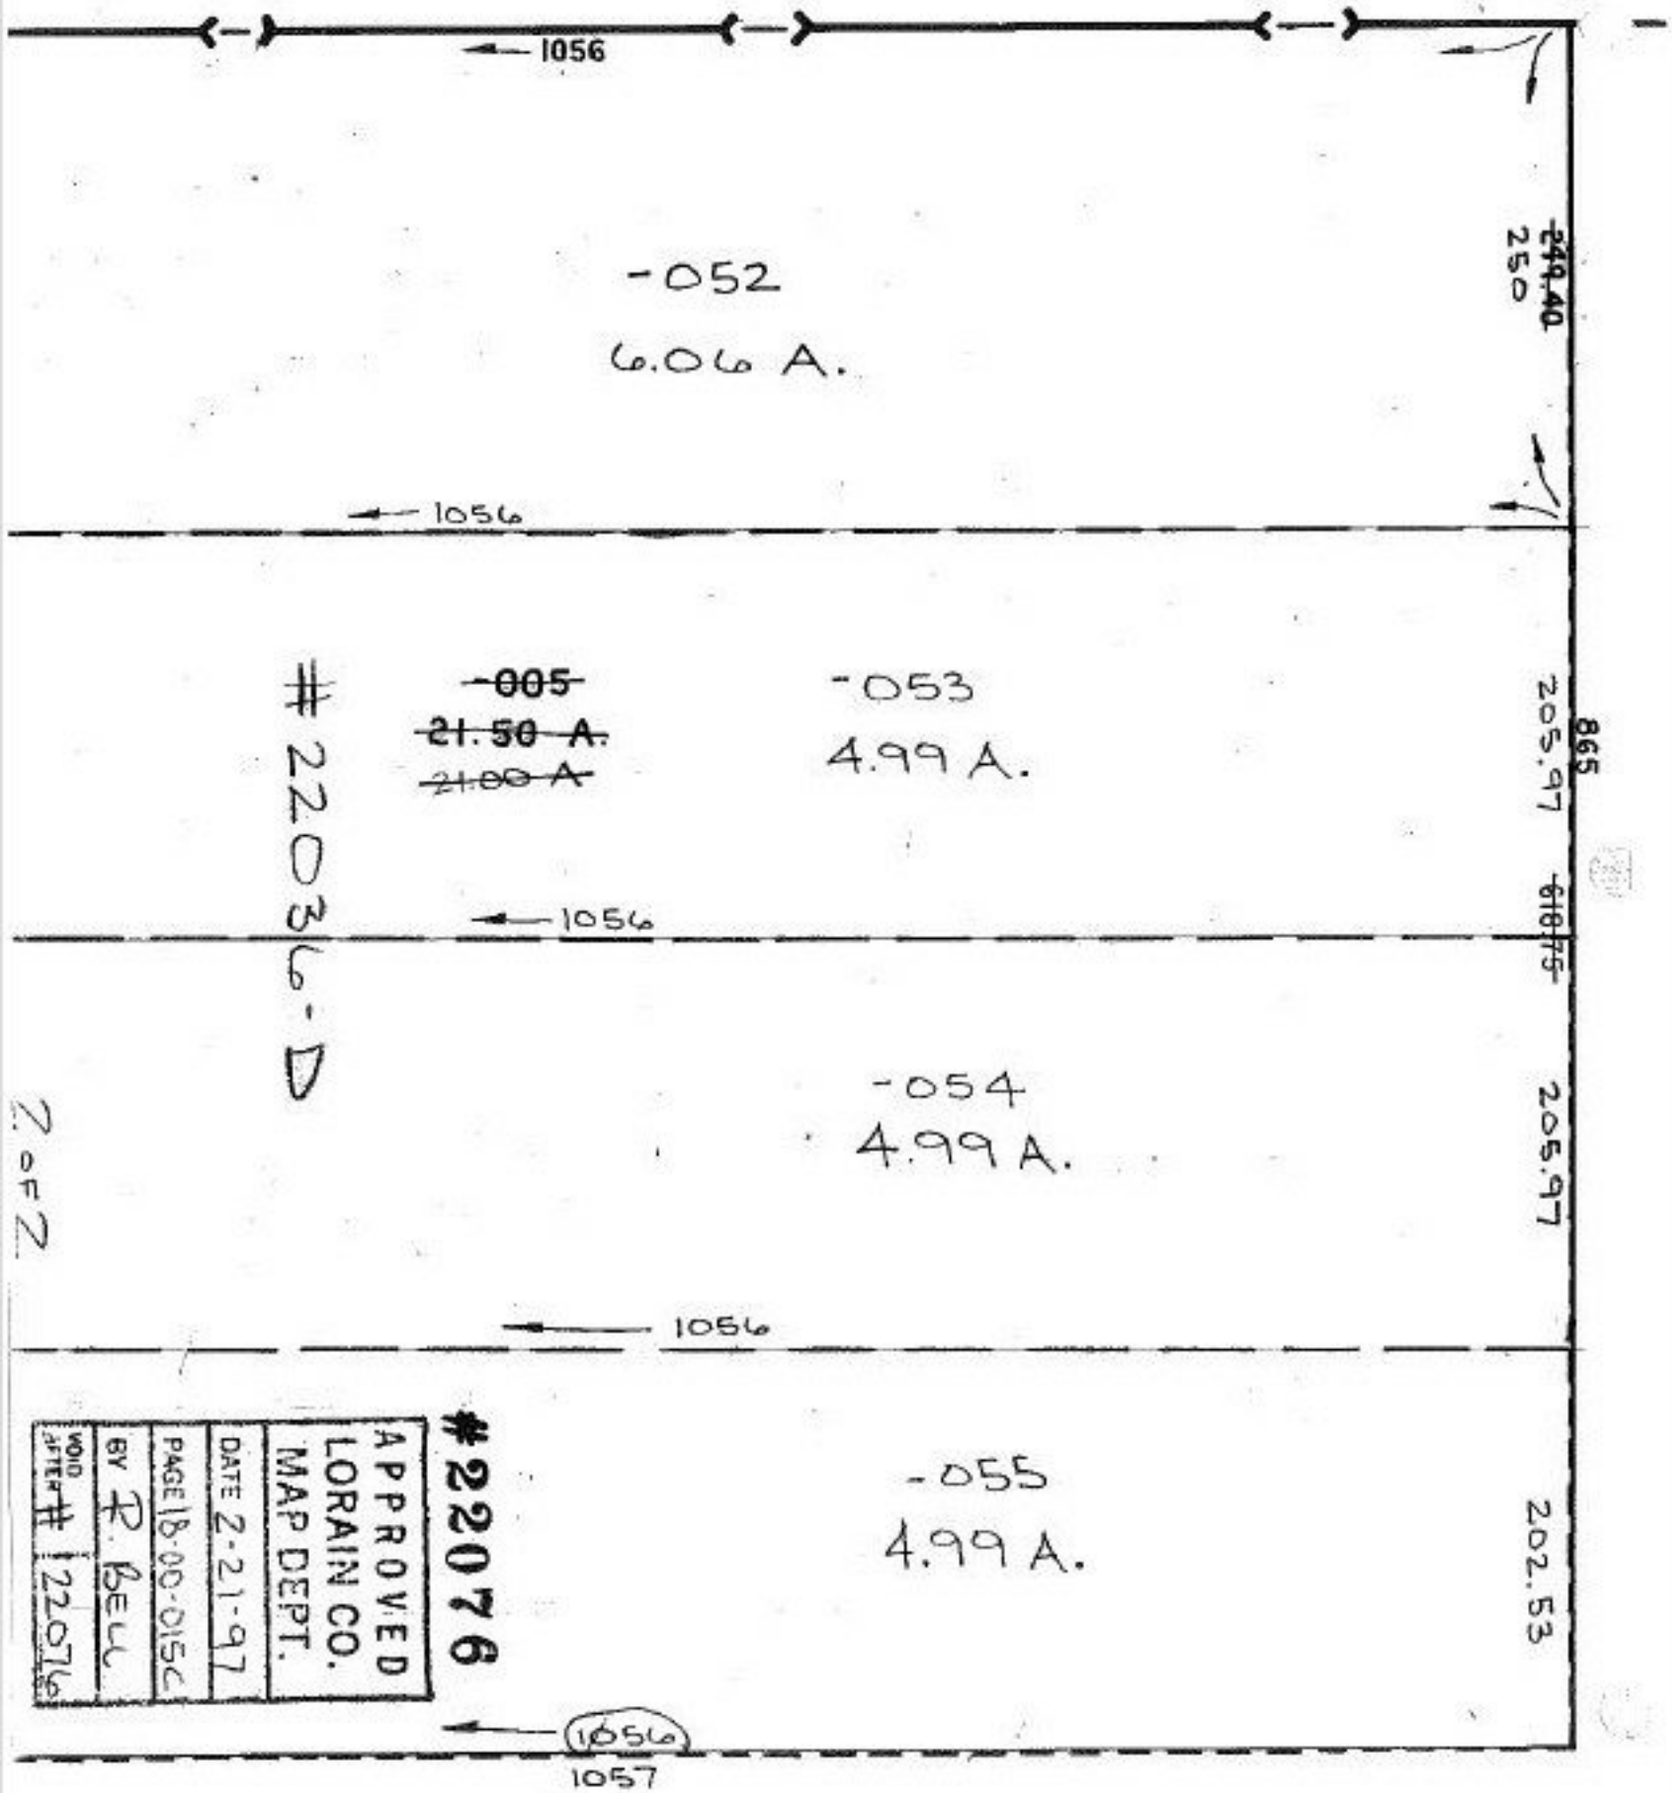

#22076

Z