#22078 D

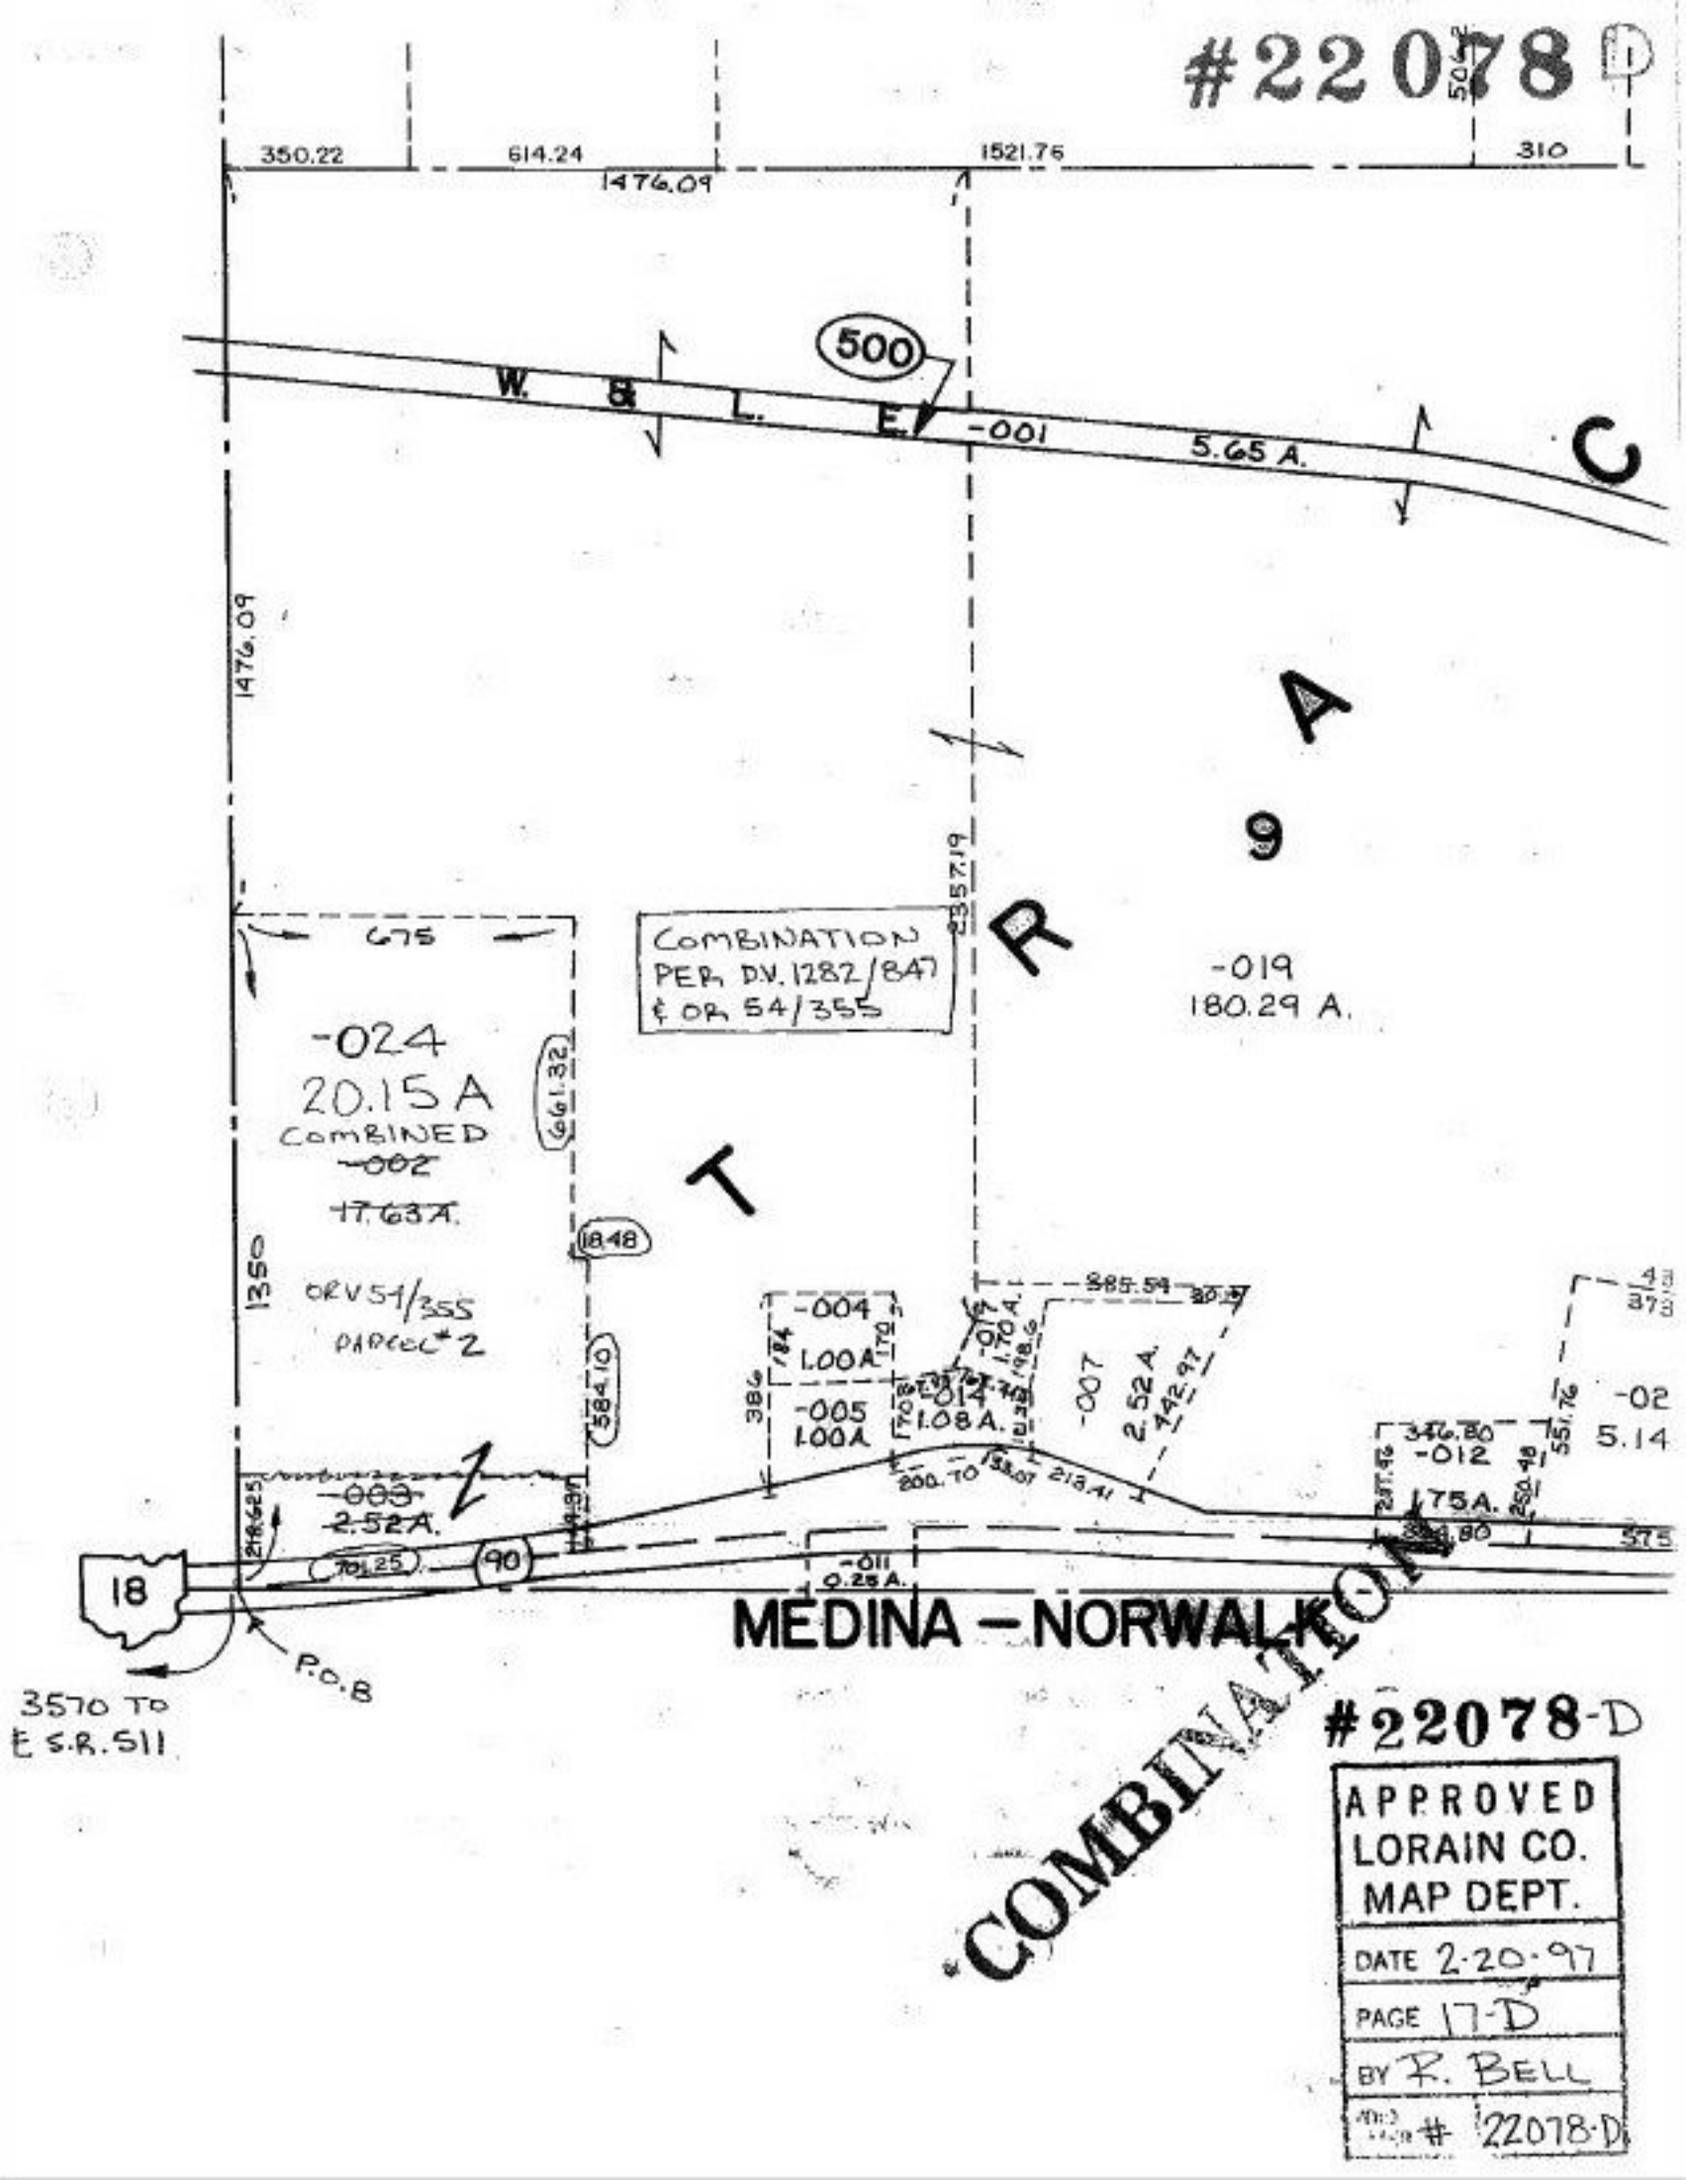

#22078-D

APPROVED
LORAIN CO.
MAP DEPT.
DATE 2-20-97
PAGE 17-D
BY R. BELL
ADD'L # 22078-D