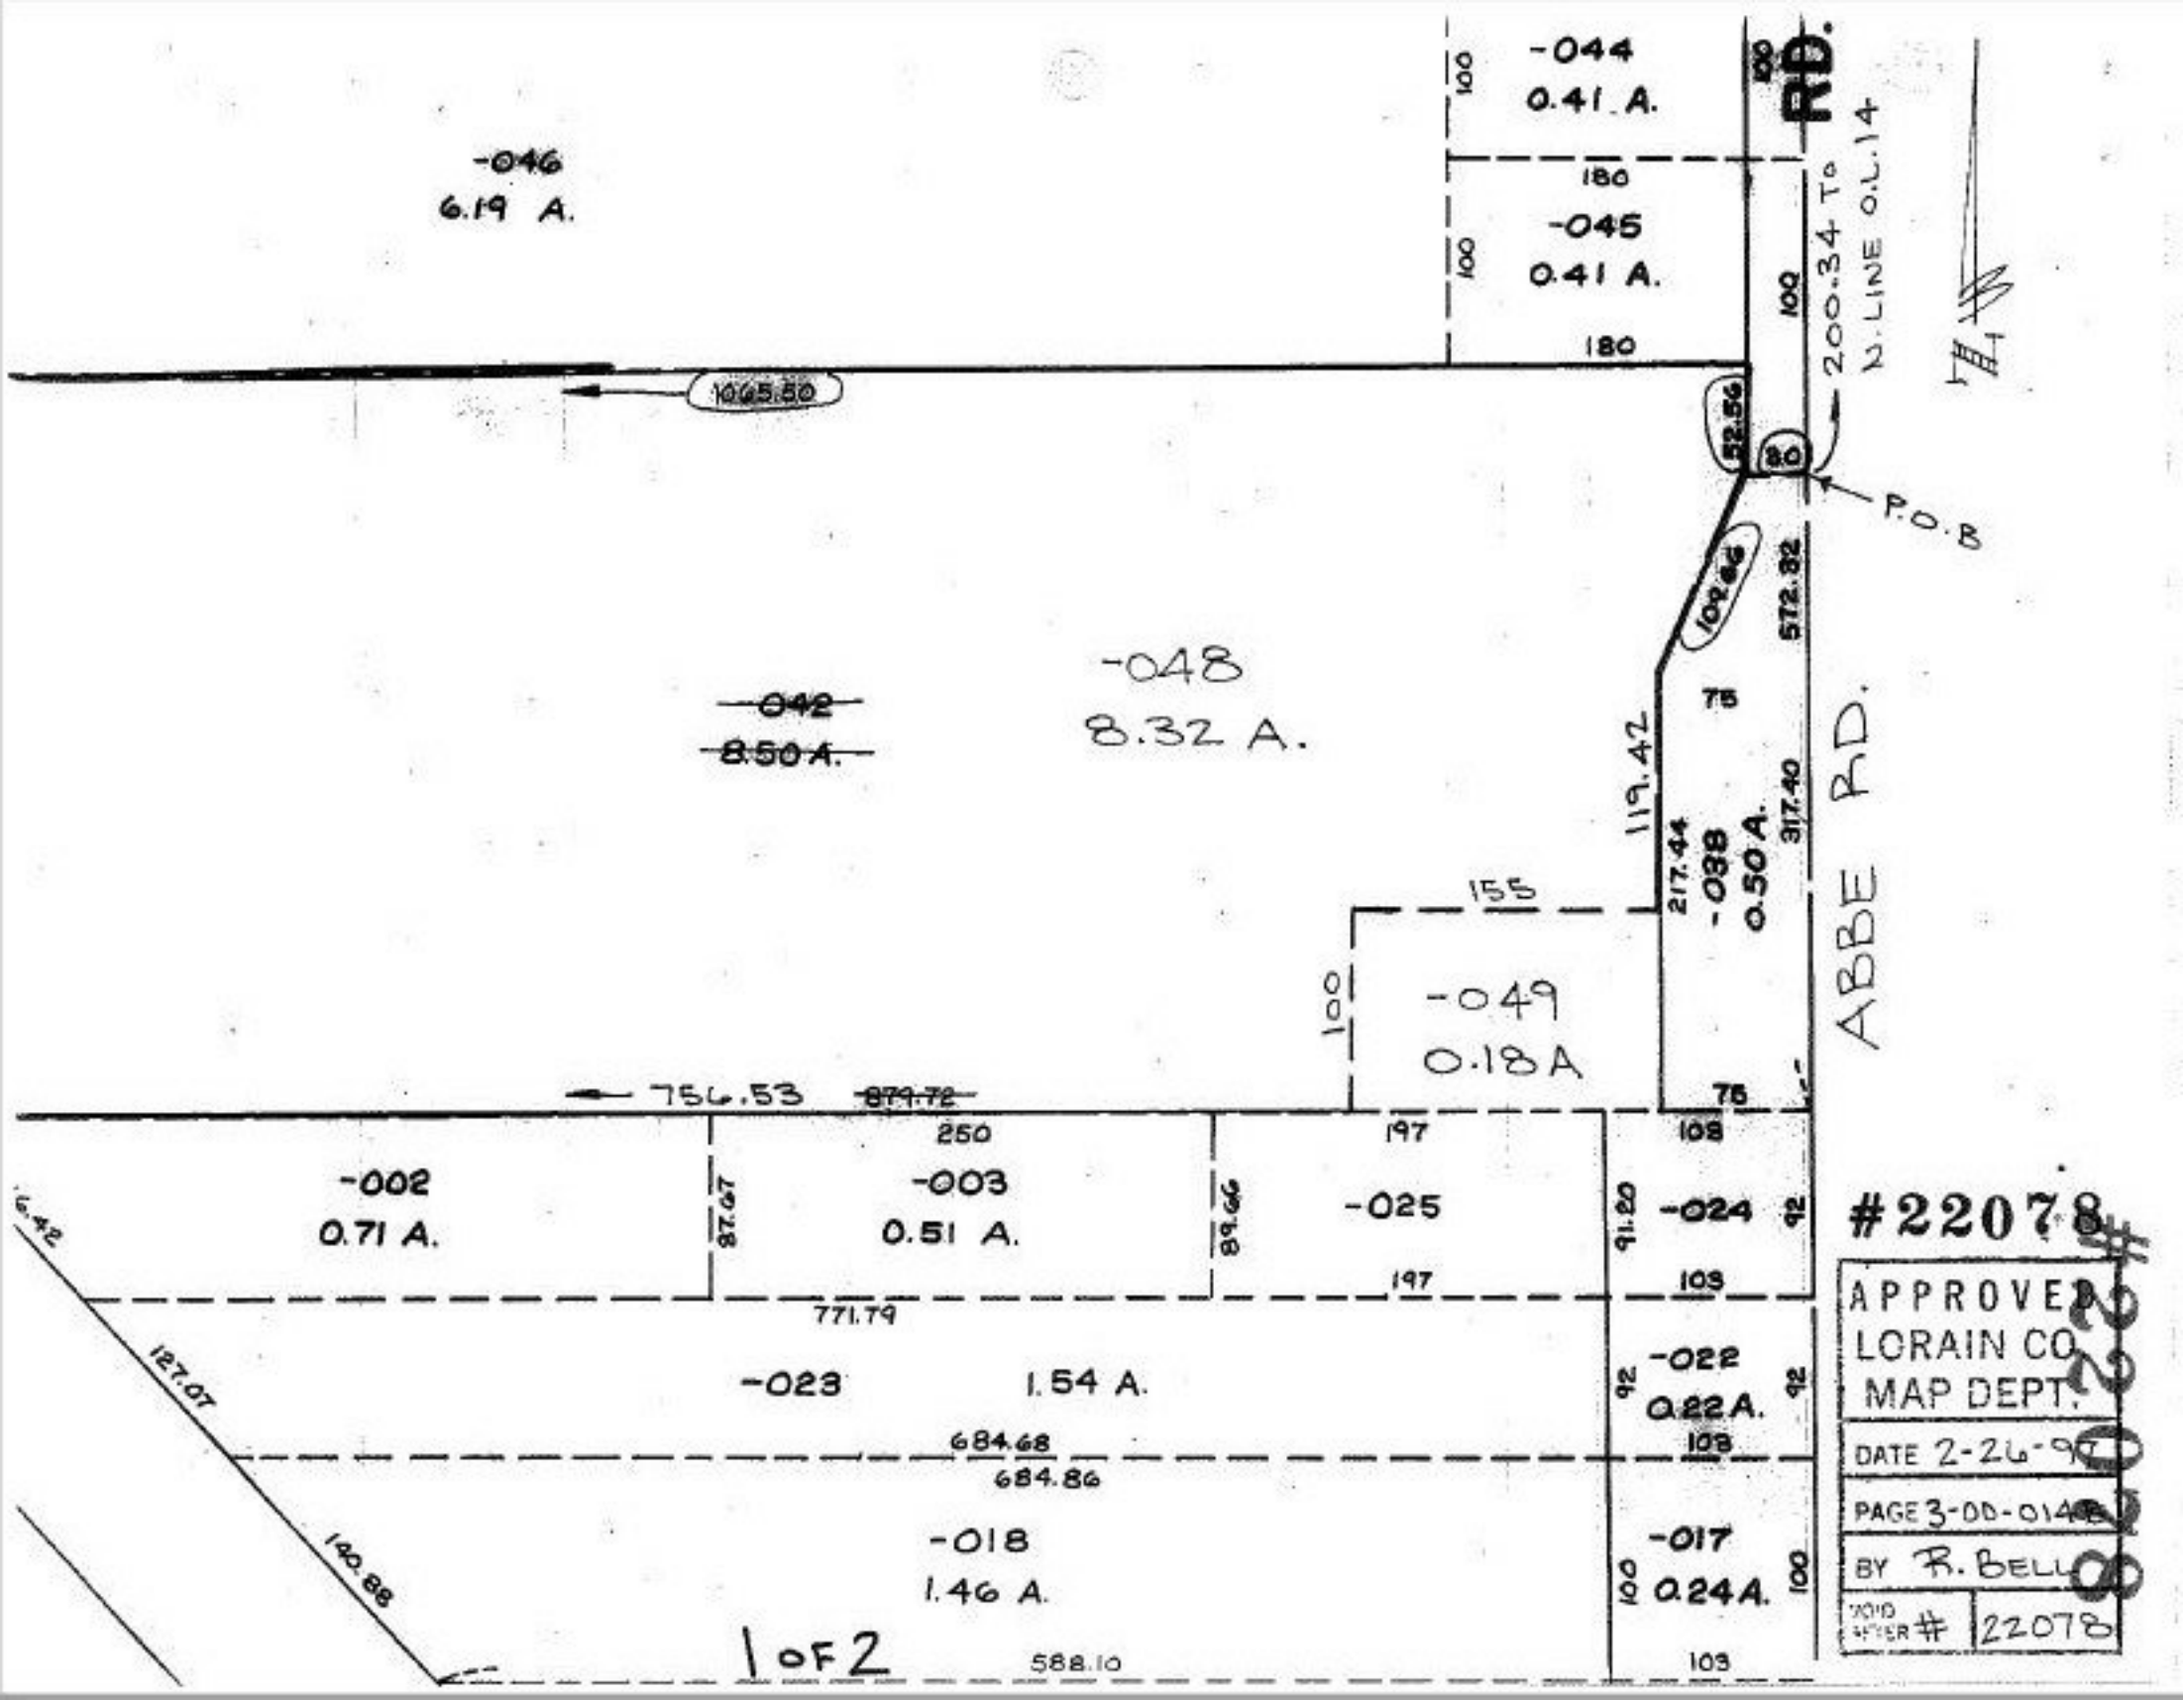
-044
0.41 A.
-046
6.19 A.
-045
0.41 A.
RD.
200.34 To
N. LINE O.L. 14
1065.50
52.56
80
P.O.B
-048
8.32 A.
-042
8.50 A.
572.82
102.66
119.42
-038
0.50 A.
317.40
217.44
ABBE RD.
-049
0.18 A
756.53
879.72
-002
0.71 A.
-003
0.51 A.
-025
-024
-023
1.54 A.
-022
0.22 A.
771.79
684.68
684.86
-018
1.46 A.
-017
0.24 A.
127.07
140.88
588.10
1 OF 2
#22078
APPROVED
LORAIN CO.
MAP DEPT.
DATE 2-26-97
PAGE 3-00-0148
BY R. BELL
VOID AFTER #
22078