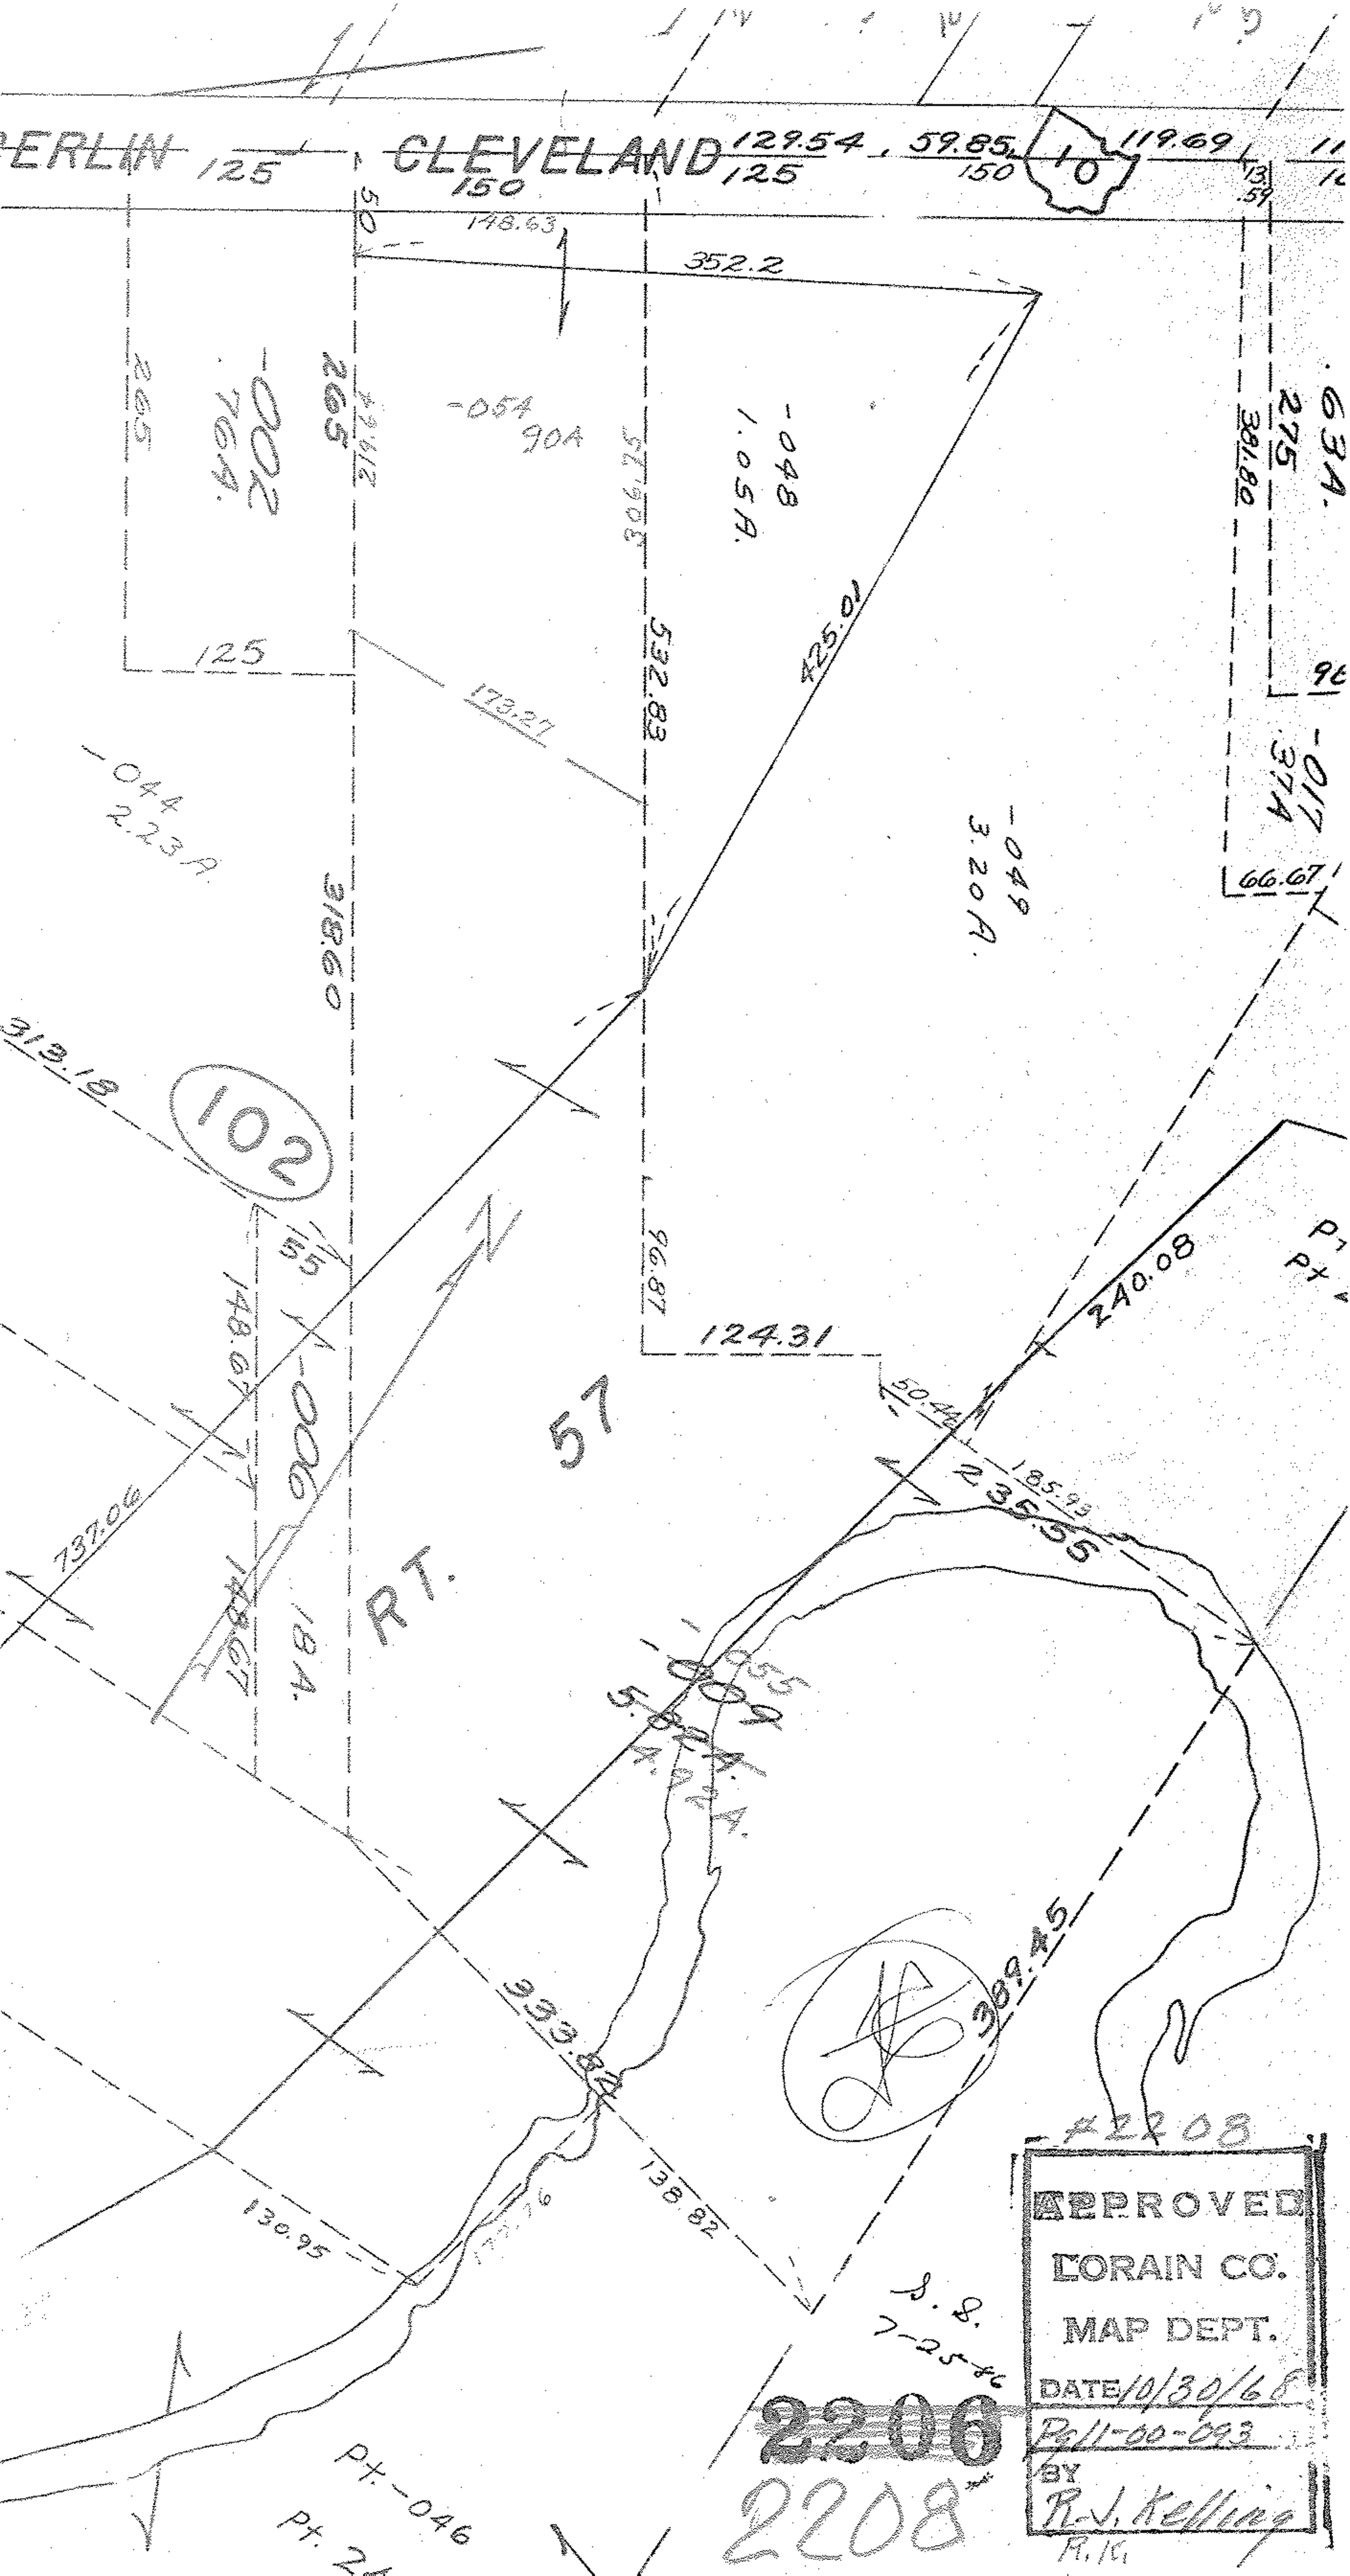
BERLIN
CLEVELAND
125
150
129.54
125
59.85
150
119.69
10
148.63
352.2
-054
90A
-044
2.23A
-048
1.05A
-049
3.20A
425.01
173.21
125
124.31
96.87
240.08
50.44
185.93
313.18
102
737.04
148.67
184.
RT.
57
138.82
130.95
389.45
#2208
APPROVED
LORAIN CO.
MAP DEPT.
DATE 10/30/68
By R.J. Kelling
2206
2208
R. 16