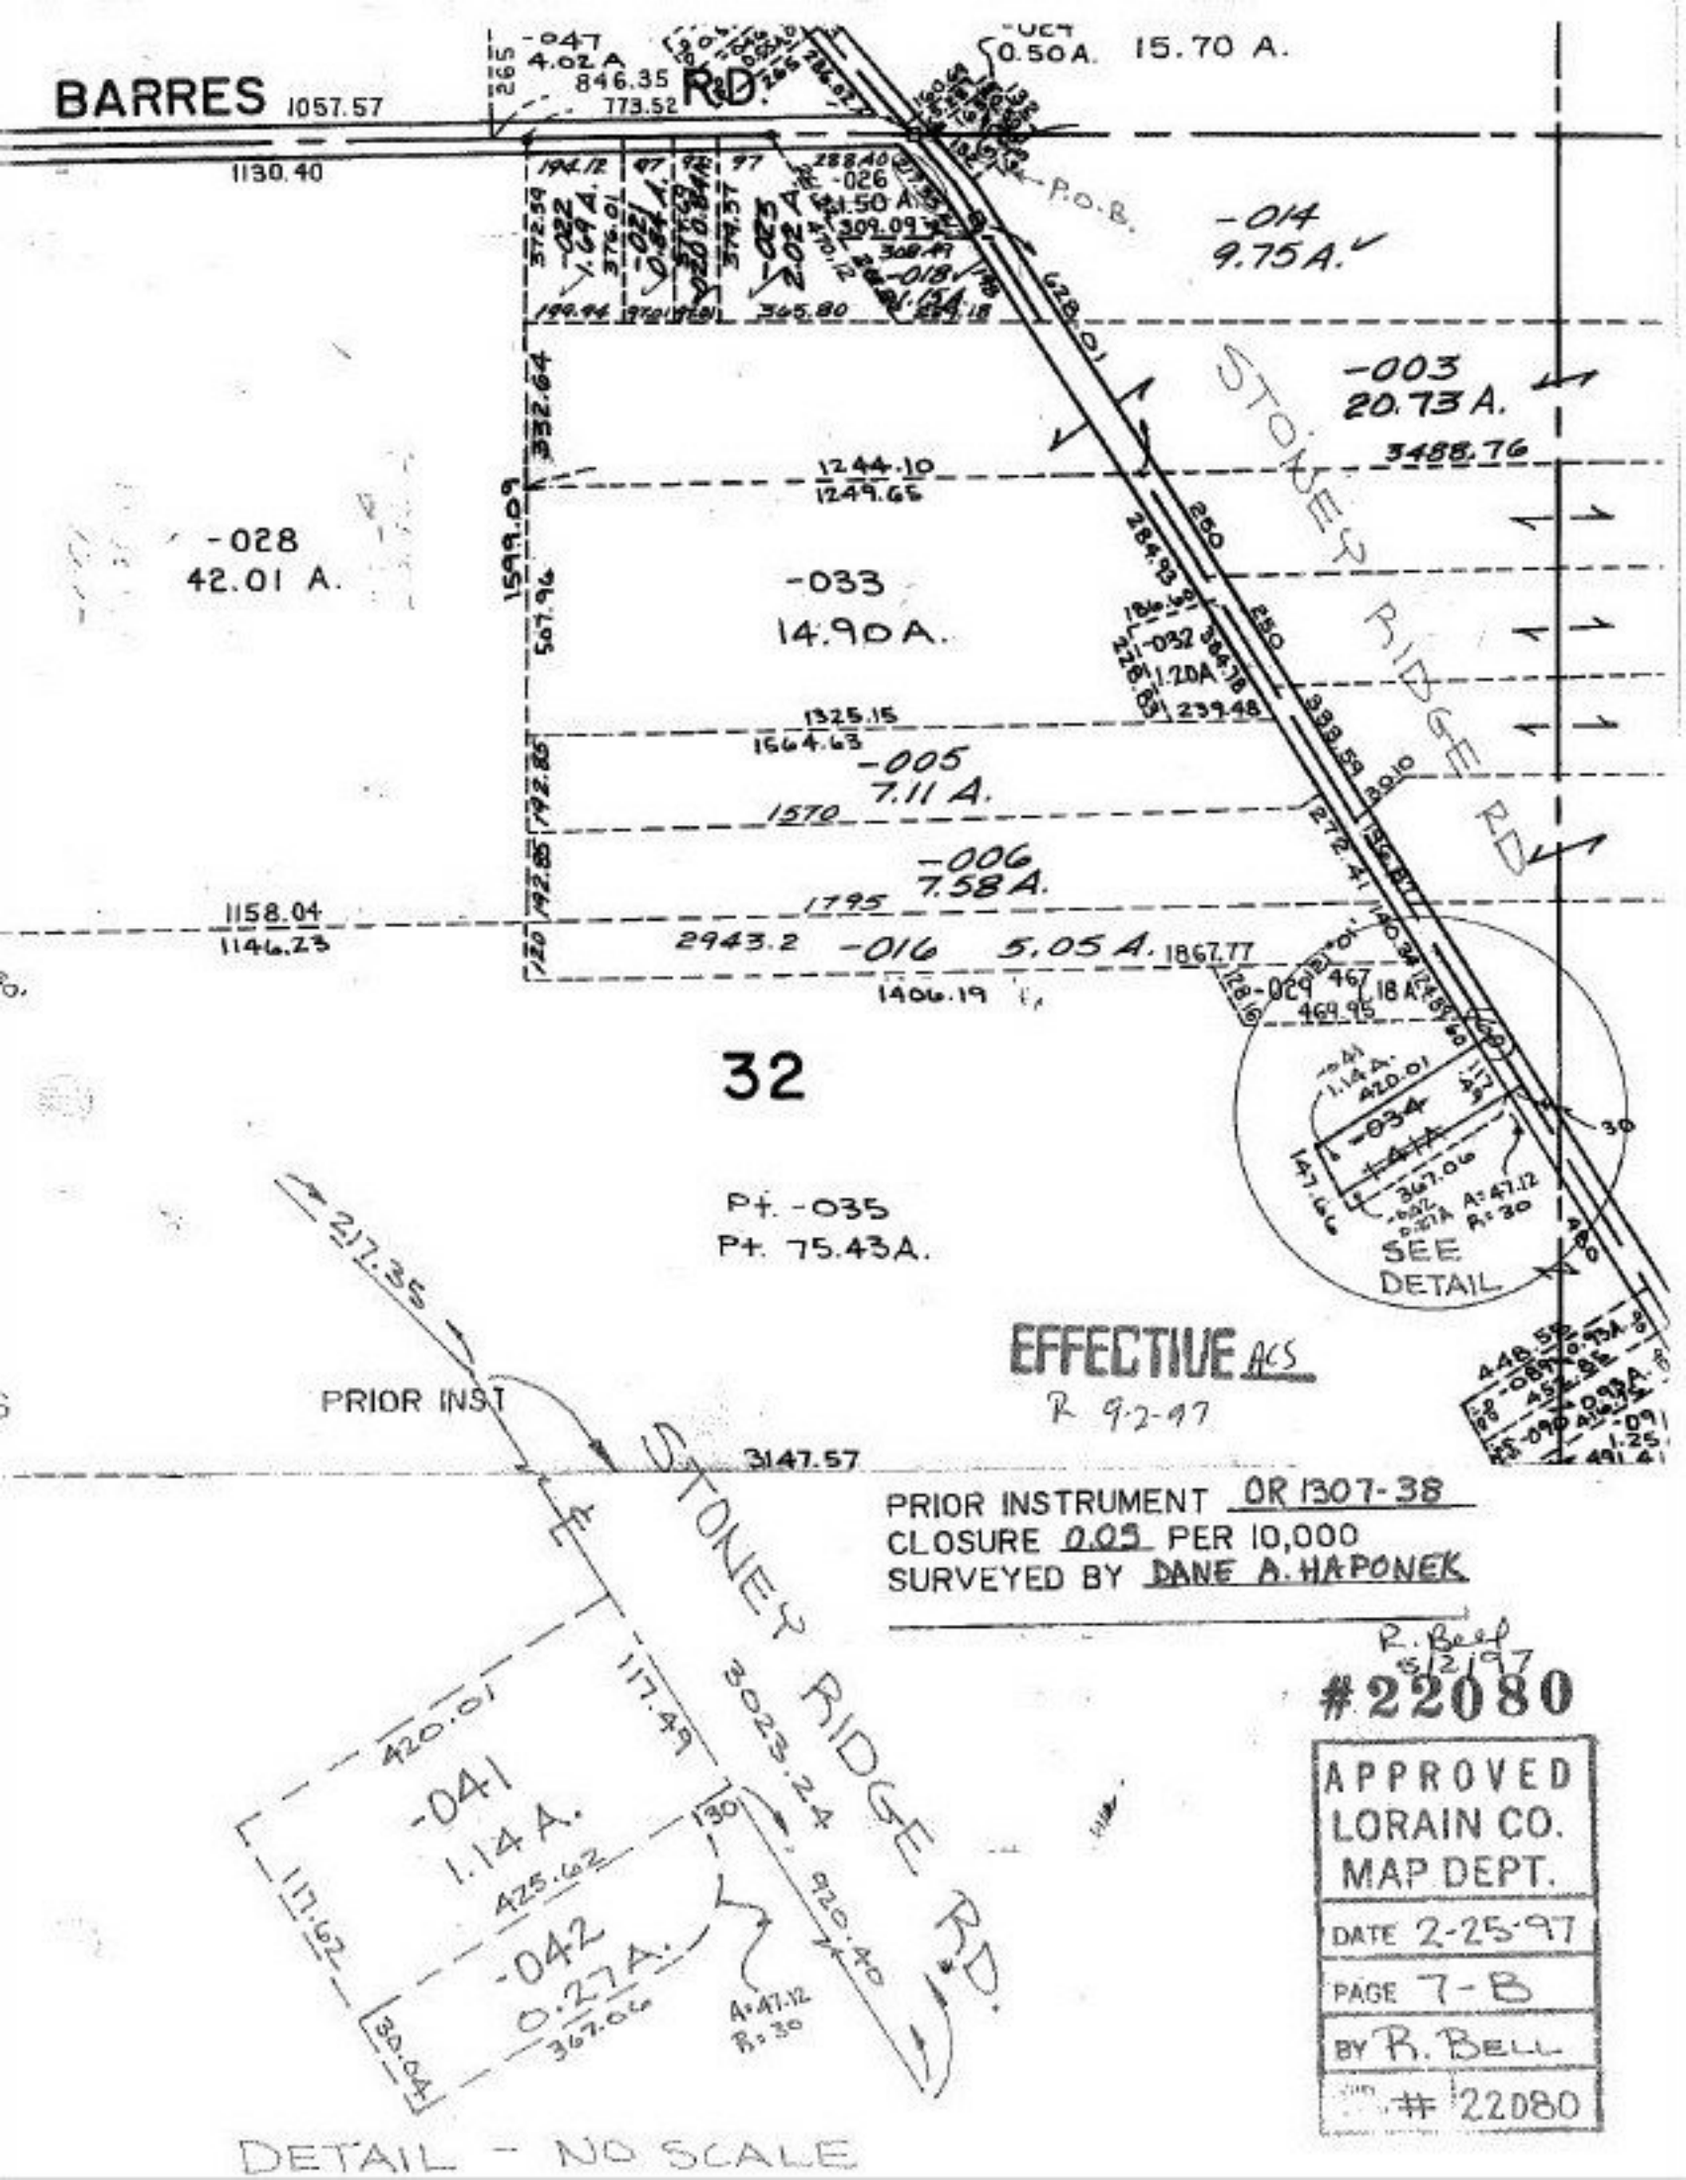
BARRES
1057.57
1130.40
-047
4.02 A
846.35
773.52
RD.
-027
0.50A.
15.70 A.
P.O.B.
-014
9.75A.
-022
1.29 A.
-021
0.84 A.
-023
2.02 A.
-026
1.50 A.
-018
1.34 A.
-003
20.73 A.
3488.76
STONEY RIDGE RD.
-028
42.01 A.
-033
14.90A.
-032
1.20A
-005
7.11 A.
-006
7.58A.
-016
5.05 A.
1867.77
2943.2
1406.19
1158.04
1146.23
1599.09
1244.10
1249.65
1325.15
1664.63
1570
1795
3147.57
32
Pt. -035
Pt. 75.43A.
-029
18 A.
-041
1.14 A.
420.01
-034
-042
0.27A.
367.06
A=47.12
R=30
SEE DETAIL
EFFECTIVE ACS
R 9-2-97
PRIOR INST
217.35
STONEY RIDGE RD.
PRIOR INSTRUMENT OR 1307-38
CLOSURE 0.05 PER 10,000
SURVEYED BY DANE A. HAPONEK
R. Bell 5/2/97
#22080
APPROVED
LORAIN CO.
MAP DEPT.
DATE 2-25-97
PAGE 7-B
BY R. BELL
22080
DETAIL - NO SCALE