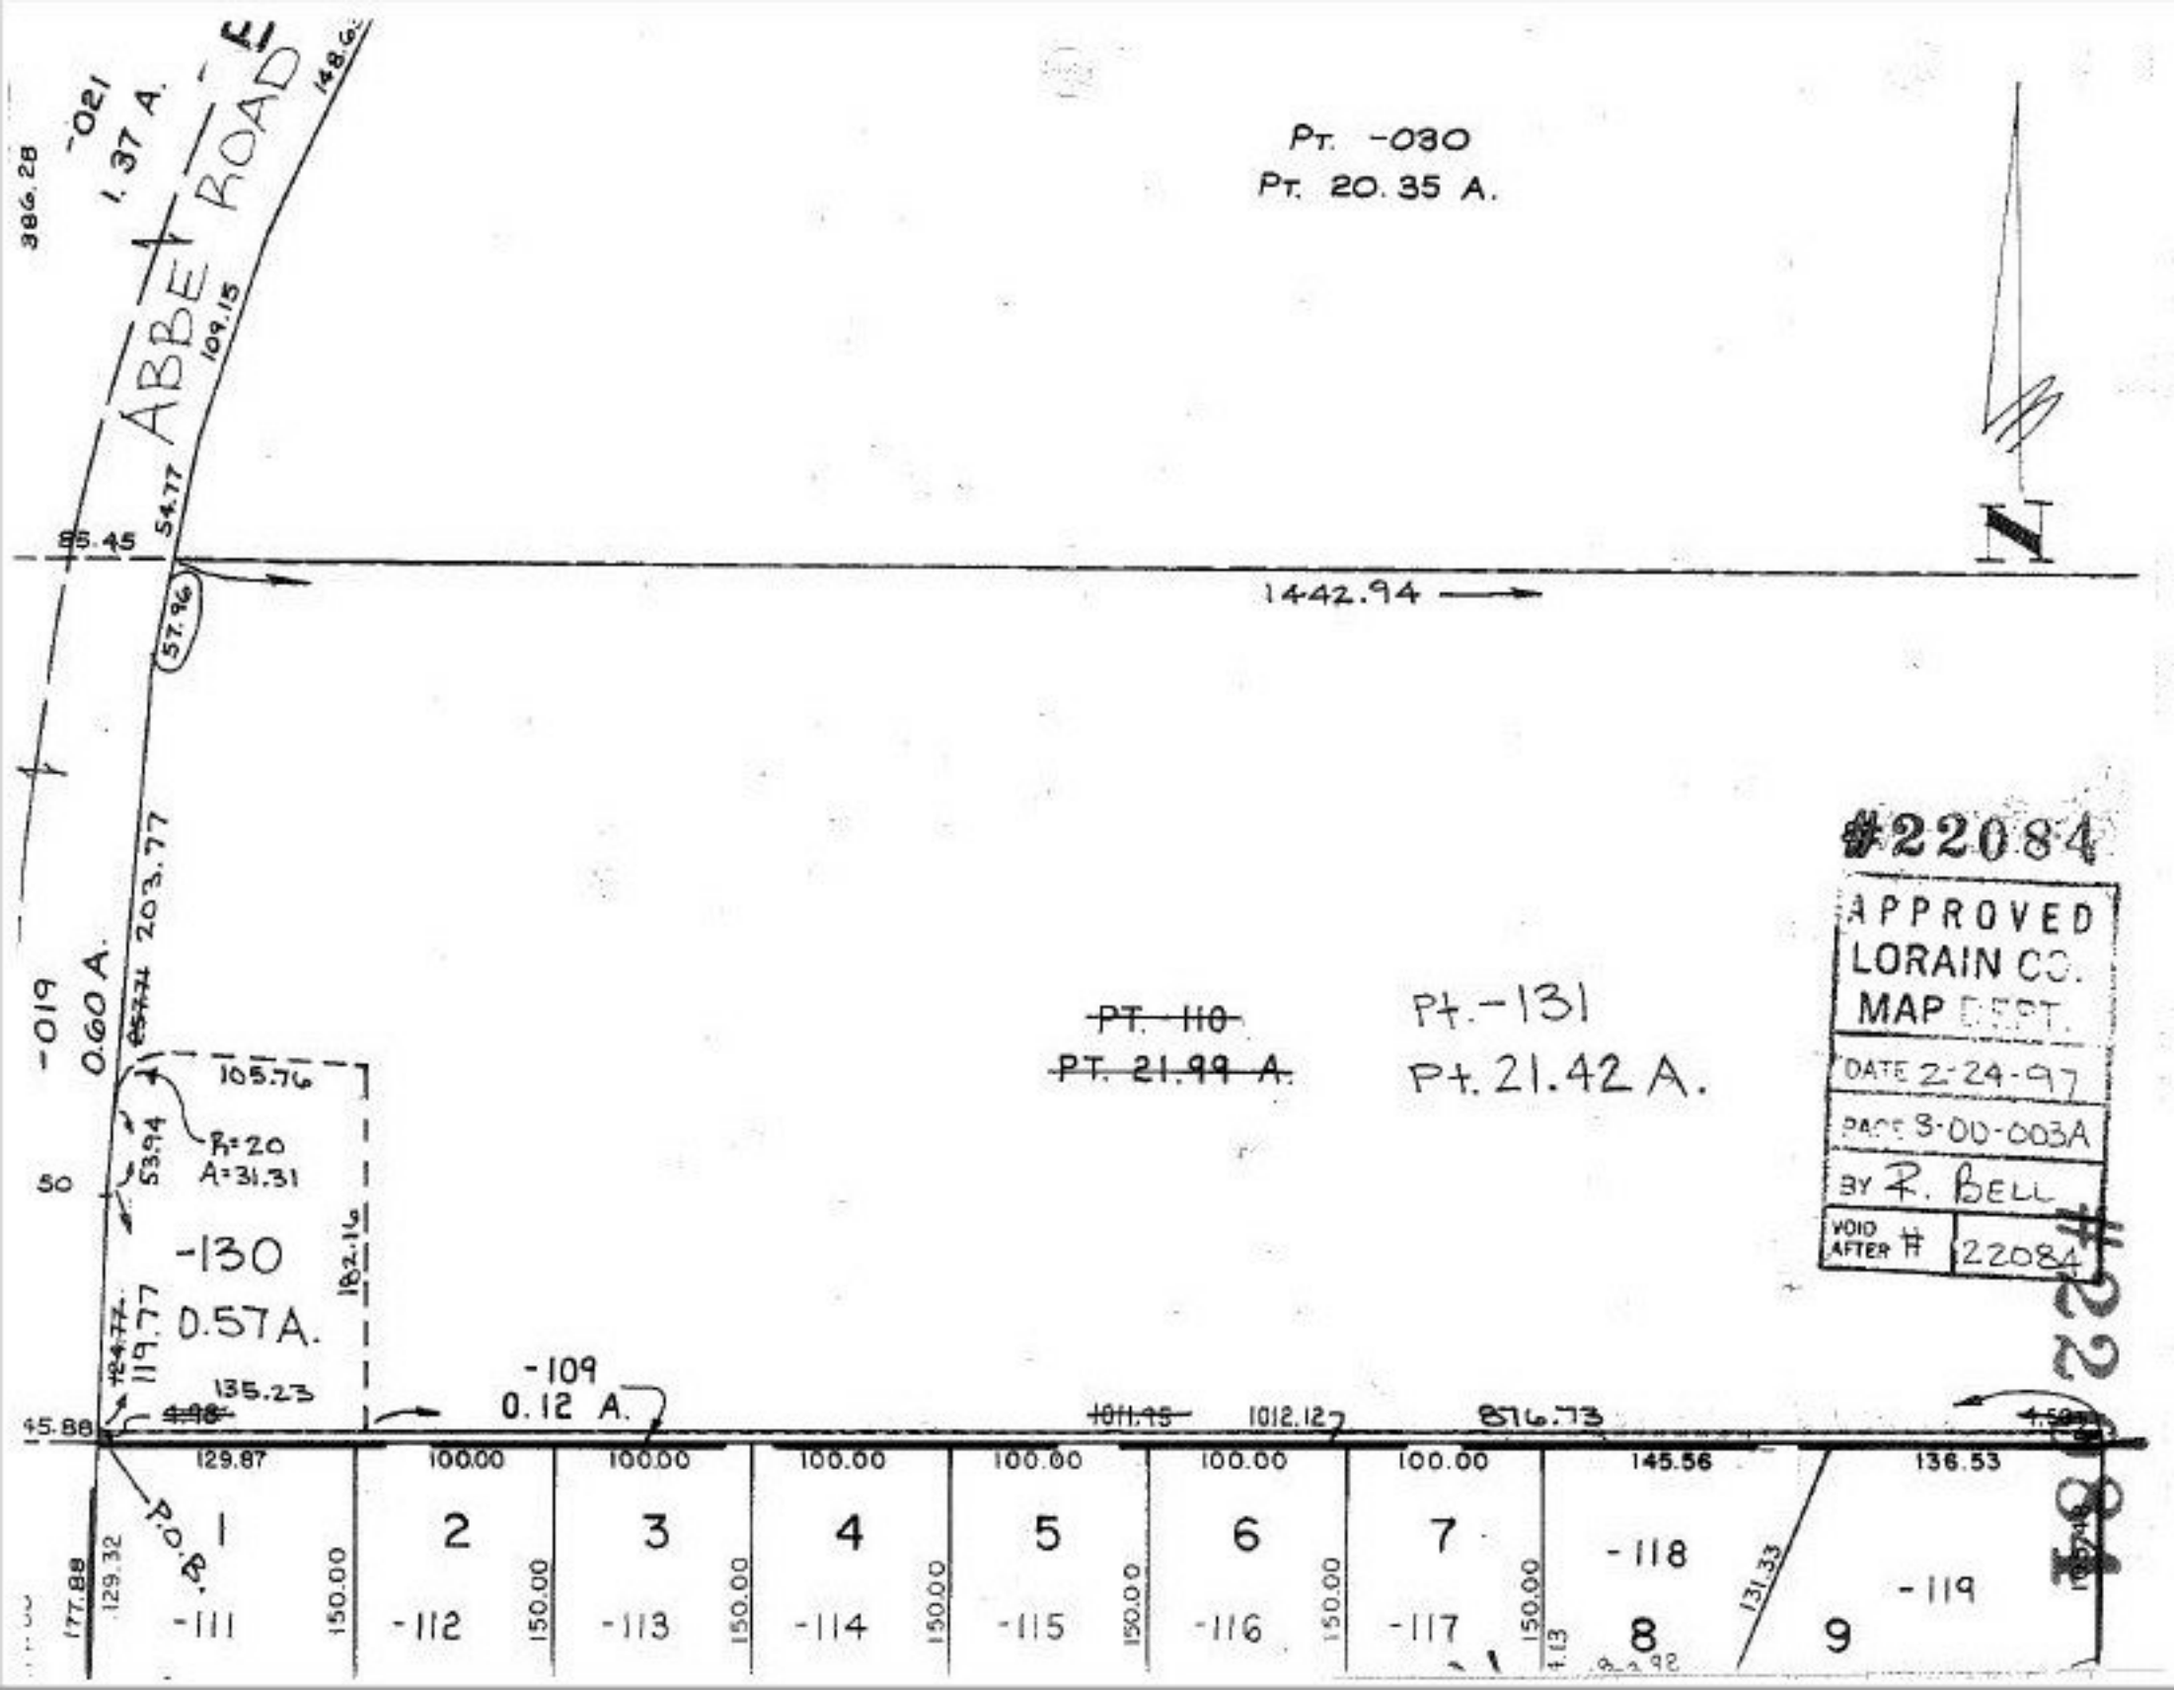
ABBE ROAD
-021
1.37 A.
386.28
148.6
109.15
54.77
95.45
57.96
PT. -030
PT. 20.35 A.
N
1442.94
203.77
-019
0.60 A.
105.76
53.94
R=20
A=31.31
50
-130
0.57A.
182.16
119.77
135.23
-109
0.12 A.
45.88
PT. 110
PT. 21.99 A.
Pt.-131
Pt. 21.42 A.
1011.45
1012.12
876.73
129.87
100.00
100.00
100.00
100.00
100.00
100.00
145.56
136.53
177.88
129.32
150.00
1
-111
2
-112
3
-113
4
-114
5
-115
6
-116
7
-117
-118
8
-119
9
131.33
#22084
APPROVED
LORAIN CO.
MAP DEPT.
DATE 2-24-97
PAGE 3-00-003A
BY R. BELL
VOID AFTER # 22084
#22084