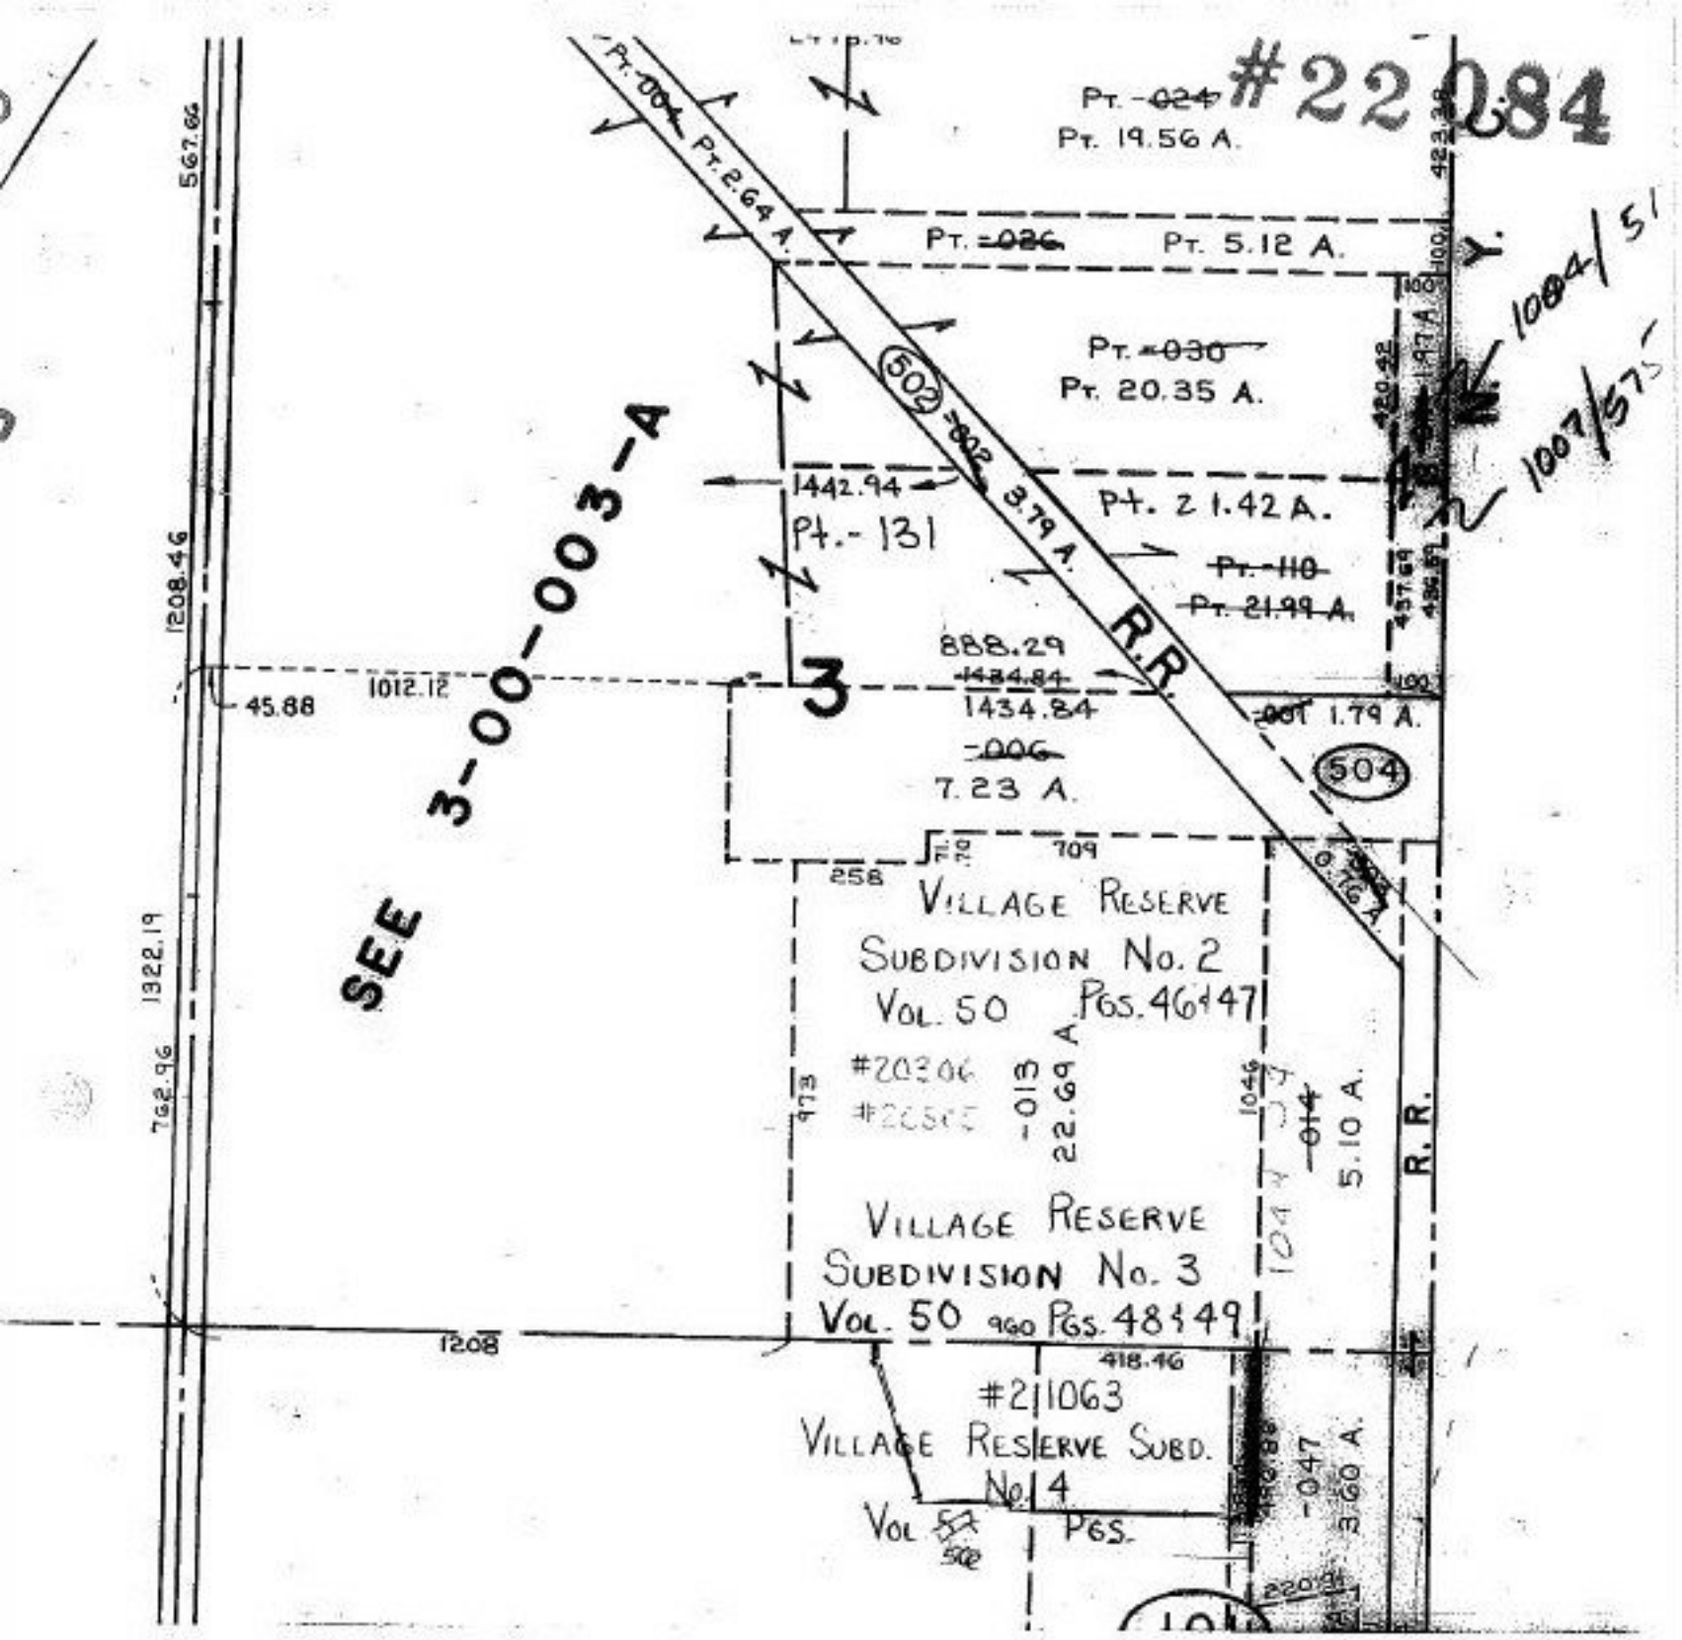

#22084

APPROVED LORAIN CO. MAP DEPT.
DATE 2-24-97
PAGE 3-L
BY R. BELL
VOID AFTER # 22084