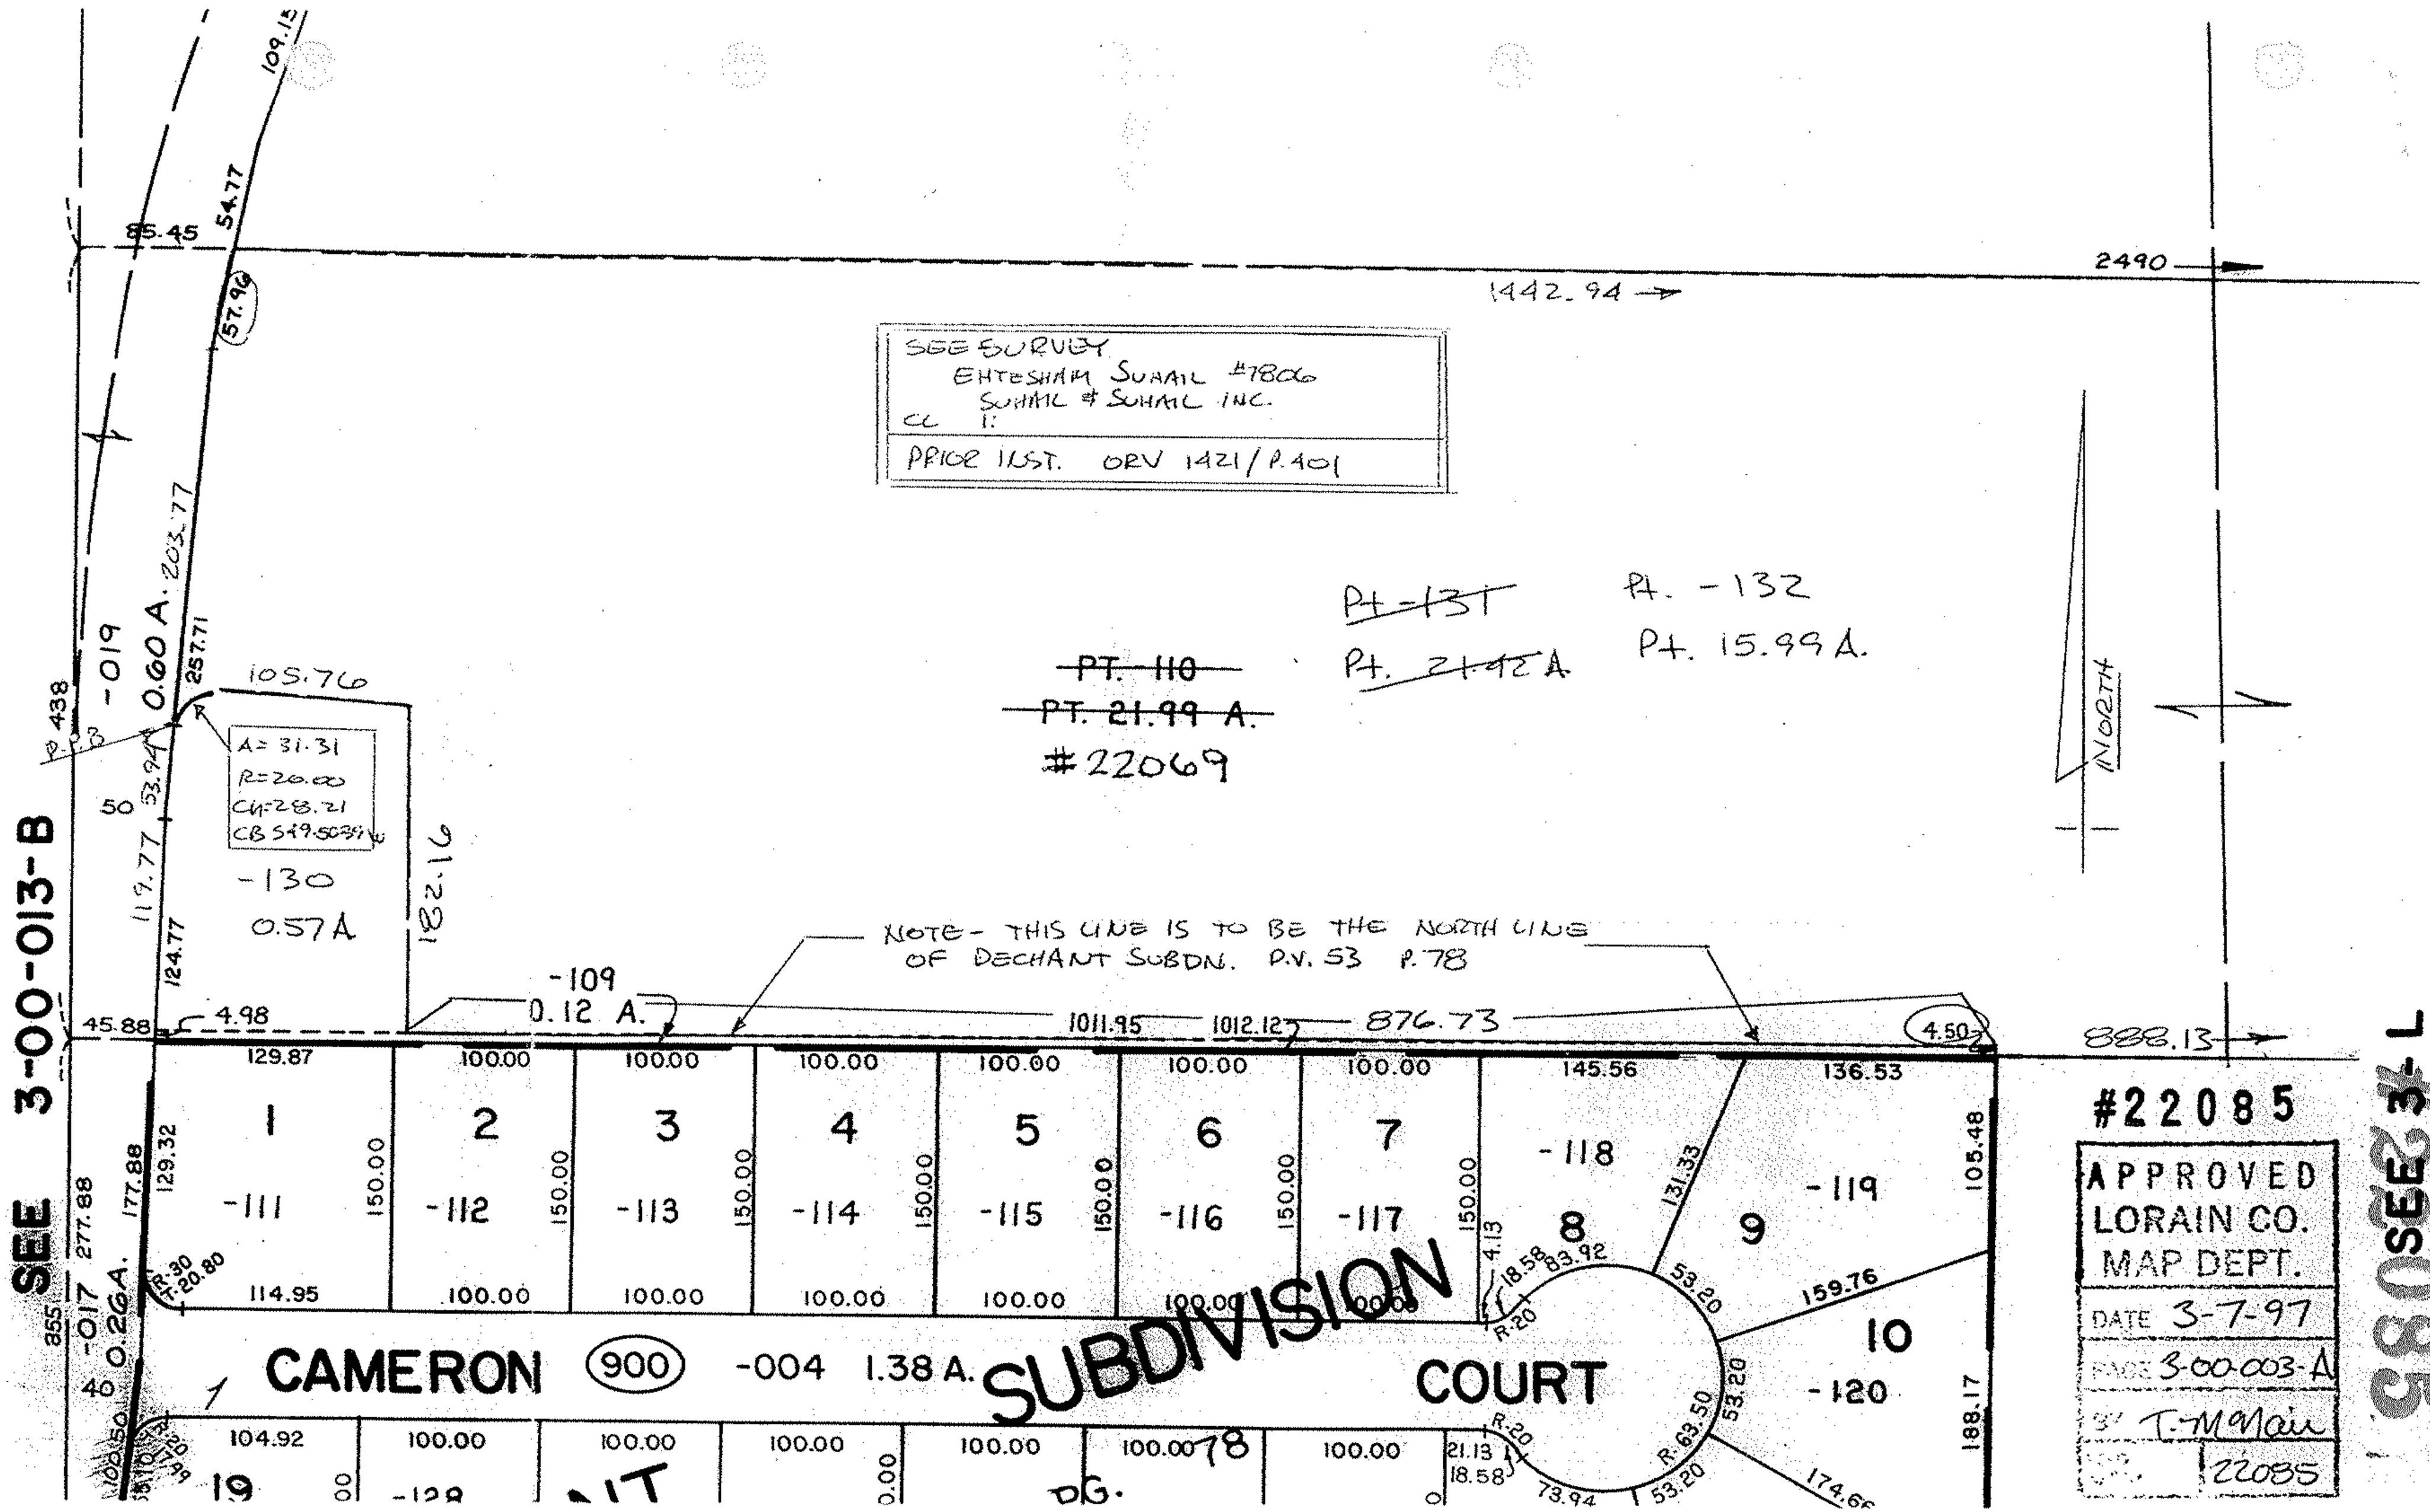

SEE SURVEY
EHTESHAM SUHAIL #7806
SUHAIL & SUHAIL INC.
CL 1:
PRIOR INST. ORV 1421/P.401
~~Pt -131~~
Pt. -132
~~Pt. 21.42 A~~
Pt. 15.99 A.
~~PT. 110~~
~~PT. 21.99 A.~~
#22069
NORTH
A= 31.31
R=20.00
Ch=28.21
CB S49.50.39
-130
0.57 A
-109
0.12 A.
NOTE- THIS LINE IS TO BE THE NORTH LINE OF DECHANT SUBDN. P.V. 53 P.78
1442.94
2490
888.13
876.73
1011.95
1012.12
-019
0.60 A.
-017
0.26 A.
CAMERON 900 -004 1.38 A.
SUBDIVISION
COURT
#22085
APPROVED
LORAIN CO.
MAP DEPT.
DATE 3-7-97
PAGE 3-00-003-A
BY T. McNair
22085
SEE 3-00-013-B
SEE 3-L