G-141 G-142

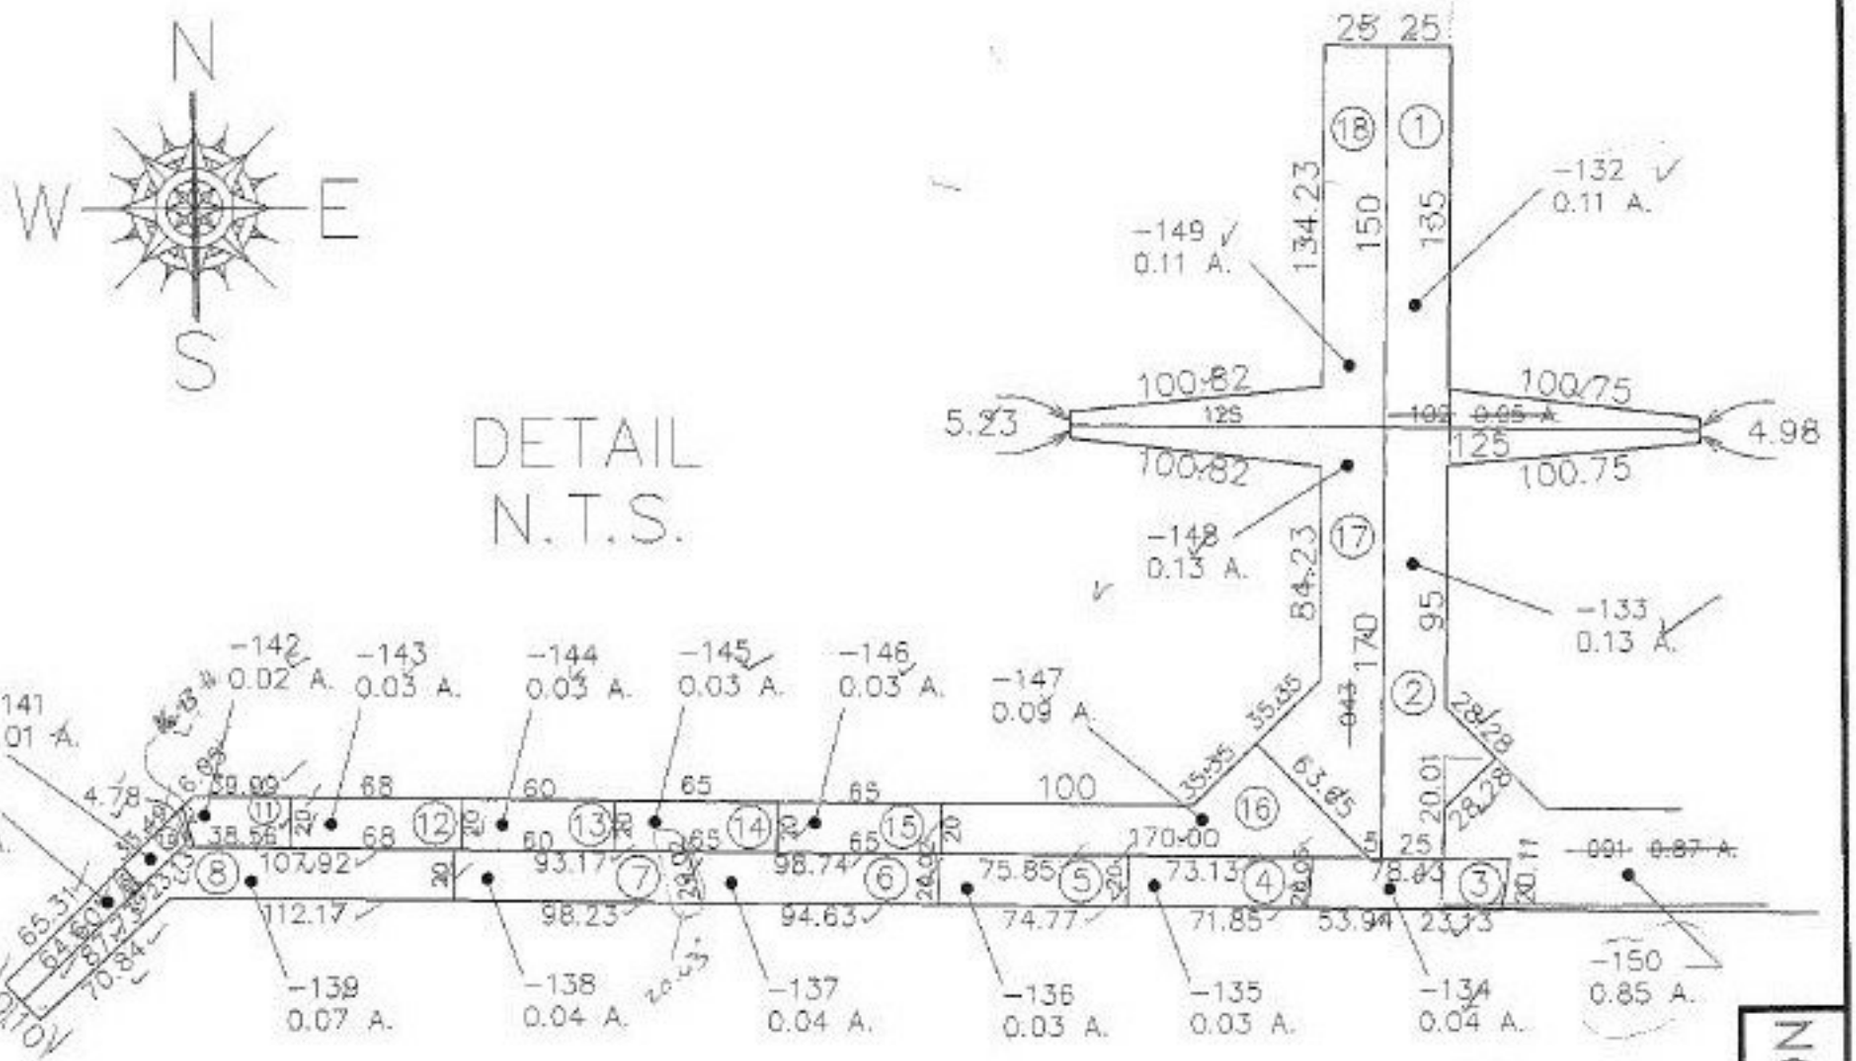
N
W
E
S
DETAIL
N.T.S.
25 25
18
1
134.23
150
135
-132
0.11 A.
-149
0.11 A.
100.82
100.75
5.23
125
125
4.98
100.82
100.75
-148
0.13 A.
17
84.23
170
95
-133
0.13 A.
2
-142
0.02 A.
-143
0.03 A.
-144
0.03 A.
-145
0.03 A.
-146
0.03 A.
-147
0.09 A.
-141
0.01 A.
-140
0.02 A.
9
11
12
13
14
15
16
100
170.00
68
60
65
65
68
60
65
65
107.92
93.17
98.74
75.85
73.13
8.04
112.17
98.23
94.63
74.77
71.85
53.94
23.73
8
7
6
5
4
3
-139
0.07 A.
-138
0.04 A.
-137
0.04 A.
-136
0.03 A.
-135
0.03 A.
-134
0.04 A.
-150
0.85 A.
NO. 22086
EFFECTIVE 4/26/97
SHEET (2) OF (2)