PARENT PARCEL: 06-25-002-111-102, 043, 091

CHILD PARCEL: 06-25-002-111-132 THRU -149

STARTING POINT: N corner of sublot 310 of Parkwood Estates No. 4

NO. 22086

EFFECTIVE 6/20/97

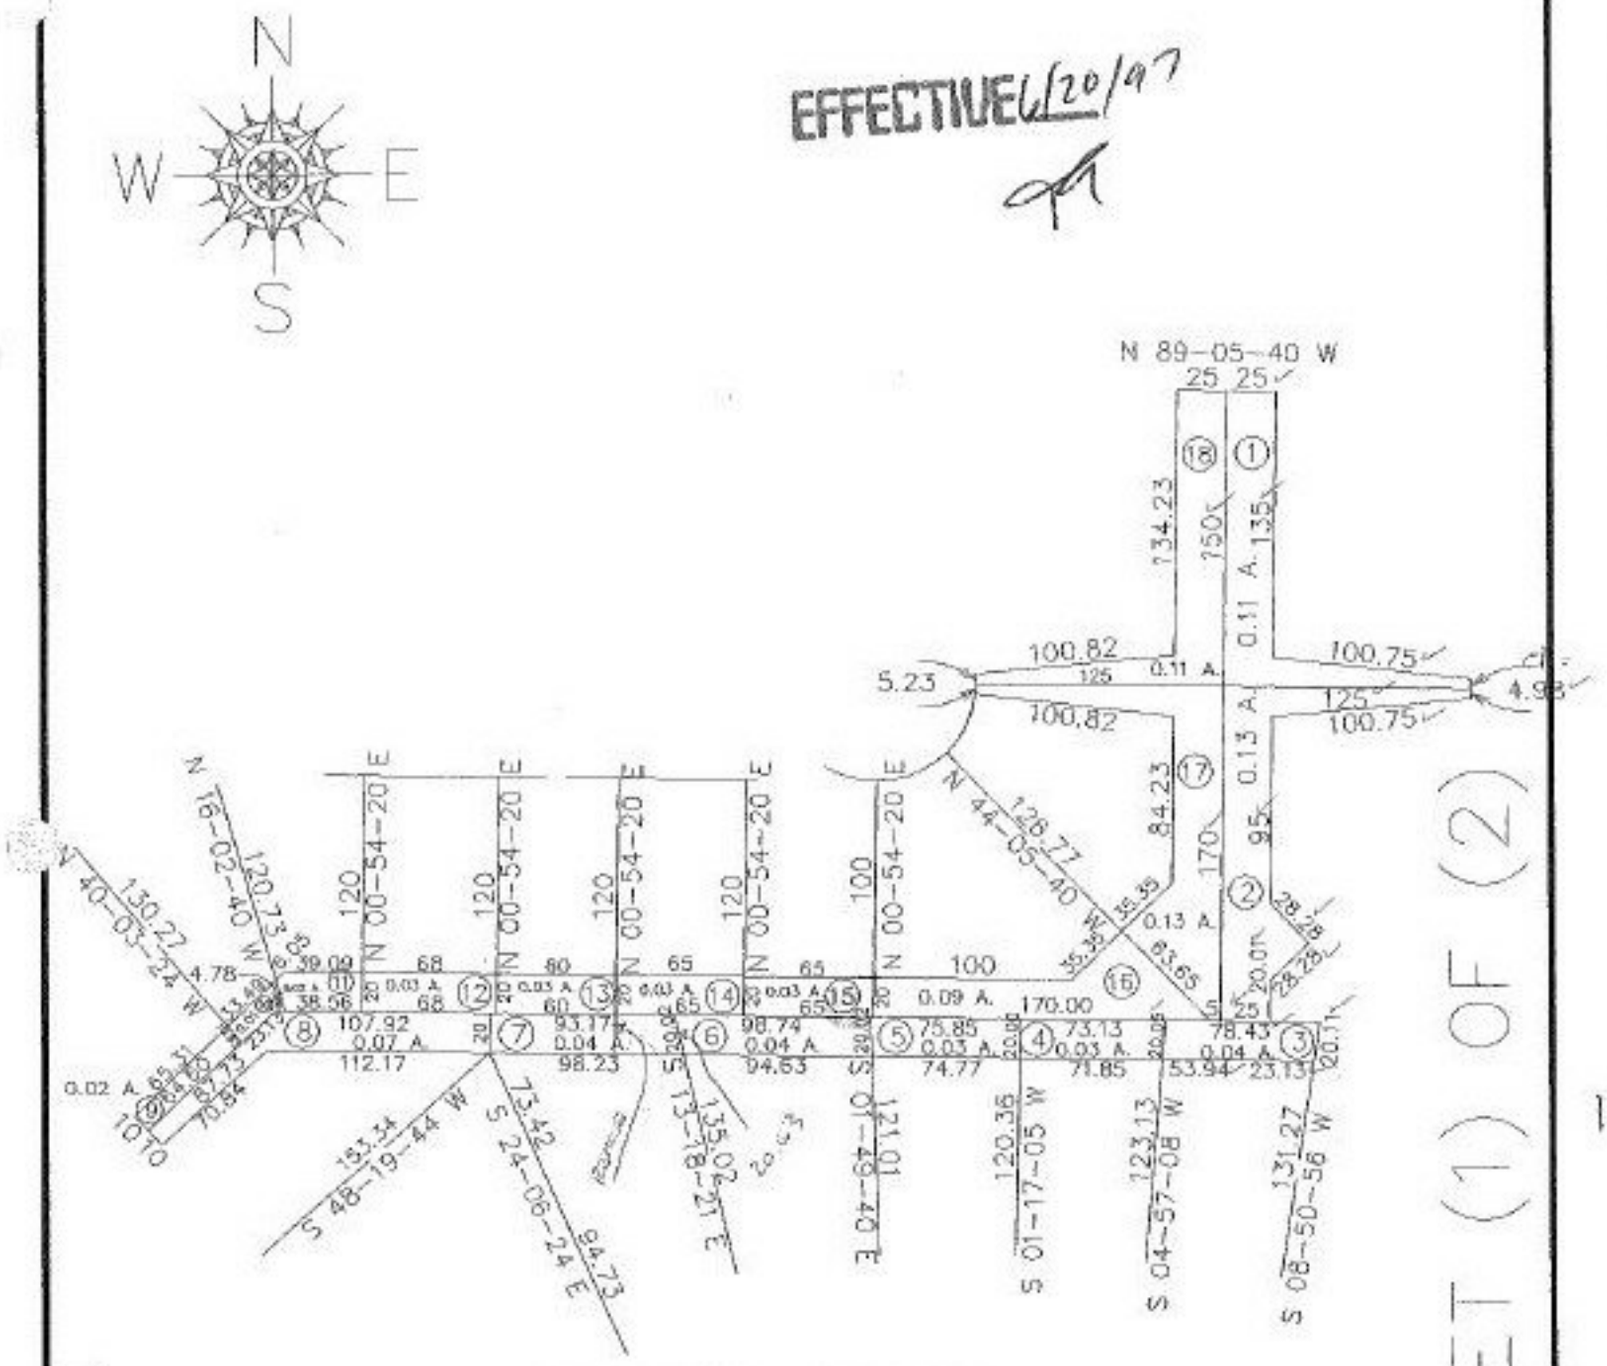

SEE SHEET 2 OF 2
FOR PARCEL NUMBERS

SHEET (1) OF (2)

DF 11-13-98

SPLITS/DEEDS PROCESSED

LORAIN COUNTY TAX MAP DEPARTMENT
226 MIDDLE AVE. ELYRIA, OHIO

SURVEYED BY: Rodger C. Simon

CLOSURE: 0.00 : 10,000

MAP PAGE(S): 06-141, 06-142

APPROVED BY: kac DATE: 3-25-97

SCALE: 1" = 100

CLH 12/3/98