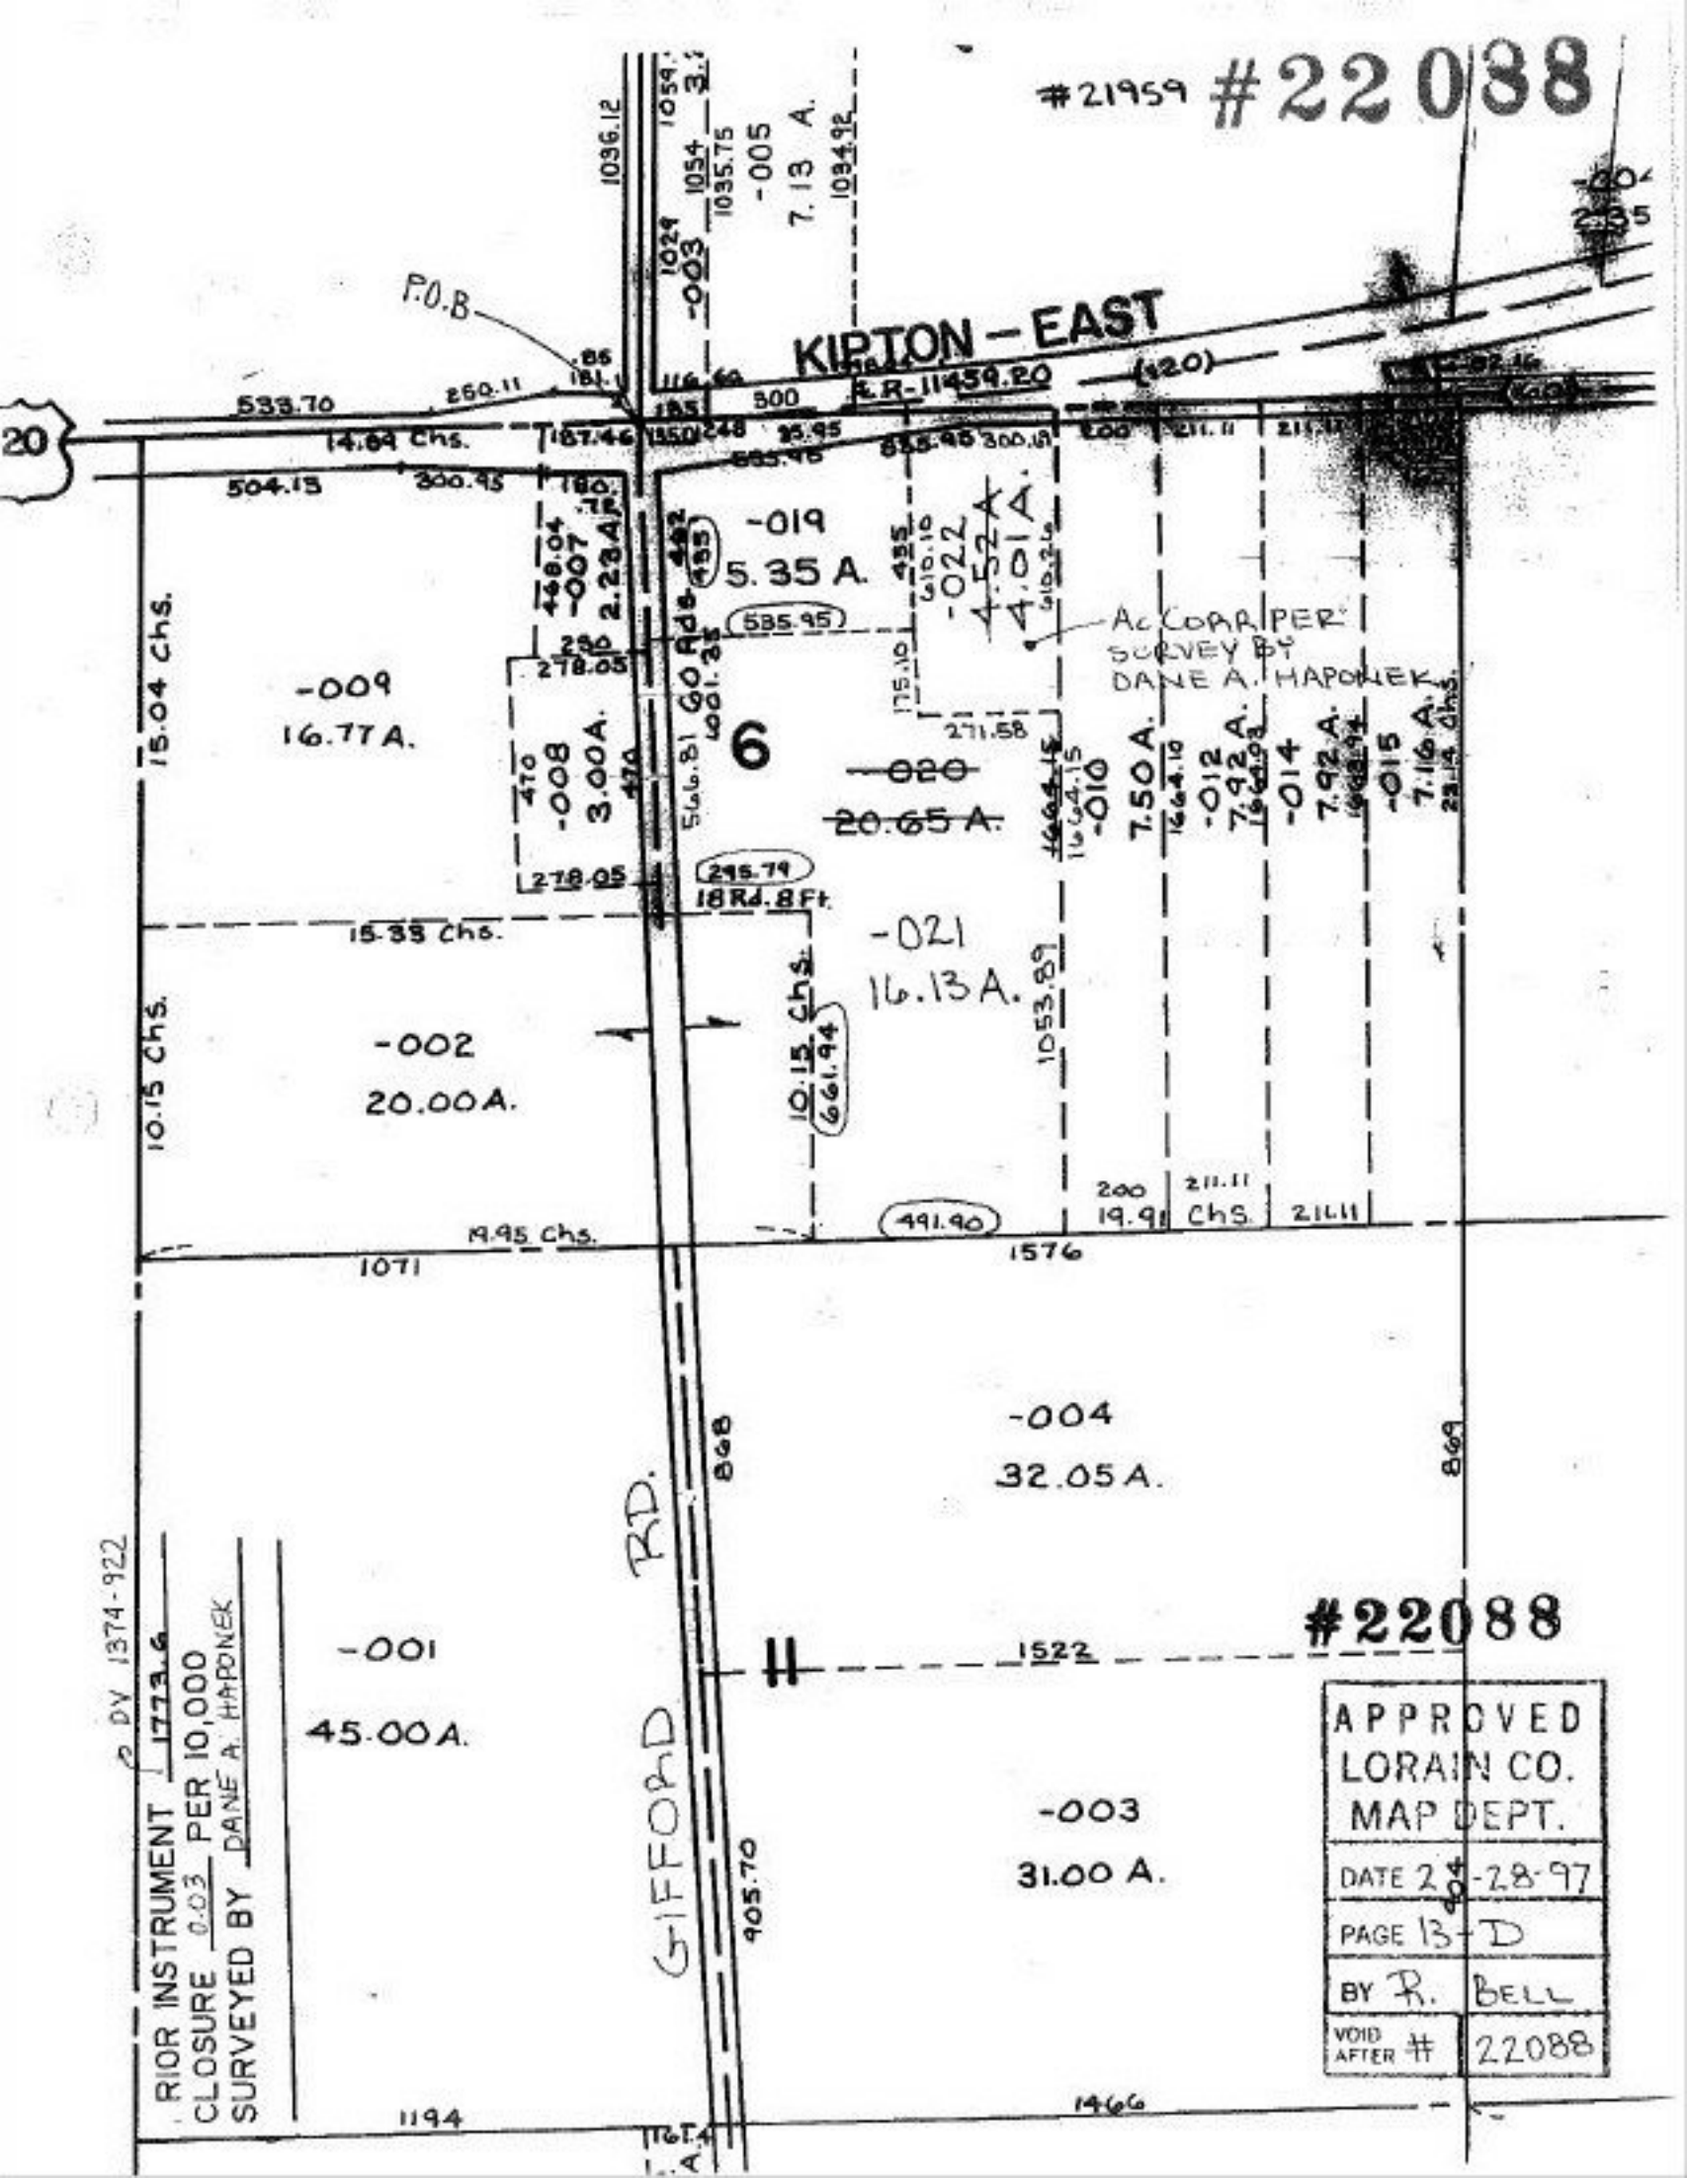
#21959 #22088
KIPTON – EAST
P.O.B
S.R.-11459.20
(120)
20
533.70
260.11
14.64 Chs.
504.15
300.95
15.04 Chs.
-009
16.77 A.
-007
2.23 A.
-019
5.35 A.
-022
4.52 A.
4.01 A.
AS CORRECTED SURVEY BY DANE A. HAPONEK
-008
3.00 A.
6
-020
20.65 A.
-010
7.50 A.
-012
7.92 A.
-014
7.92 A.
-015
7.16 A.
60 Rds.
18 Rd. 8 Ft.
-021
16.13 A.
-002
20.00 A.
10.15 Chs.
15.33 Chs.
1053.89
19.95 Chs.
1071
1576
-004
32.05 A.
GIFFORD RD.
868
869
#22088
1522
-001
45.00 A.
-003
31.00 A.
905.70
1194
1466
PRIOR INSTRUMENT DV 1374-922
CLOSURE 0.03 PER 10,000
SURVEYED BY DANE A. HAPONEK
APPROVED
LORAIN CO.
MAP DEPT.
DATE 2-28-97
PAGE 13-D
BY R. BELL
VOID AFTER # 22088