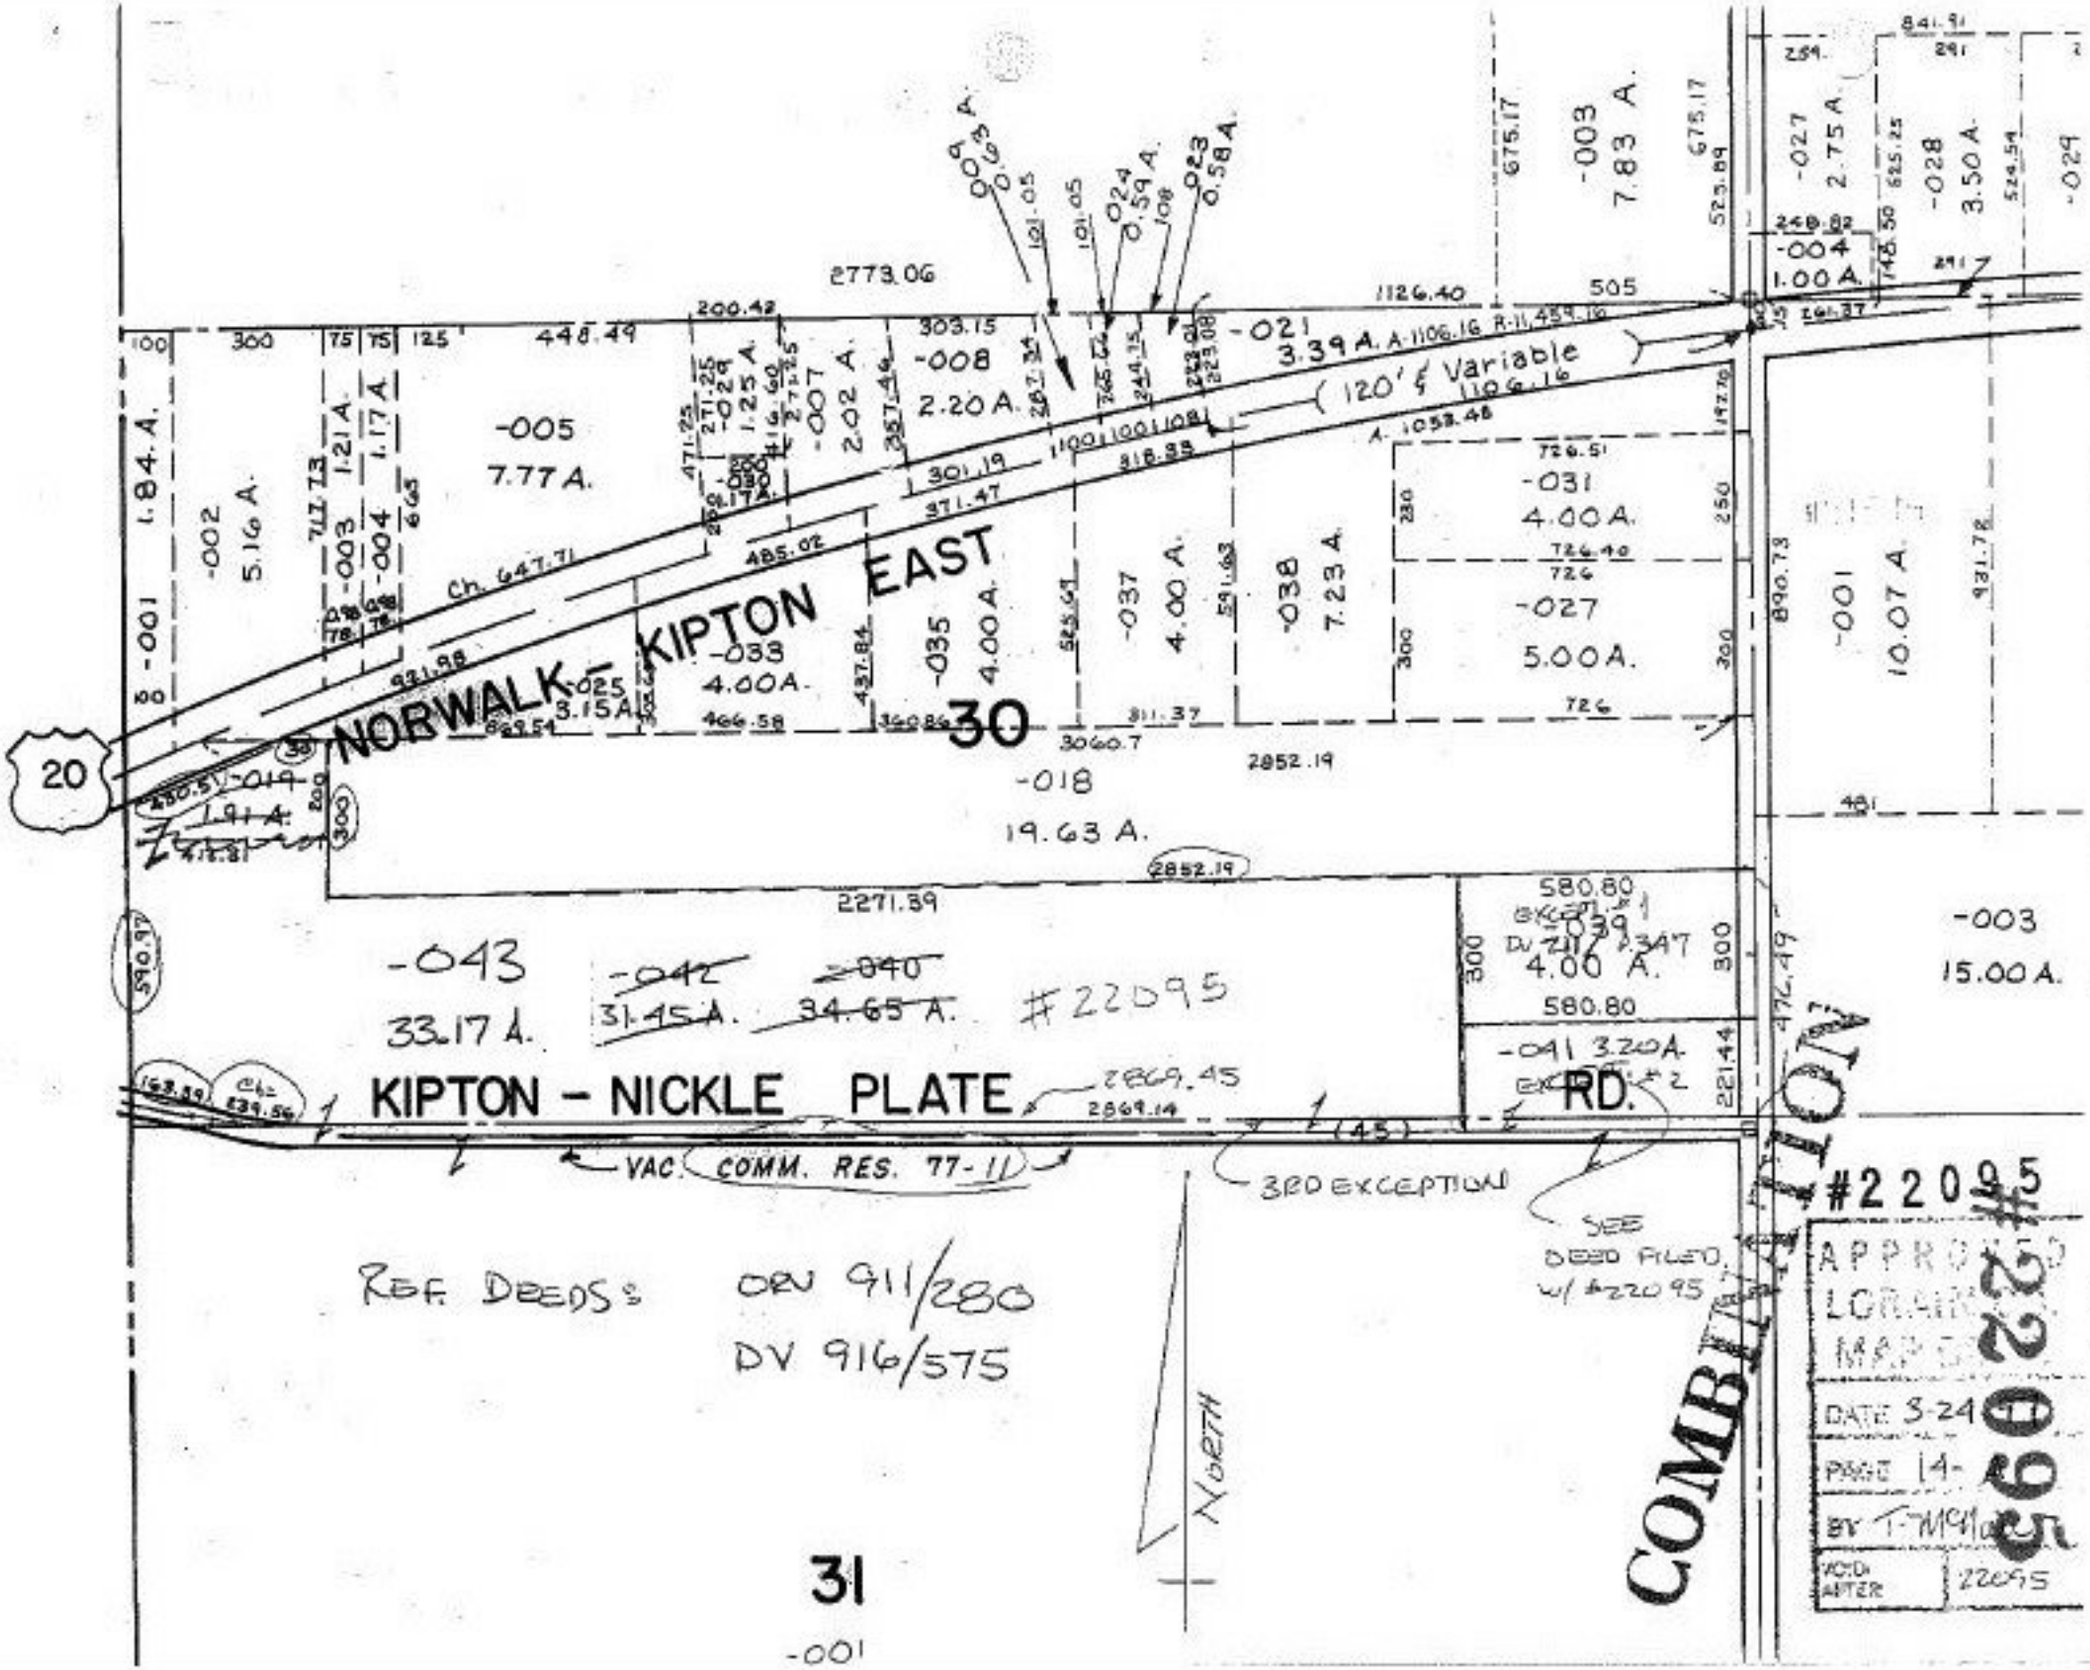

NORWALK - KIPTON EAST
KIPTON - NICKLE PLATE
RD.
VAC. COMM. RES. 77-11
3RD EXCEPTION
SEE DEED FILED w/ #22095
120' & Variable
-005 7.77 A.
-008 2.20 A.
-021 3.39 A.
-031 4.00 A.
-027 5.00 A.
-033 4.00 A.
-035 4.00 A.
-037 4.00 A.
-038 7.23 A.
-001 10.07 A.
-003 15.00 A.
-043 33.17 A.
-042 31.45 A.
-040 34.65 A.
#22095
-041 3.20 A.
-039 4.00 A.
-018 19.63 A.
-019 1.91 A.
-002 5.16 A.
-001 1.84 A.
-003 7.83 A.
-027 2.75 A.
-028 3.50 A.
-004 1.00 A.
-007 2.02 A.
-025 3.15 A.
-029
20
30
31
NORTH
COMBINATION
#22095
APPROVED
LORAIN
MAP
DATE 3-24
PAGE 14-
BY T. McNa
VOID AFTER 22095
REF. DEEDS: ORV 911/280
DV 916/575