#22099

NO. 22099

PARENT PARCEL: 02-01-008-101-319 & -320

CHILD PARCEL: 02-01-008-101-369

STARTING POINT: INT CL QUEEN ANNE AVENUE & NLY OF NOTTINGHAM WOODS SUBD.

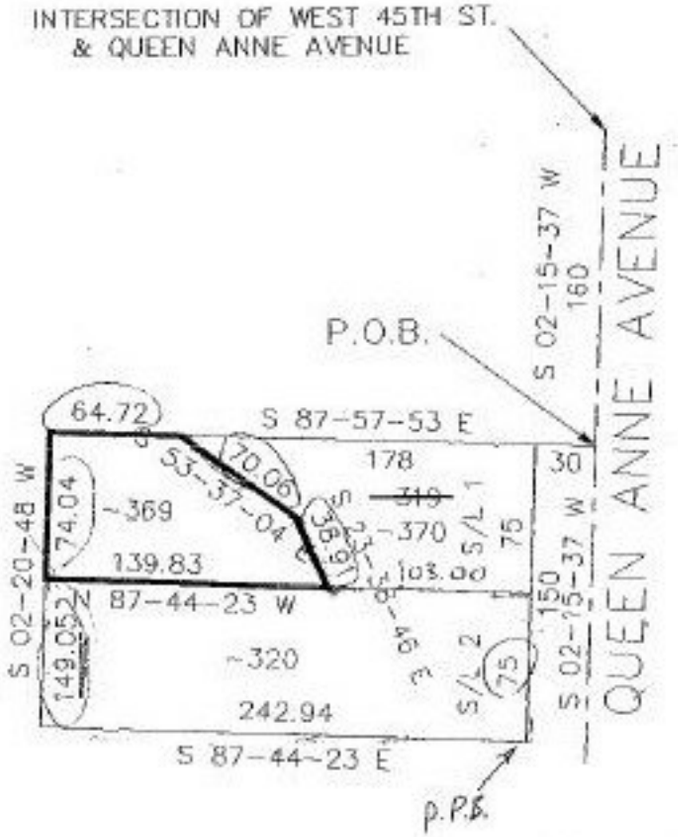

SPLITS/DEEDS PROCESSED

LORAIN COUNTY TAX MAP DEPARTMENT
226 MIDDLE AVE. ELYRIA, OHIO

SURVEYED BY: DAVID L. ELWELL

CLOSURE: 0.17:10,000

MAP PAGE(S): 2-01-008A

APPROVED BY: RFB DATE: 03/24/97

SCALE: 1"= 100