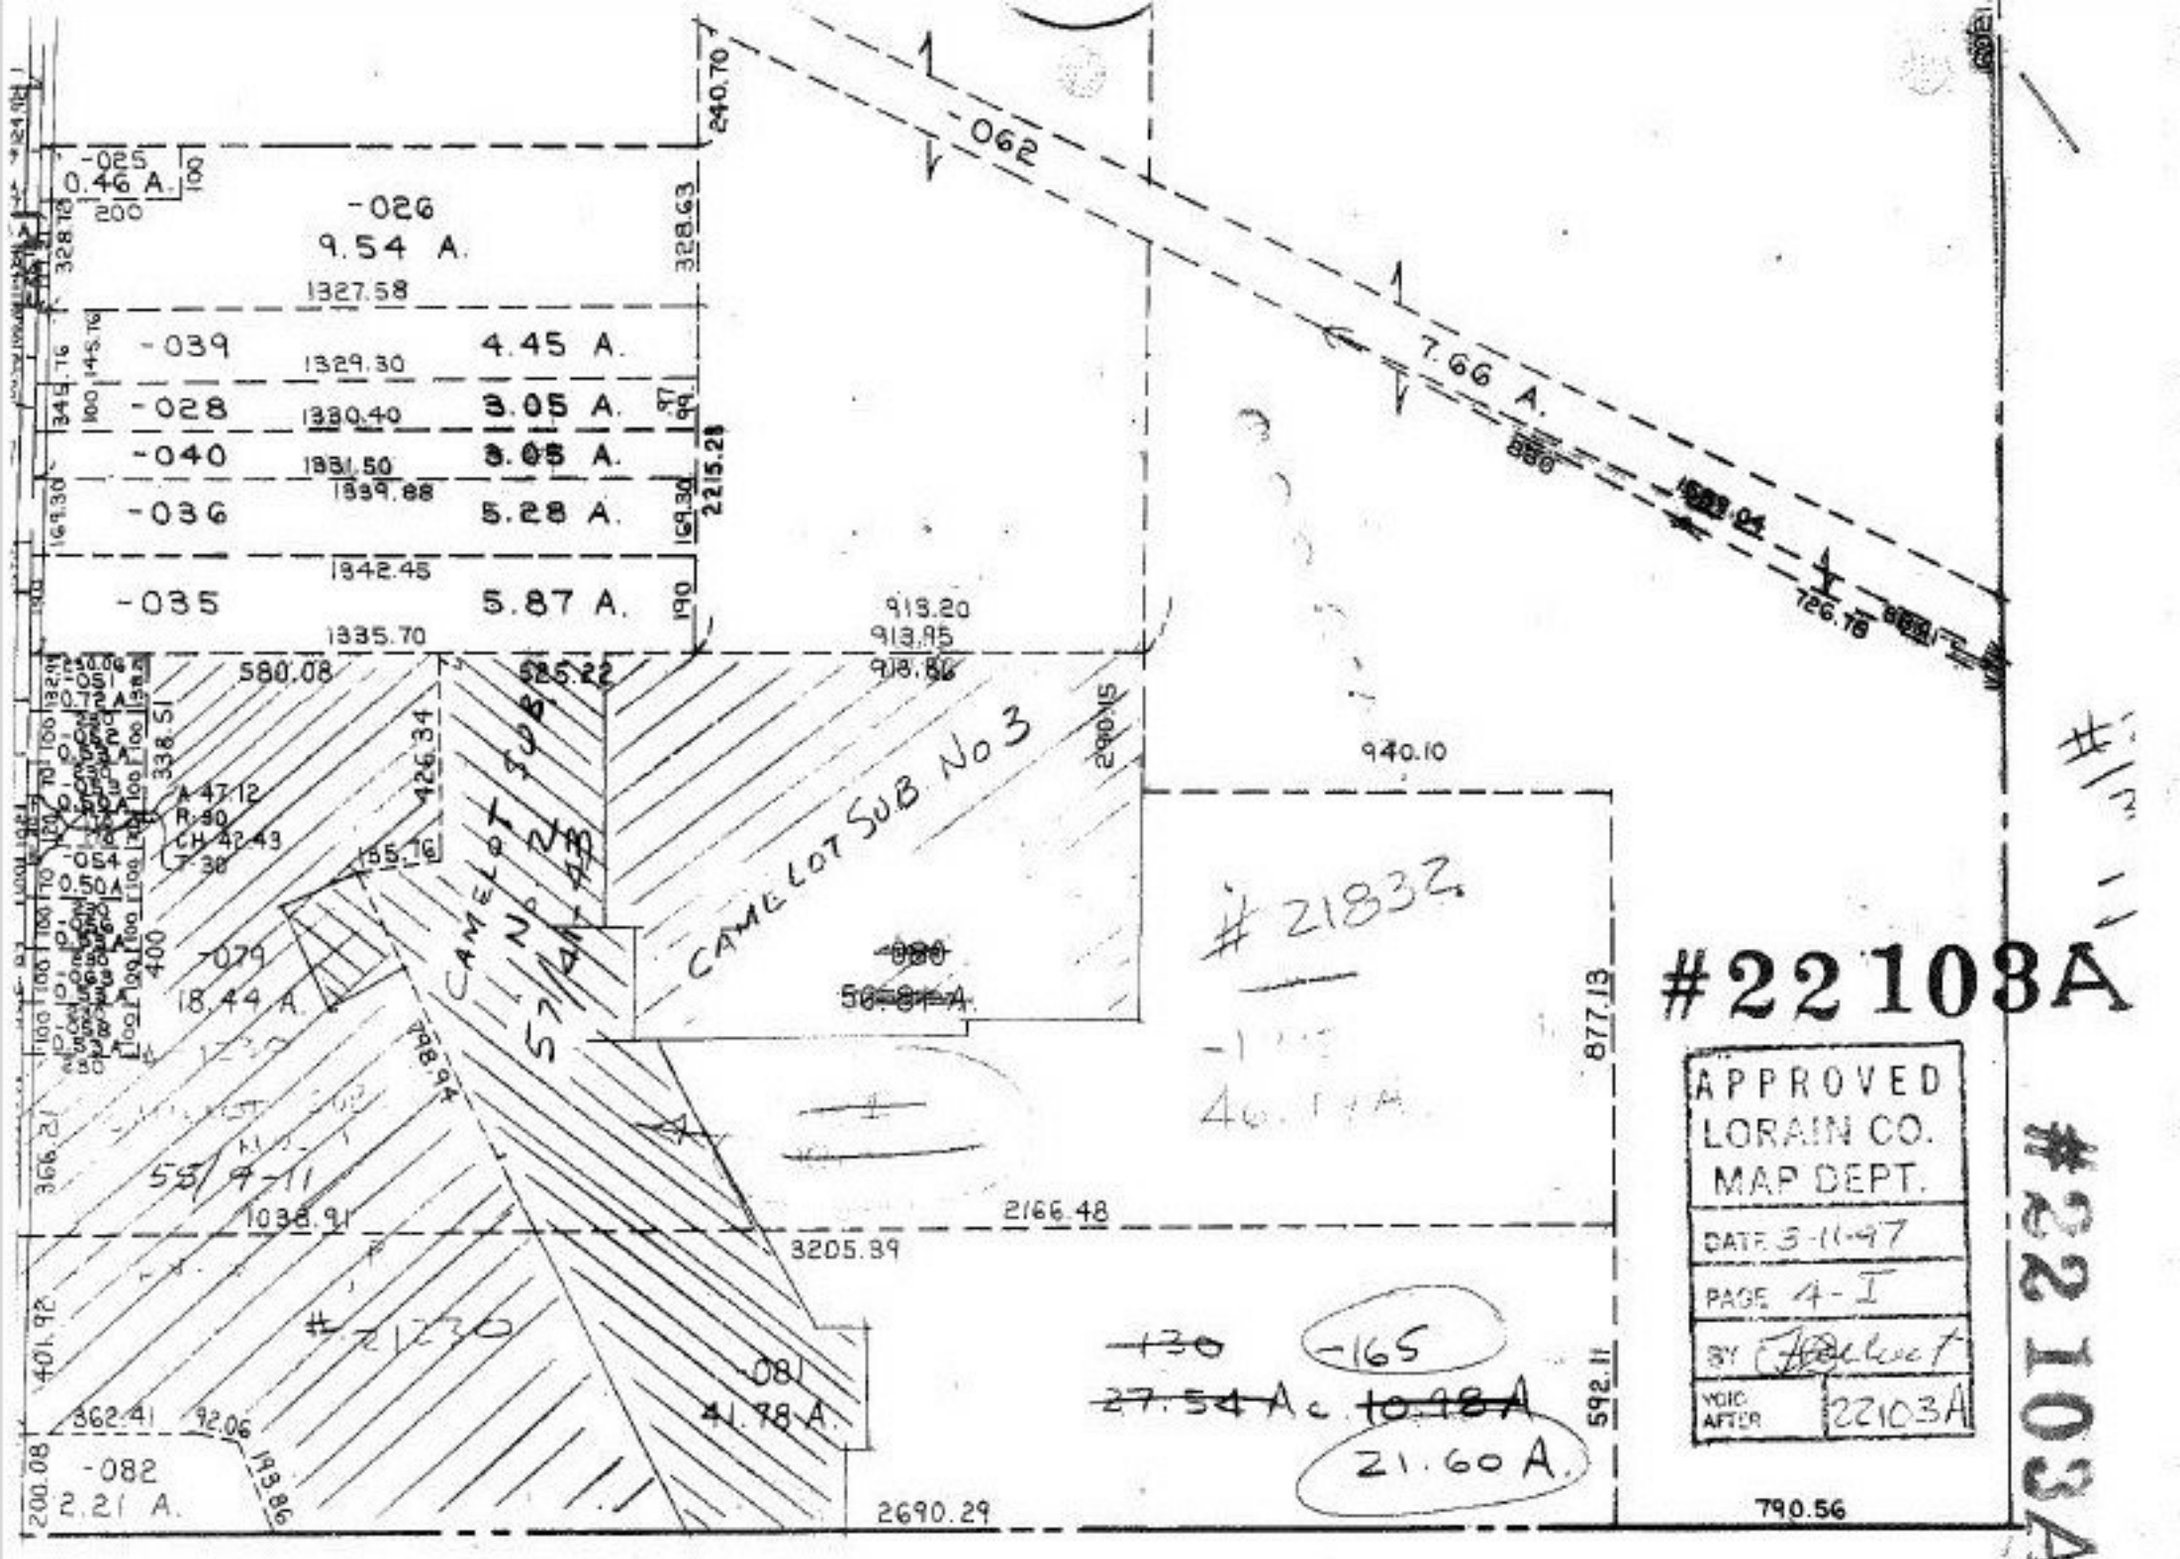
062
7.66 A.
-025
0.46 A.
-026
9.54 A.
-039
4.45 A.
-028
3.05 A.
-040
3.05 A.
-036
5.28 A.
-035
5.87 A.
CAMELOT SUB No 3
CAMELOT SUB No 2
-054
0.50A
-079
18.44 A.
-080
50.81 A.
-081
41.78 A.
-082
2.21 A.
#21832
#21230
-130
27.54 Ac.
-165
21.60 A.
APPROVED
LORAIN CO.
MAP DEPT.
DATE 3-11-97
PAGE 4-I
BY
VOID AFTER 22103A
#22103A
#22103A
SEE 7-A