#22106

PARENT PARCEL: 03-00-023-000-008, 020, 024

CHILD PARCEL: 03-00-023-000-025, 027, 029

STARTING POINT: INTERSECTION HARRIS ROAD & SLY LINE O.L. 23

NO. 22106

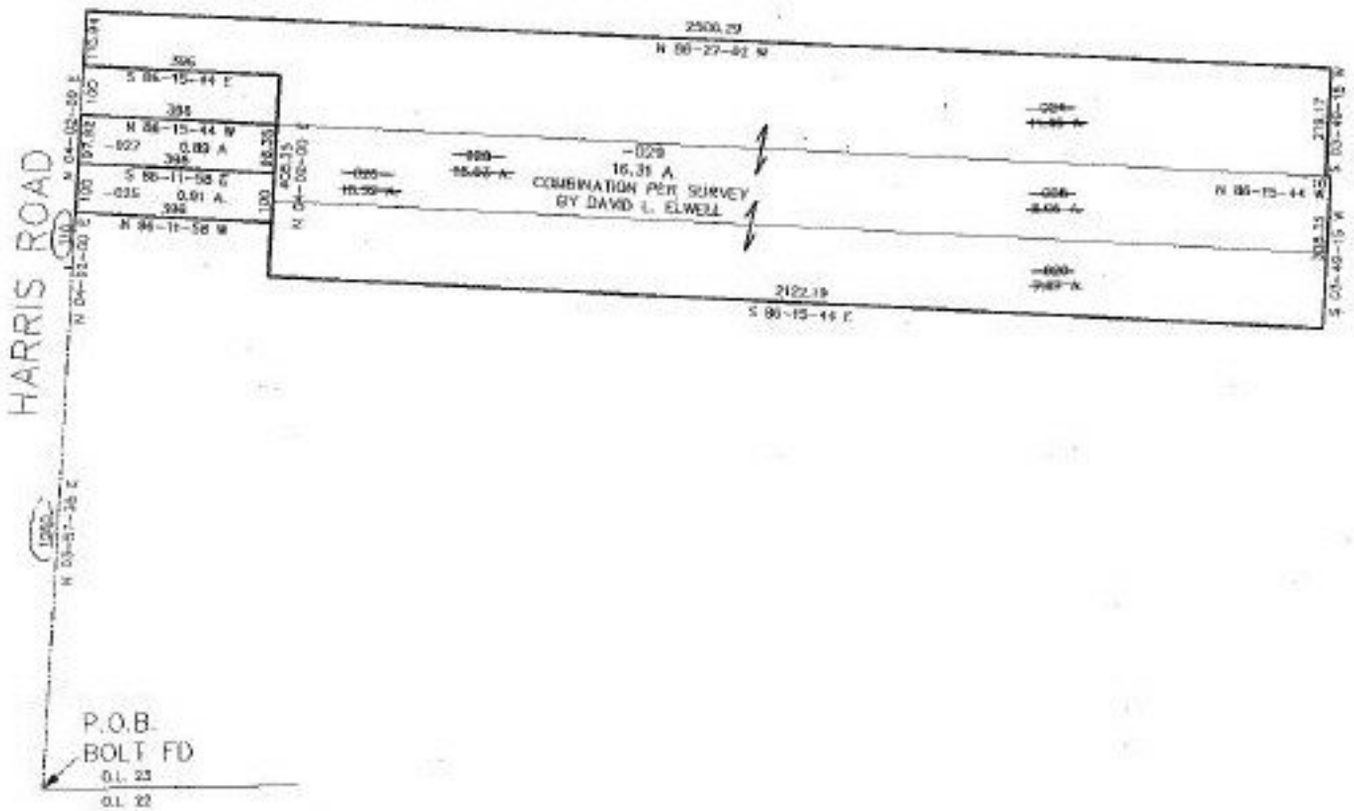

SPLITS/DEEDS PROCESSED

LORAIN COUNTY TAX MAP DEPARTMENT

226 MIDDLE AVE. ELYRIA, OHIO

SURVEYED BY: DAVID L. ELWELL

CLOSURE: 0.00 : 10,000

MAP PAGE(S): 03-00-023A & B

APPROVED BY: REB DATE: 03/25/97

SCALE: 1" = 400