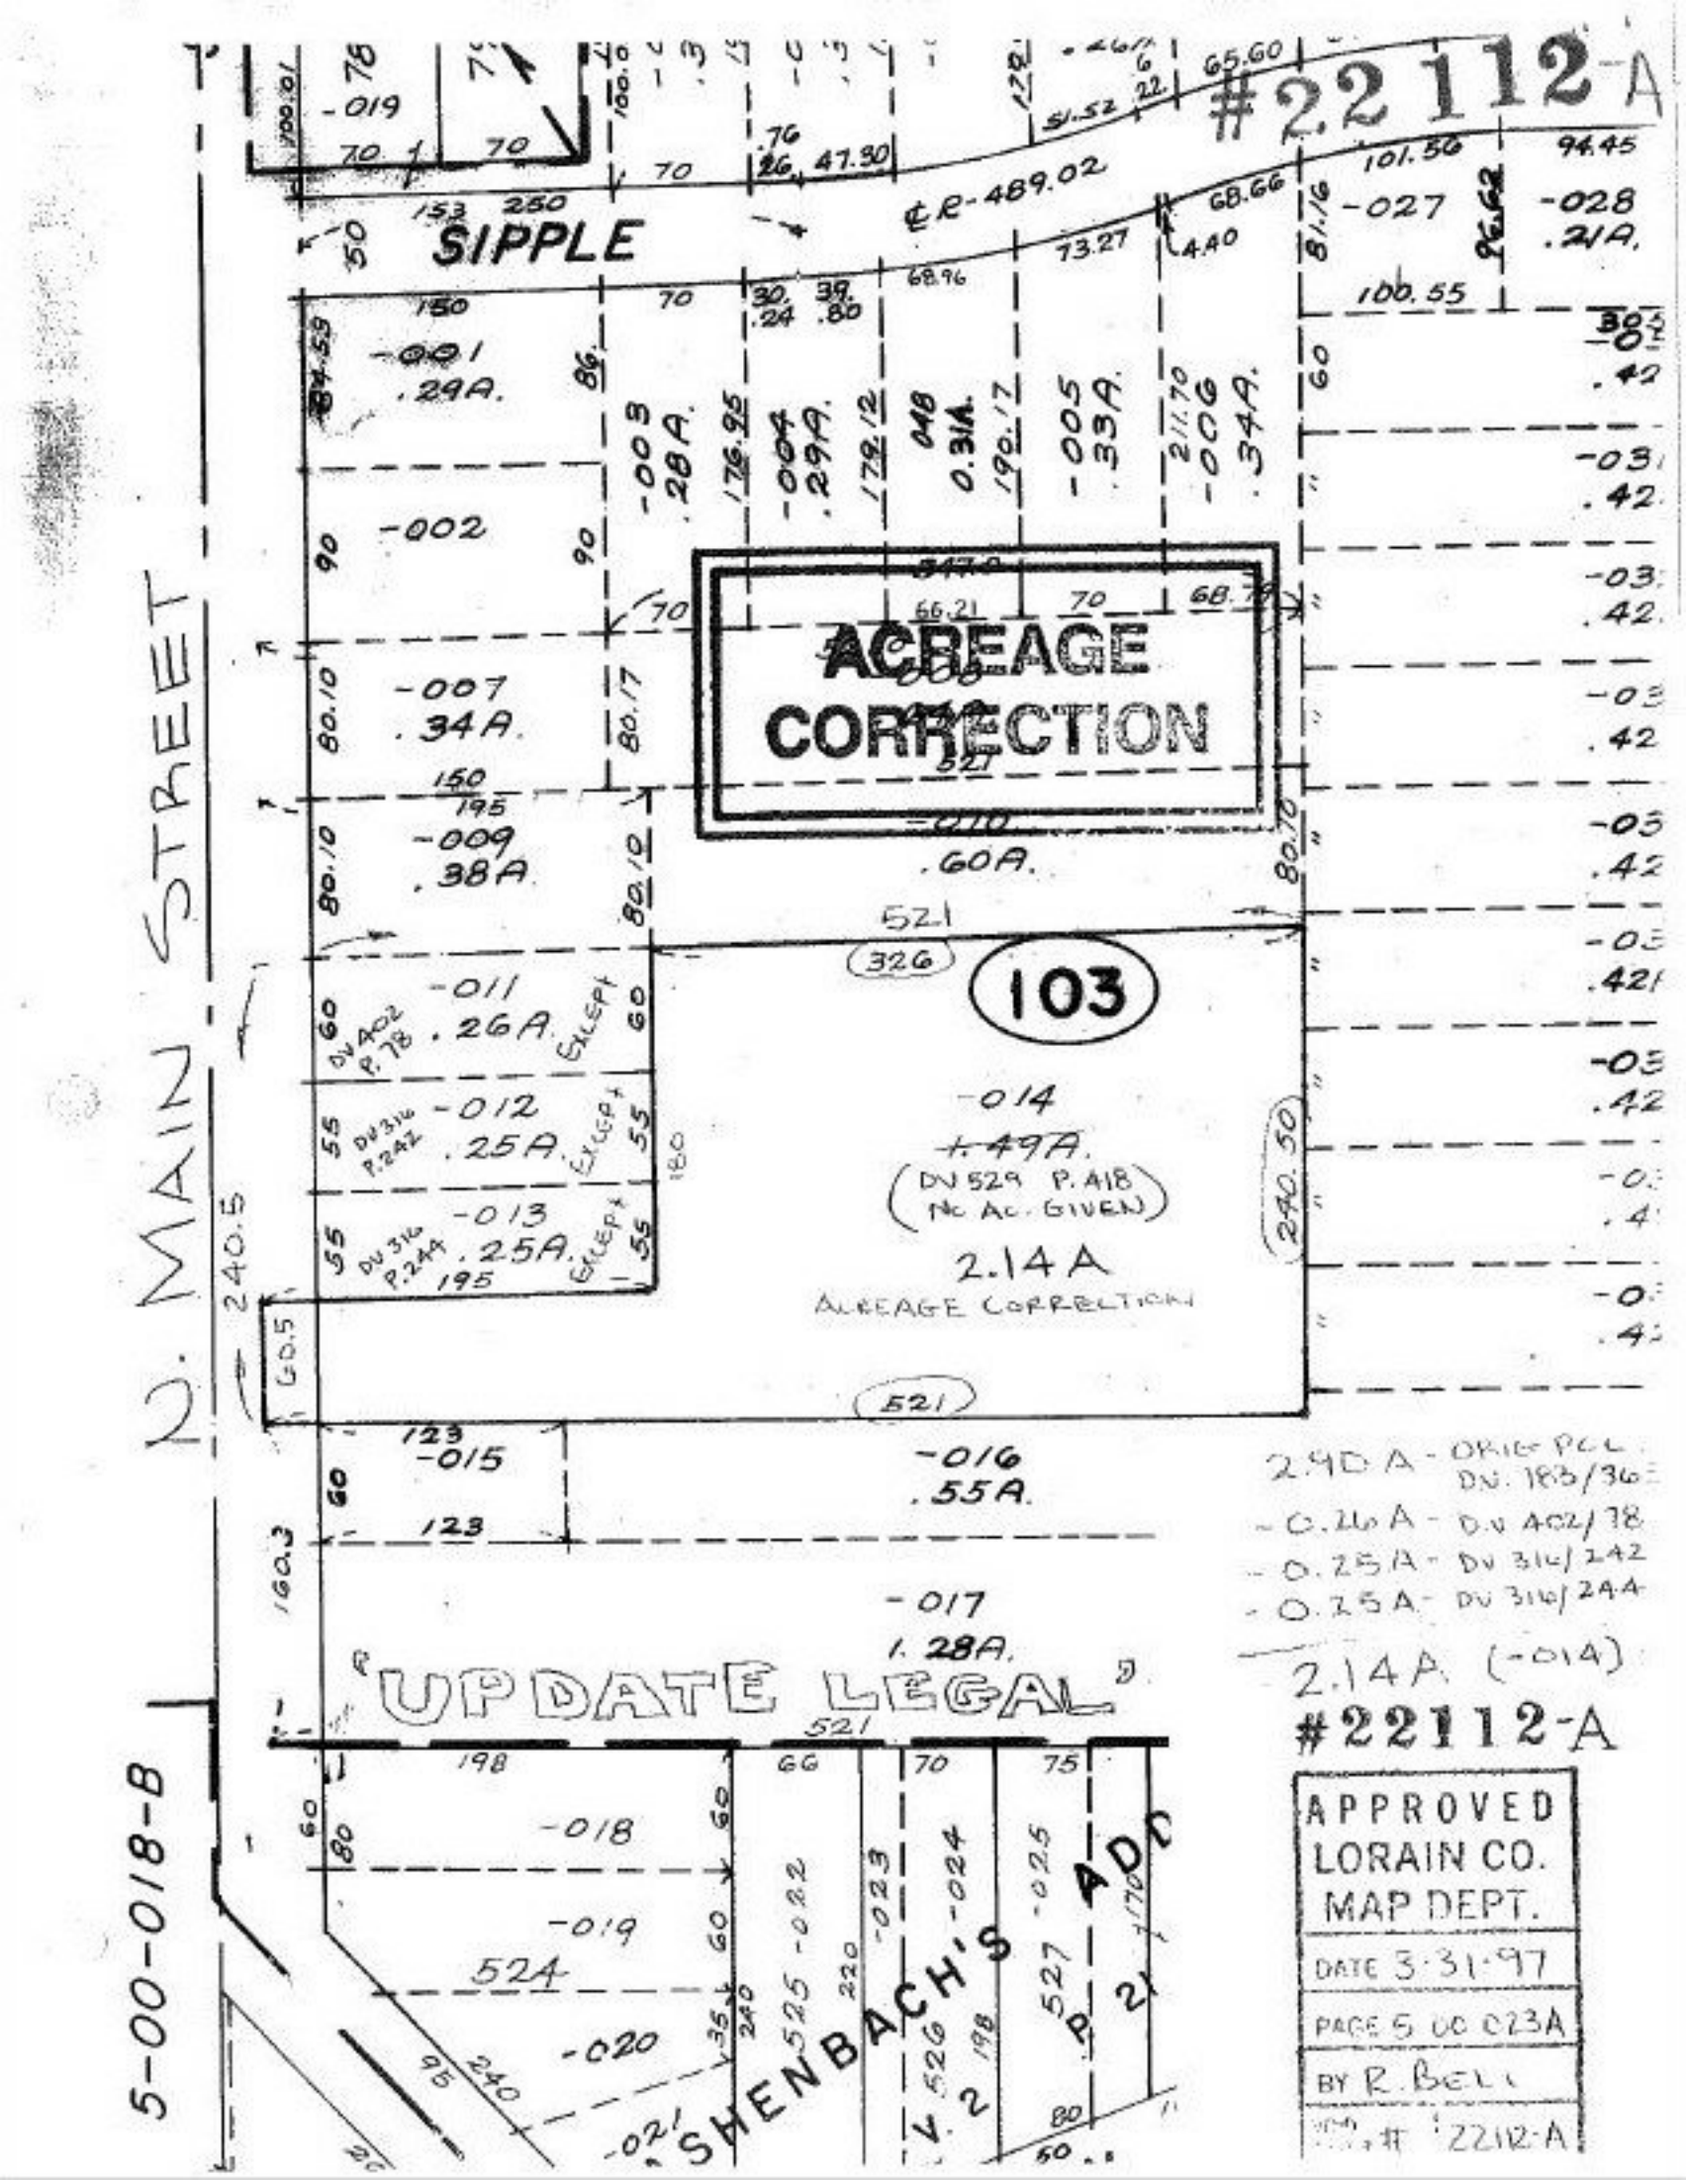
#22112-A
SIPPLE
N. MAIN STREET
ACREAGE CORRECTION
103
-001 .29A.
-002
-003 .28A.
-004 .29A.
-005 .33A.
-006 .34A.
-007 .34A.
-009 .38A.
-010 .60A.
-011 .26A.
-012 .25A.
-013 .25A.
-014 +.49A. (DV 529 P. 418 No Ac. GIVEN)
2.14A ACREAGE CORRECTION
-015
-016 .55A.
-017 1.28A.
-018
-019
-020
-021
524
525
526
527
"UPDATE LEGAL"
2.90 A - ORIG PCL DV. 183/36
- 0.26 A - DV 402/78
- 0.25 A - DV 316/242
- 0.25 A - DV 316/244
2.14 A (-014)
#22112-A
APPROVED LORAIN CO. MAP DEPT.
DATE 3-31-97
PAGE 5 OF 023A
BY R. BELL
#22112-A
5-00-018-B