#22 124

NO. 22124

PARENT PARCEL: 18-00-027-112-017 & -018

CHILD PARCEL: 18-00-027-112-025 THRU -029

STARTING POINT: IP SET AT THE SW CORNER LOIS H. YAHNKE SAID POINT BEING 195' FROM THE CENTERLINE OF WOODLAND ST.

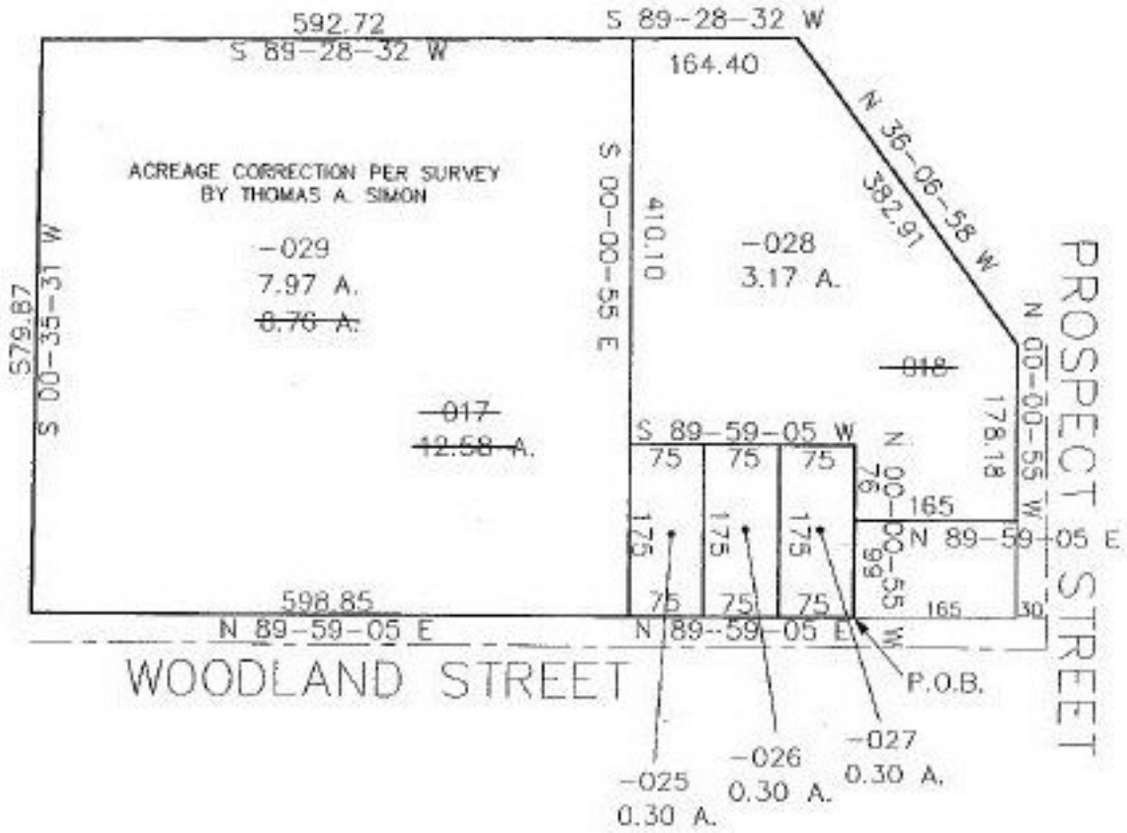

SPLITS/DEEDS PROCESSED

LORAIN COUNTY TAX MAP DEPARTMENT
226 MIDDLE AVE. ELYRIA, OHIO

SURVEYED BY: Thomas A. Simon

CLOSURE: 0.05 per 10,000

MAP PAGE(S): 18-00-027-0

APPROVED BY: koc/RFB DATE: 3-28-97

SCALE: 1" = 200'