PARENT PARCEL: 05-00-087-000-051,032,033,023,042,024,043,026,045

CHILD PARCEL: 05-00-057-000-055 THRU -065

STARTING POINT: cL Elyria-Milon Rd. & cL West Ridge Rd.

#82135 NO. 22135

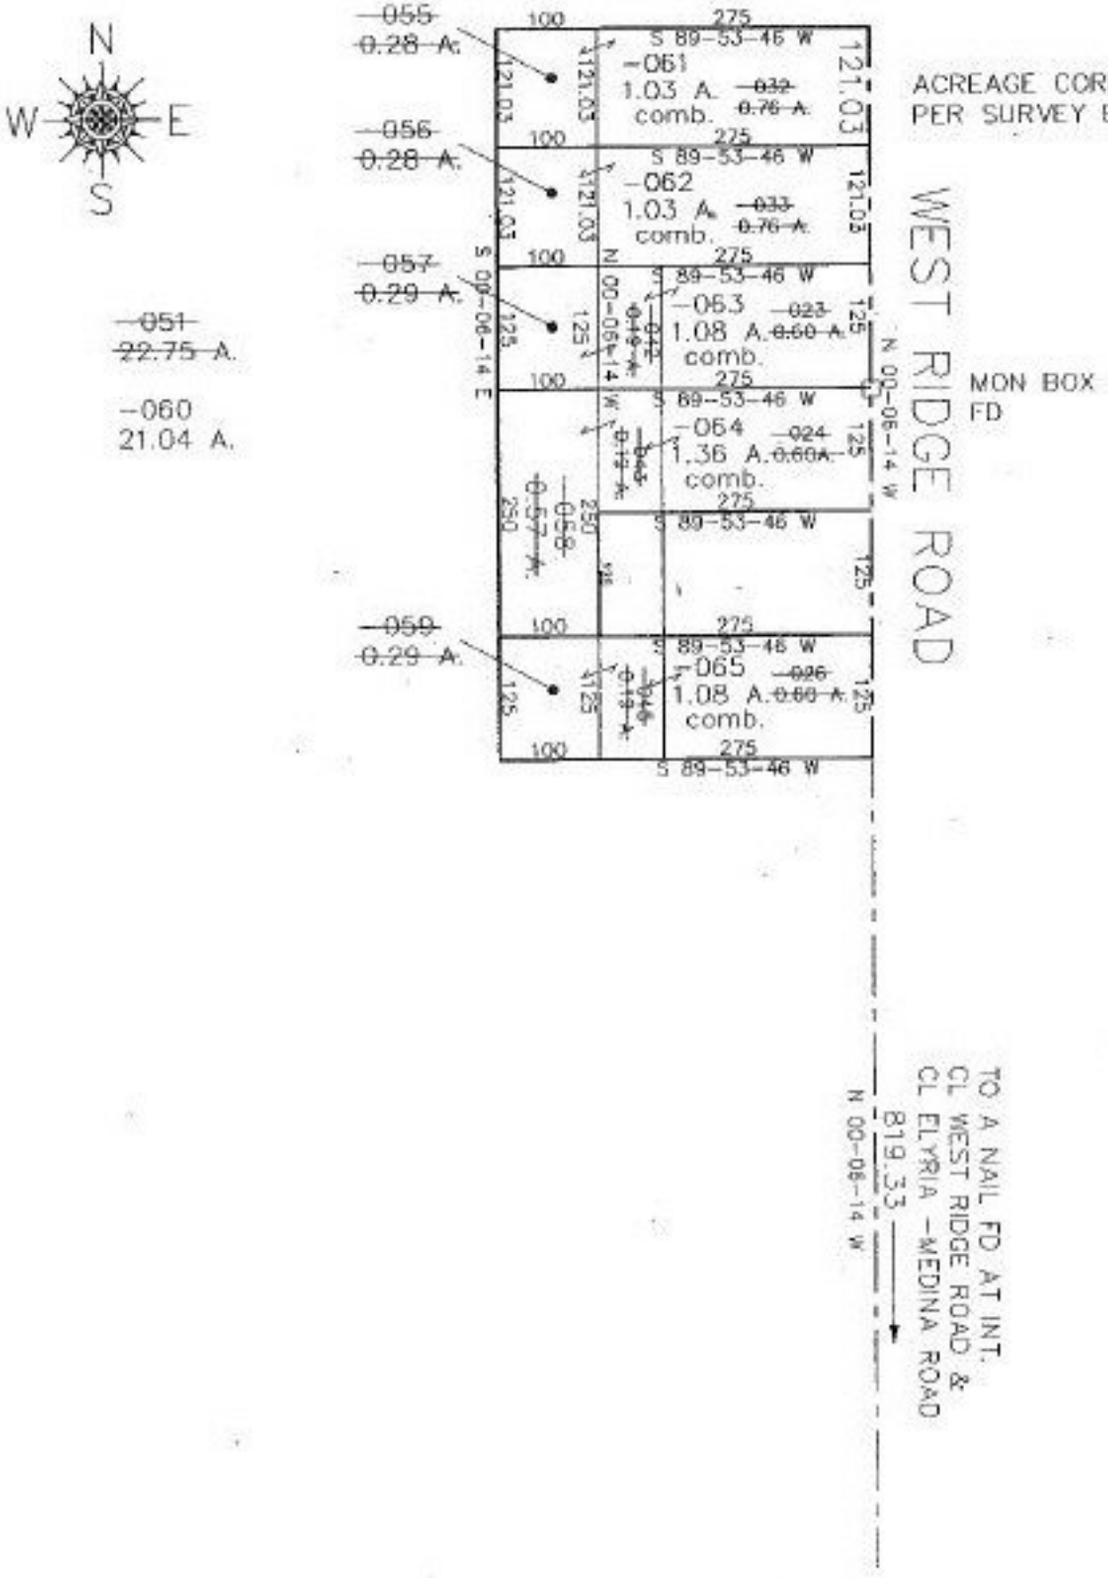

ACREAGE CORRECTION & COMBINATION PER SURVEY BY DOUG MOSLEY

SPLITS/DEEDS PROCESSED

LORAIN COUNTY TAX MAP DEPARTMENT
226 MIDDLE AVE. ELYRIA, OHIO

SURVEYED BY: Doug Mosley
CLOSURE: 0.03 : 10,000
MAP PAGE(S): 05-00-087
APPROVED BY: kac/RFB DATE: 4-4-97
SCALE: 1"= 200