


2214

APPROVED
LORAIN CO.
MAP DEPT.
DATE 11/5/68
Pg 6-91
BY R. J. Kelling

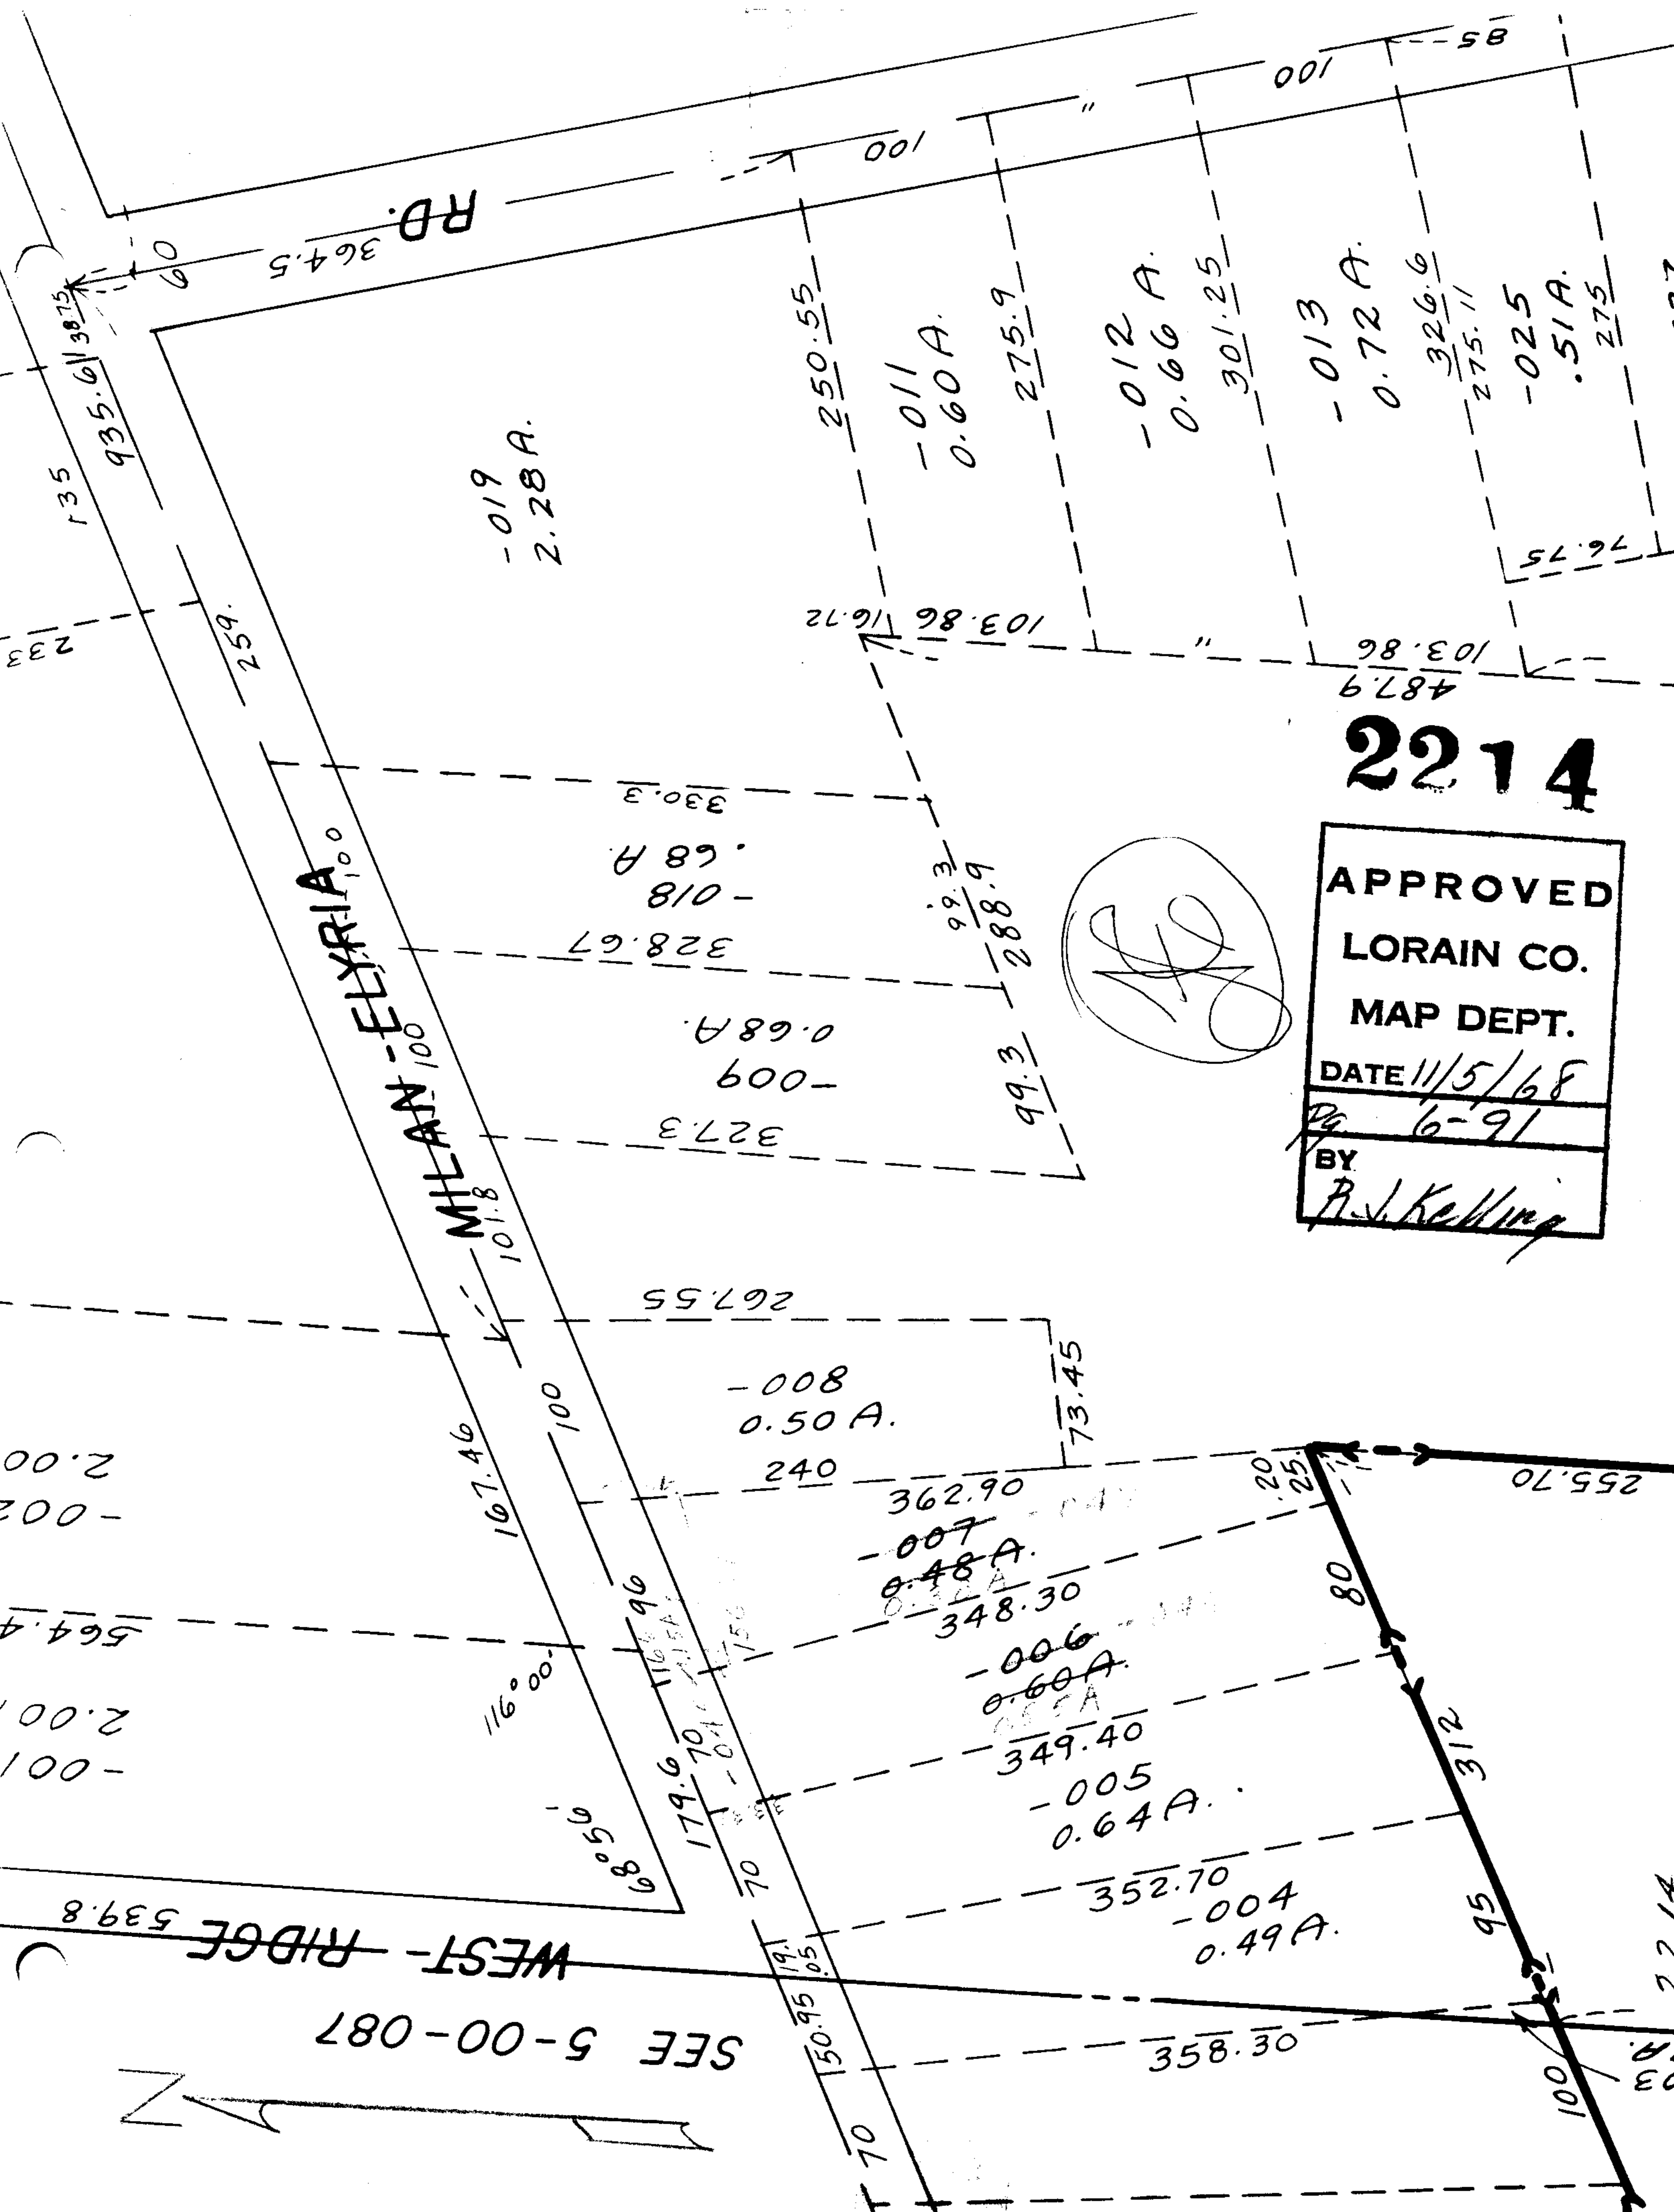

SEE 5-00-087

WEST-RIDGE

MILAN

ELYRIA

RD.

