#22145-X

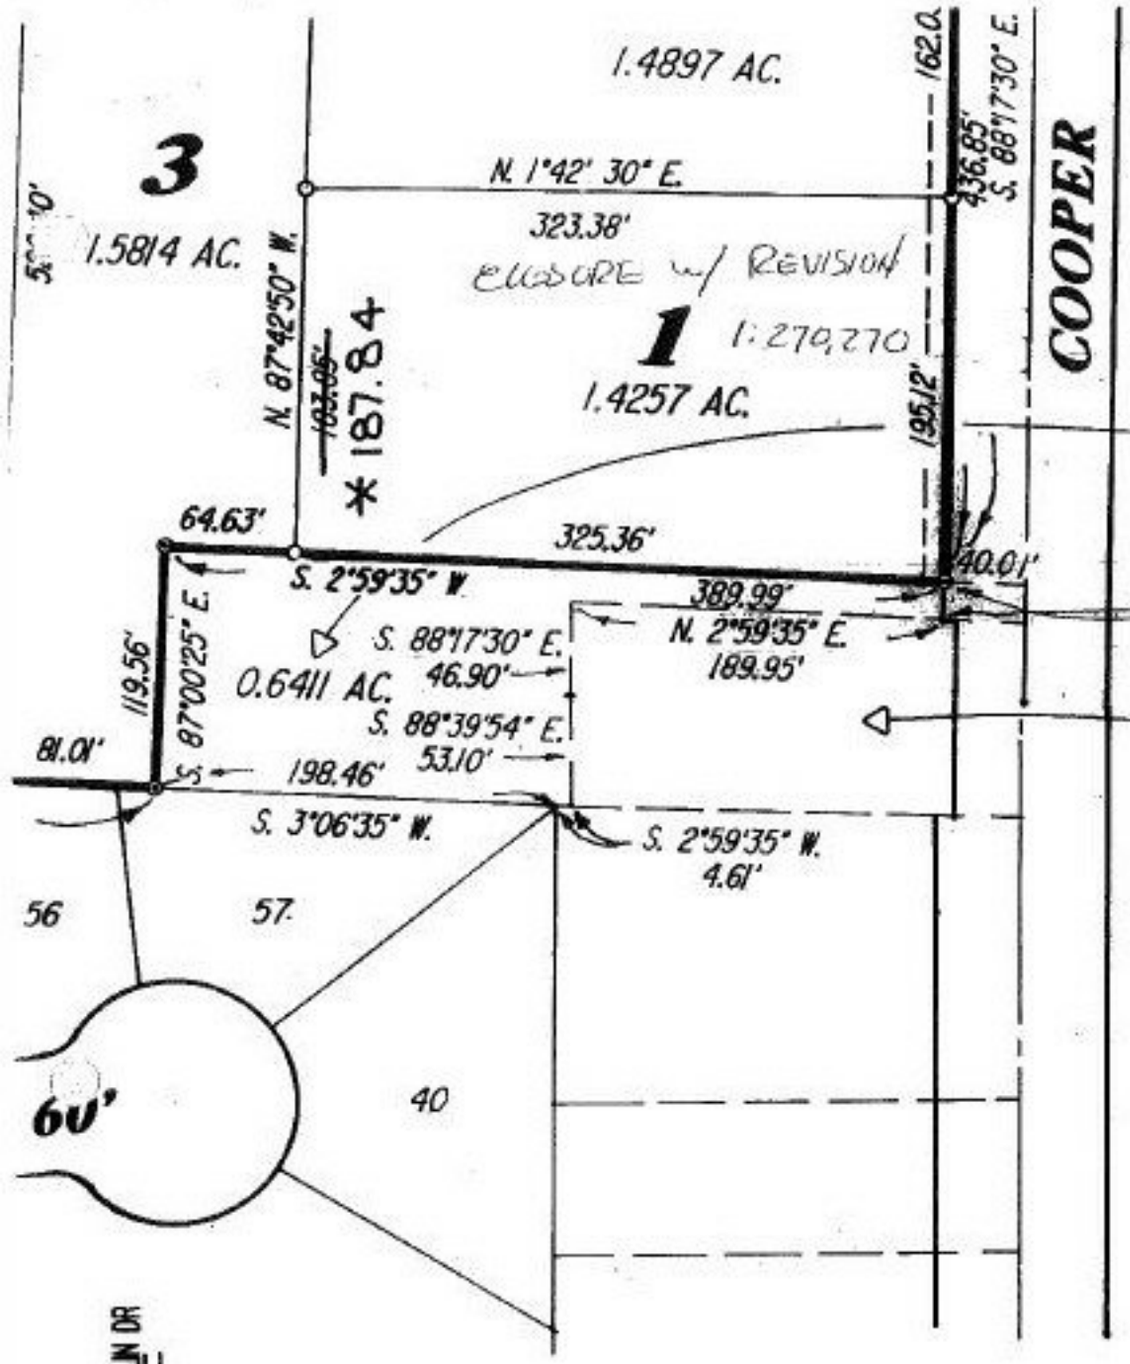

Received for Record APR 29 1994
at 4:02 o'clock P M. in RECORD
VOL 53 MARYANN JAMISON
PAGE 9 Lorain County Recorder
Bond LCTC L.M.
43.20

TRANSFERRED
IN COMPLIANCE WITH SEC. 319.202
OHIO REV. CODE
APR 29 1994
JULIAN A. PIJOR
LORAIN COUNTY AUDITOR

NOTE:
ALL LOTS WITHIN THE SUBDIVISION SHOWN HEREON SHALL BE REQUIRED TO DETAIN ALL STORMWATER DRAINAGE IN EXCESS OF 0.4 CUBIC FEET PER SECOND PER ACRE (BASED ON A 5 YEAR STORM FREQUENCY). THE METHOD AND DESIGN OF STORMWATER DETENTION SHALL BE SUBMITTED TO THE CITY OF AMHERST ENGINEER FOR APPROVAL PRIOR TO ANY CONSTRUCTION OR THE ISSUANCE OF ANY PERMIT.

#22145-X

APPROVED
LORAIN CO.
MAP DEPT.
DATE 4-16-97
PAGE PV 53 P. 9
BY P. BELL
VOID AFTER # 22145-X

* - CORRECTION PER CERTIFICATE OF CORRECTION RECORDED IN O.R.V. 904 P. 83

SCALE