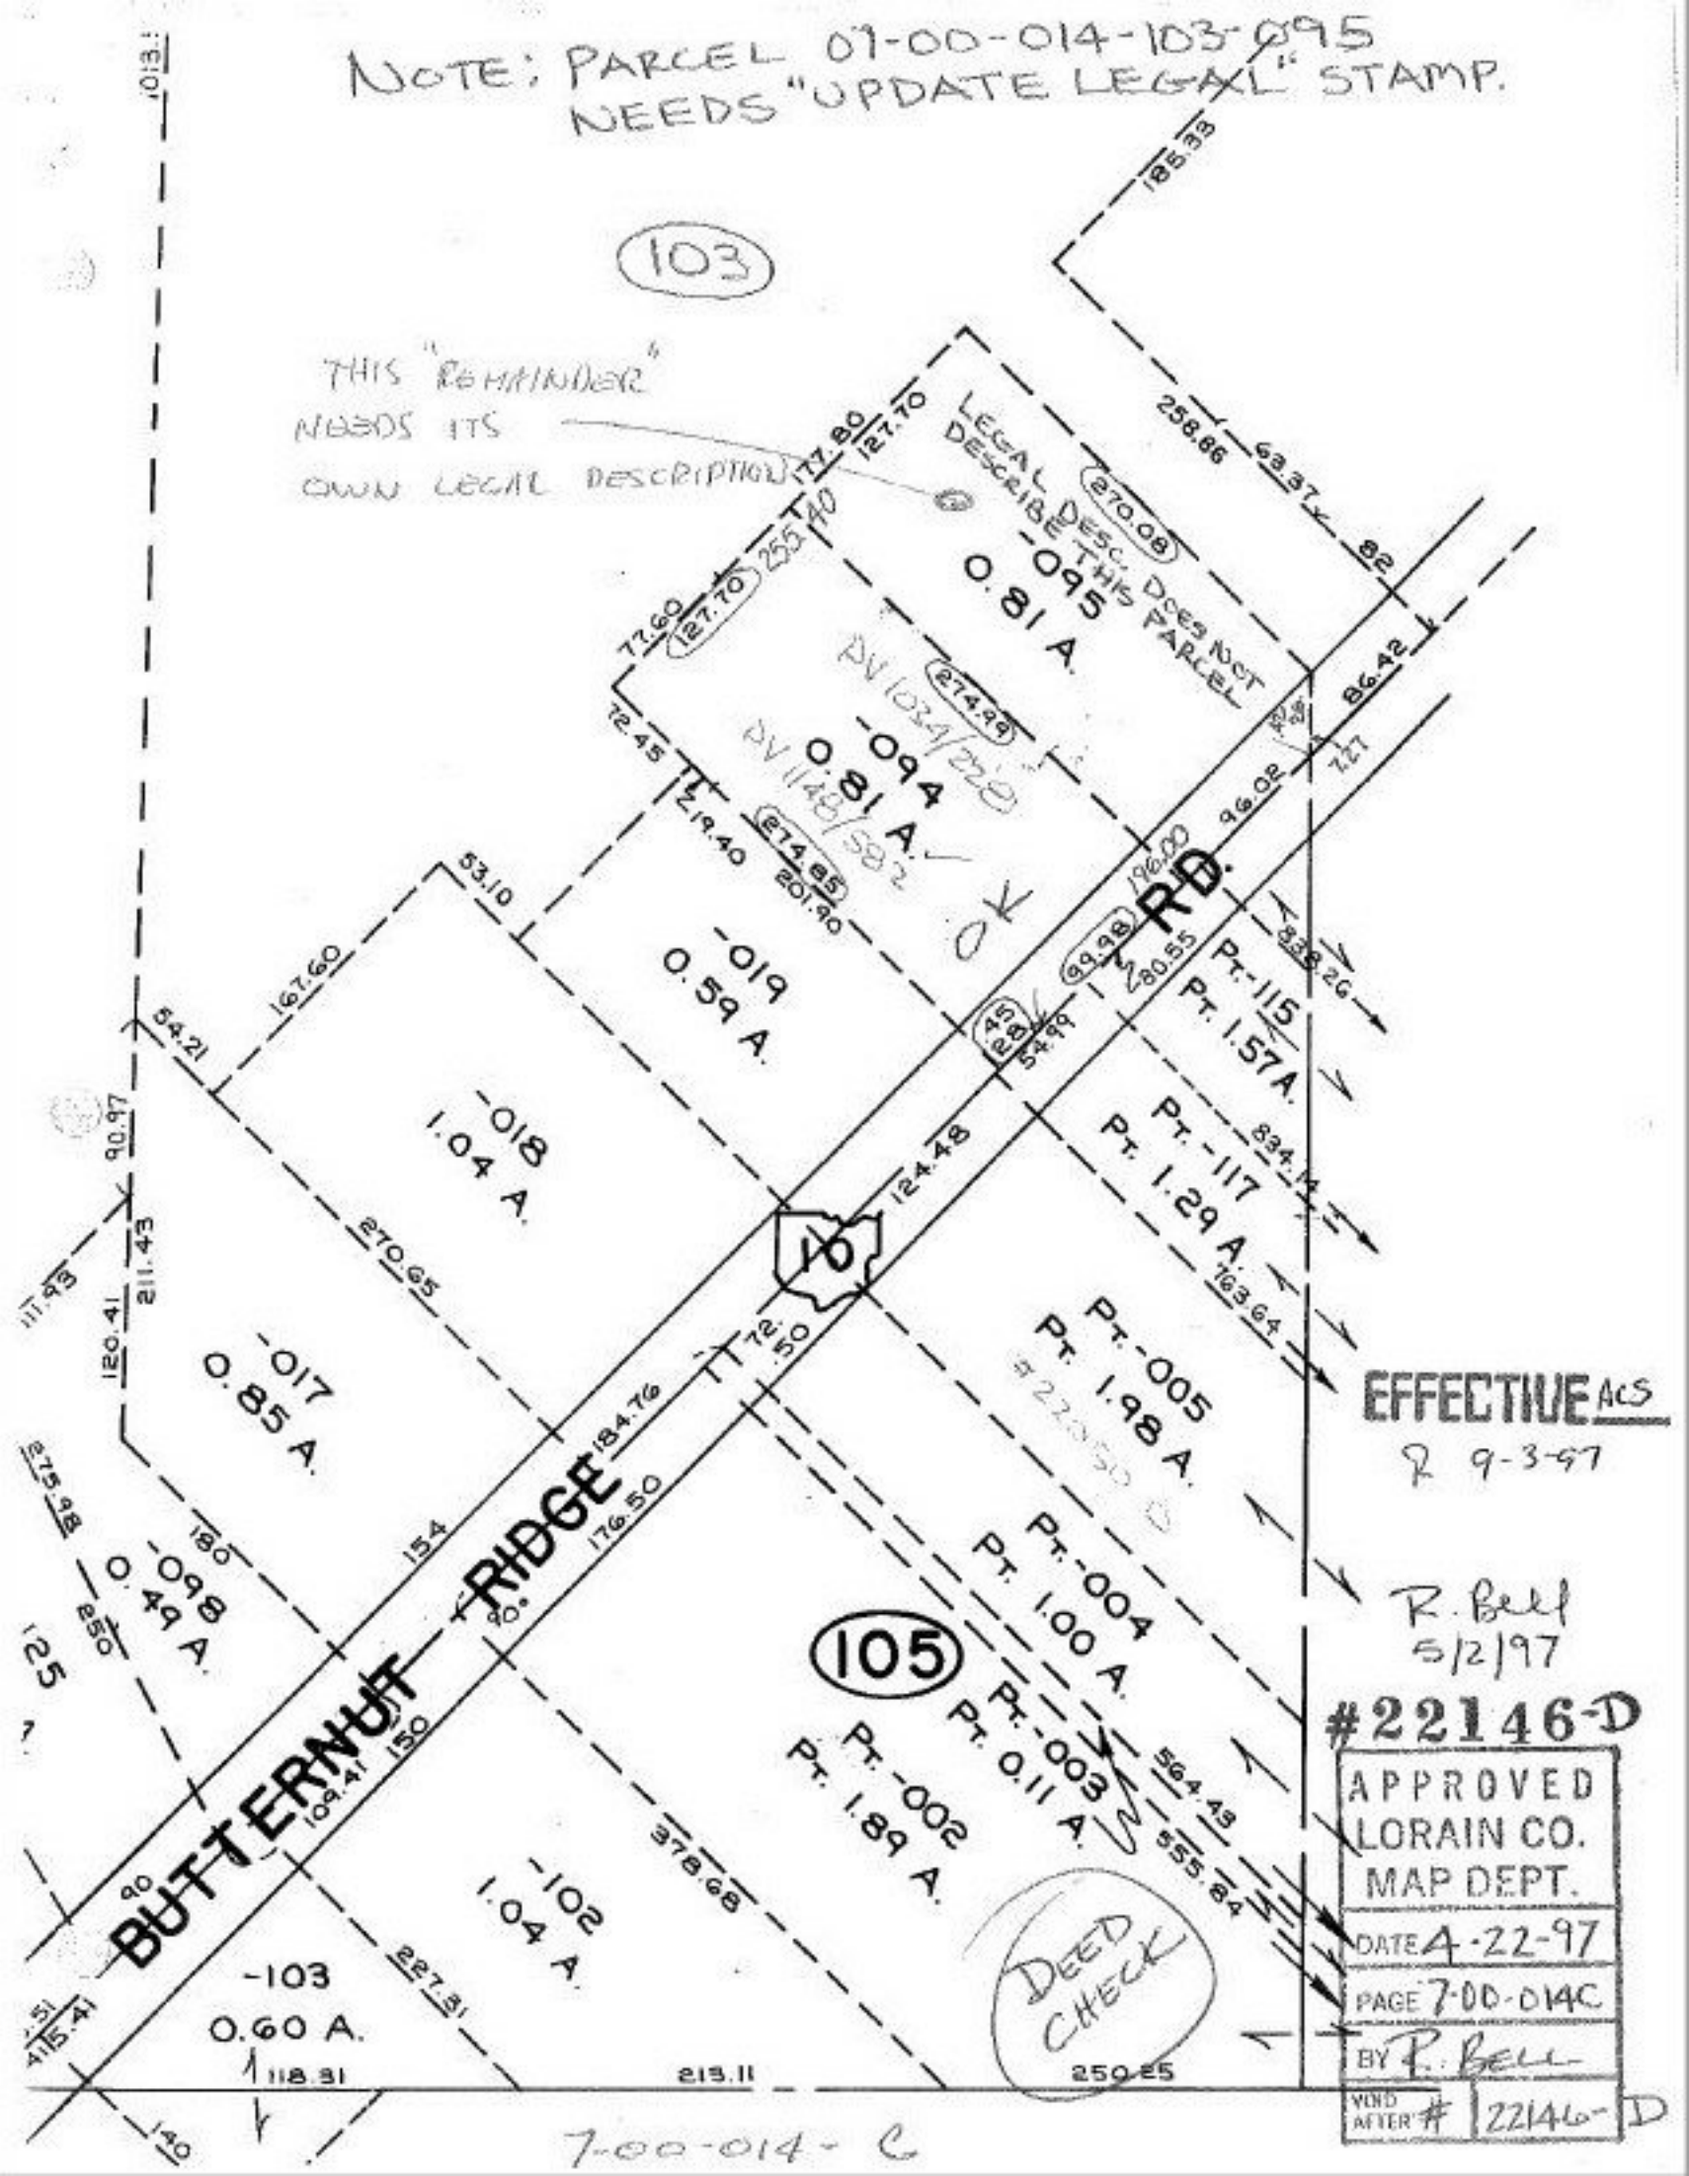
NOTE; PARCEL 07-00-014-103.095
NEEDS "UPDATE LEGAL" STAMP.
103
THIS "REMAINDER"
NEEDS ITS
OWN LEGAL DESCRIPTION
LEGAL DESC. DOES NOT DESCRIBE THIS PARCEL
-095
0.81 A.
-094
0.81 A.
PV 1034/228
PV 1148/582
OK
-019
0.59 A.
-018
1.04 A.
-017
0.85 A.
-098
0.49 A.
-103
0.60 A.
-102
1.04 A.
Pt. -115
Pt. 1.57 A.
Pt. -117
Pt. 1.29 A.
Pt. -005
Pt. 1.98 A.
Pt. -004
Pt. 1.00 A.
Pt. -003
Pt. 0.11 A.
Pt. -002
Pt. 1.89 A.
105
RD.
BUTTERNUT RIDGE
10
DEED CHECK
EFFECTIVE ACS
9-3-97
R. Bell
5/2/97
#22146-D
APPROVED
LORAIN CO.
MAP DEPT.
DATE 4-22-97
PAGE 7-00-014C
BY R. Bell
VOID AFTER # 22146-D
7-00-014-C