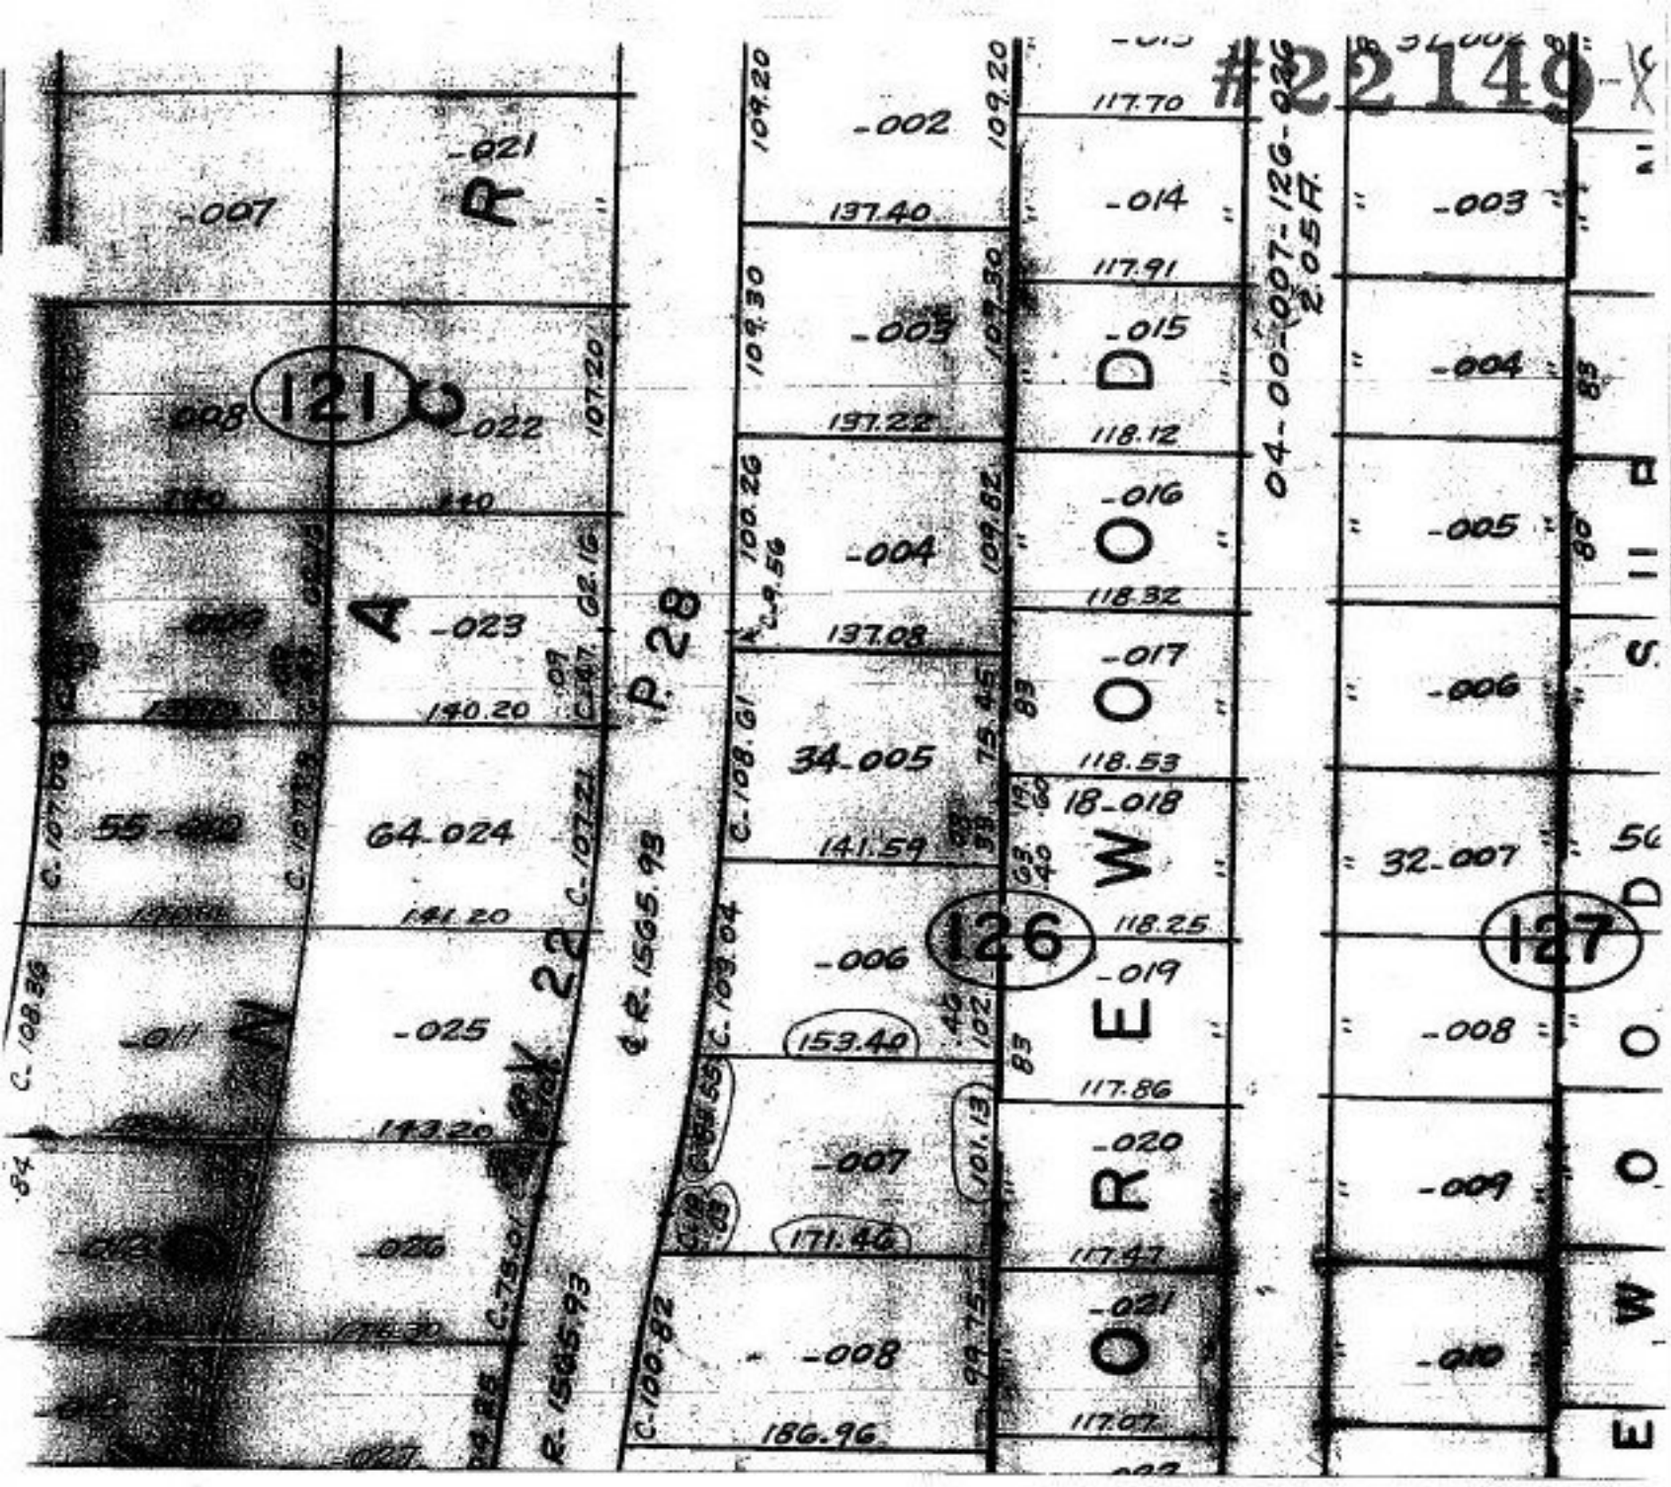

NO CHANGES OF TAX MAP

#22149-X

APPROVED
LORAIN CO.
MAP DEPT.

DATE 4-24-97

PAGE 4-00-007D

BY R. Bell

VOID AFTER # 22149-X