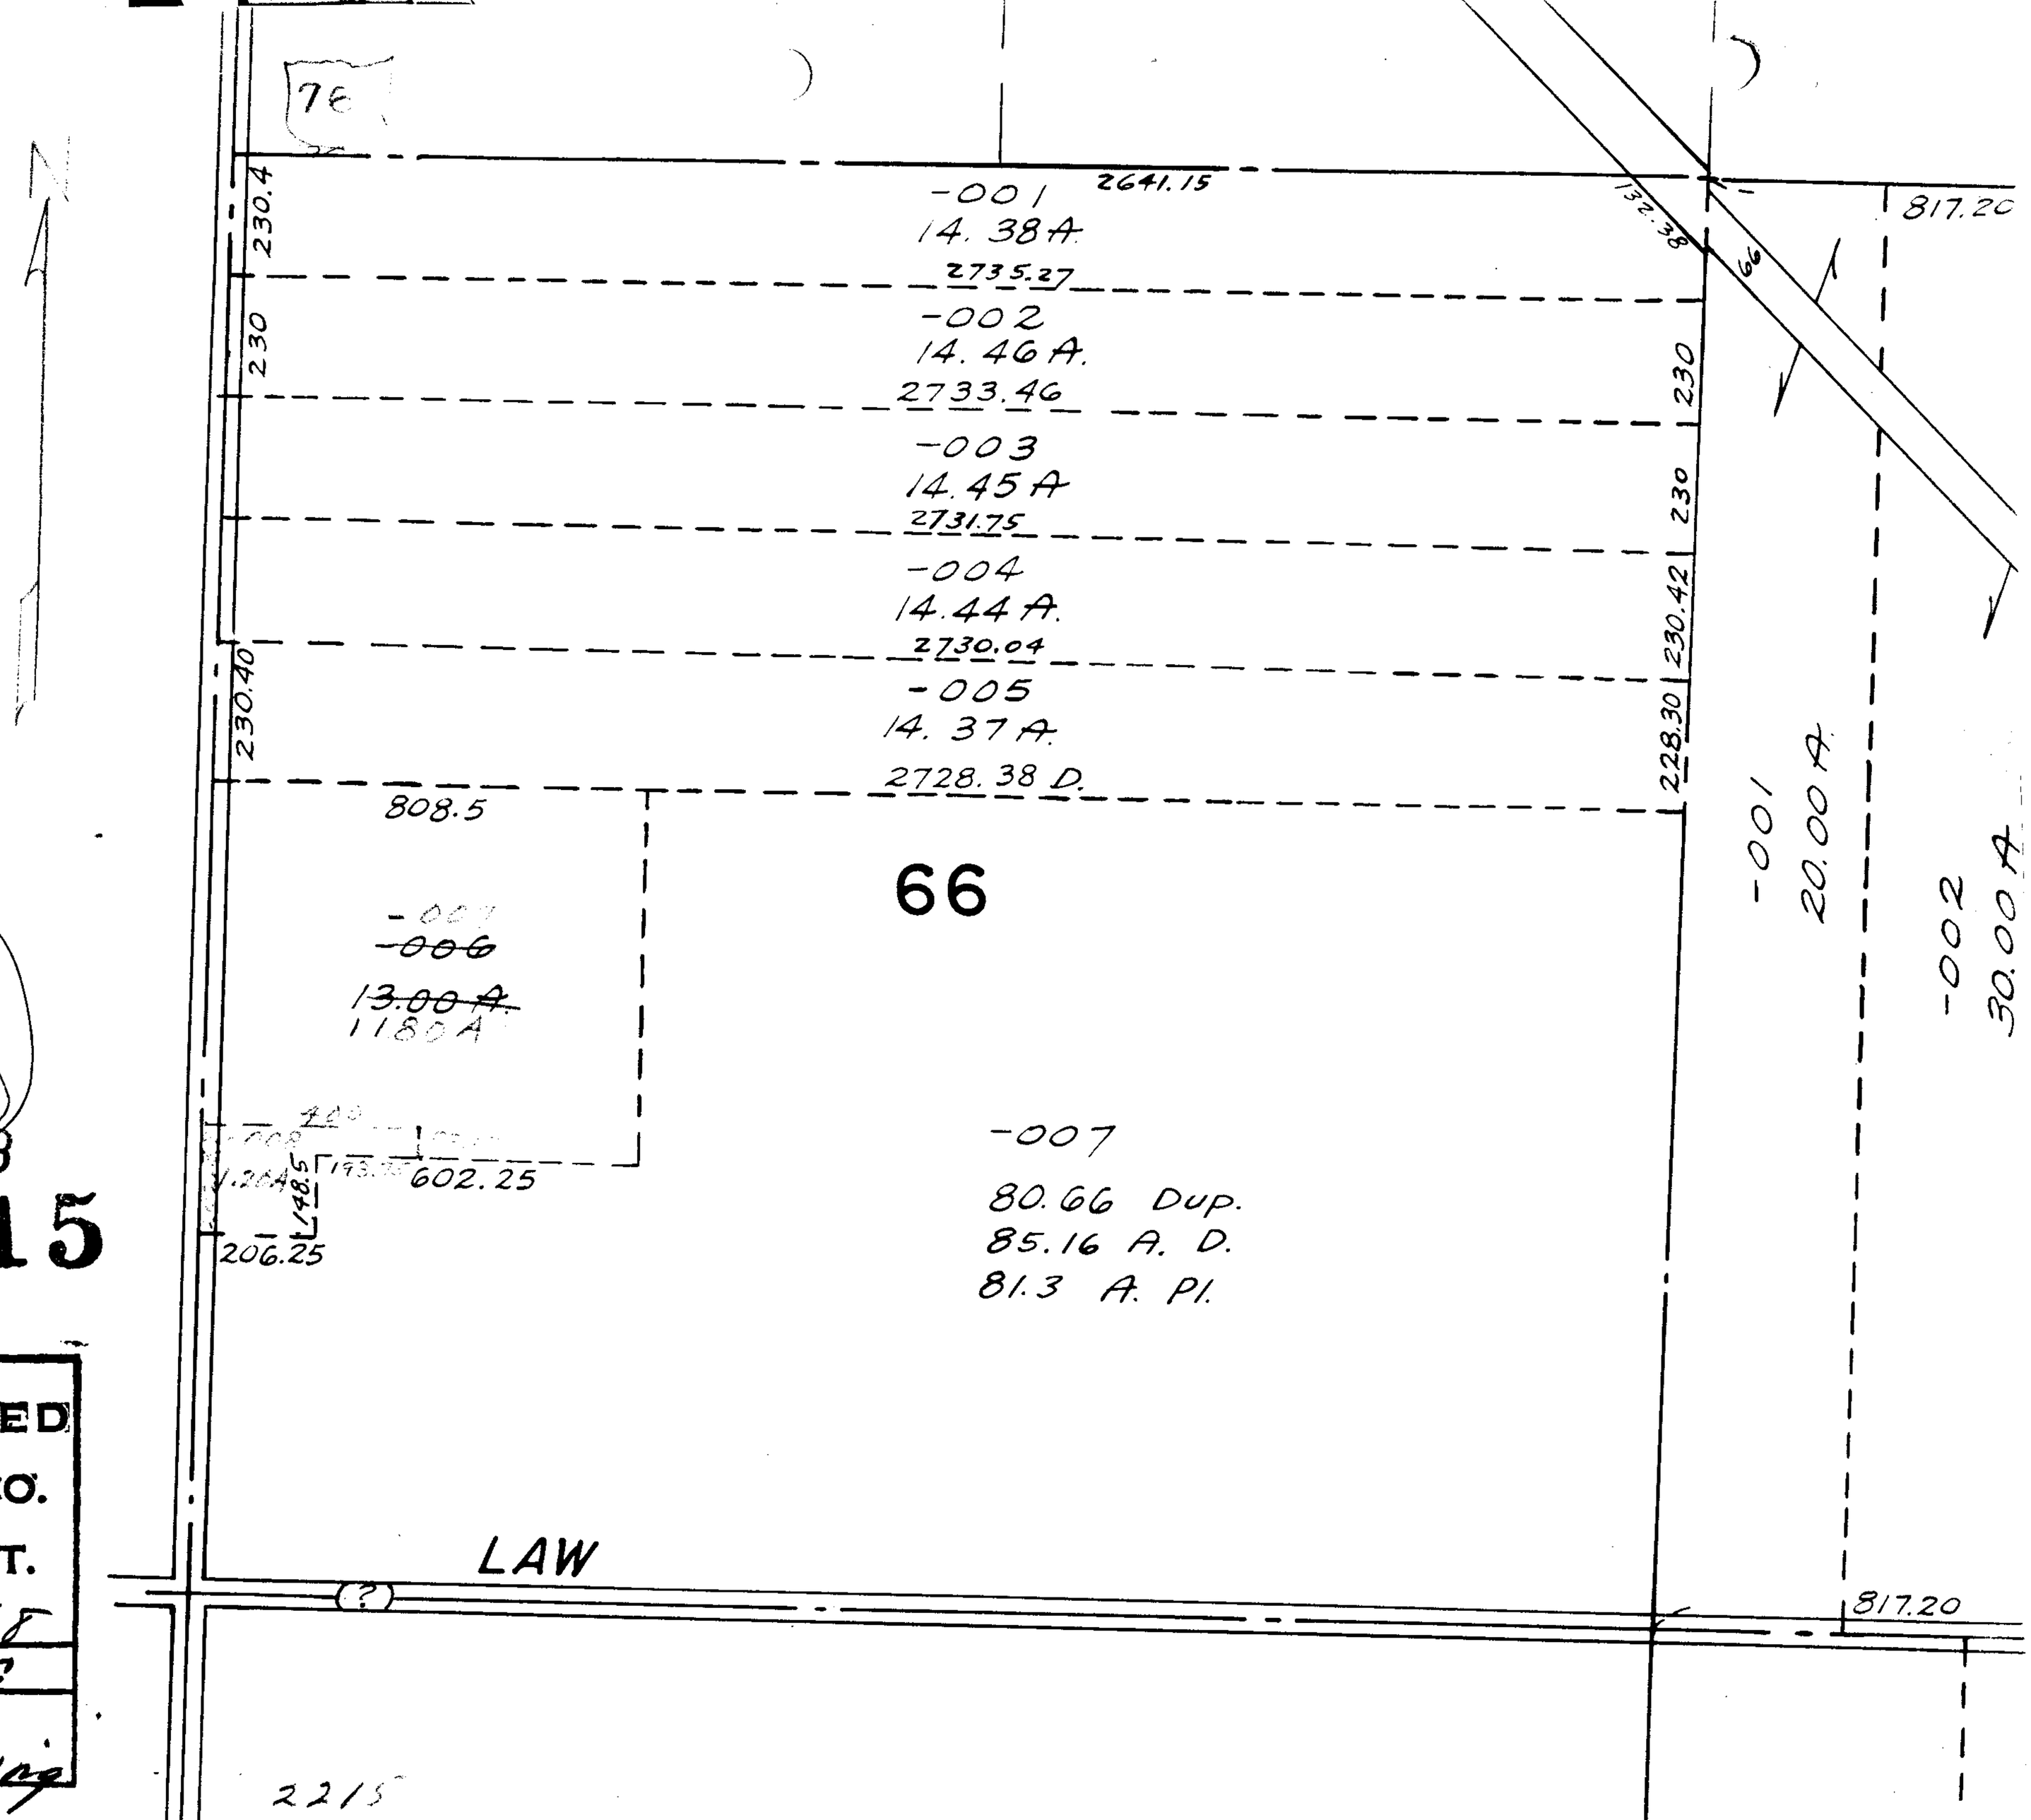

DEC 19 1968

2215

APPROVED
LORAIN CO.
MAP DEPT.
DATE 11/4/68
Pg 16-6
BY
R. J. Kelling

7-25-86 L.L.