#22151-X

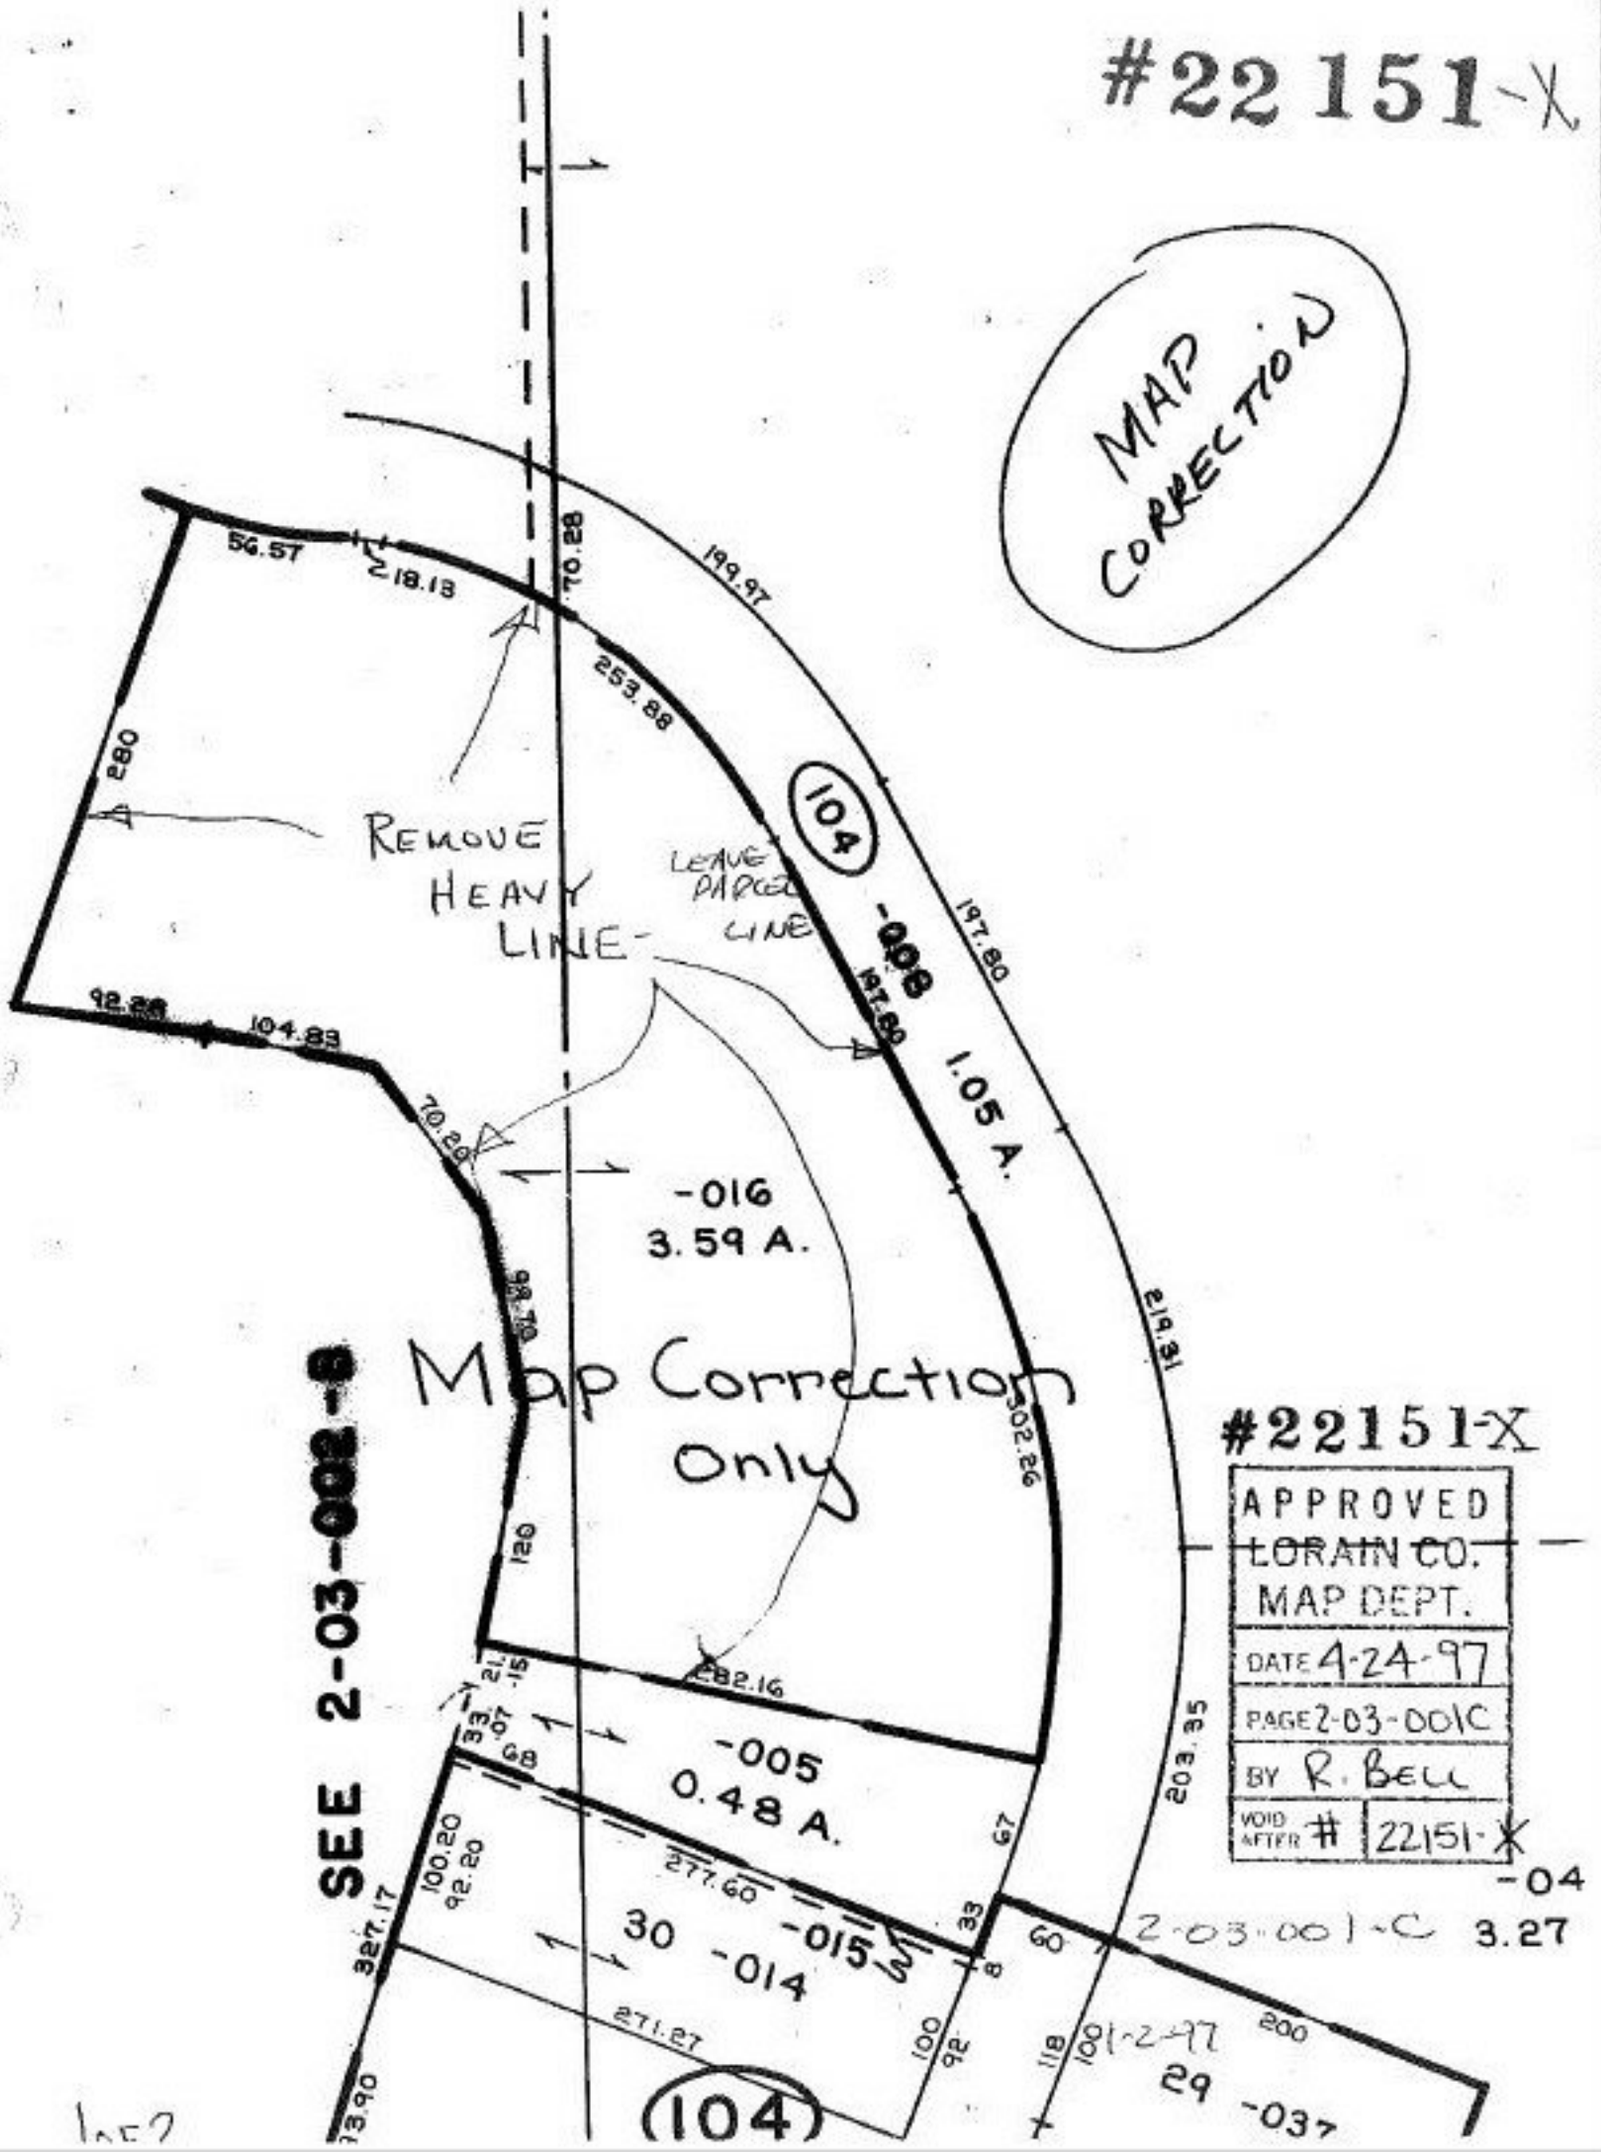
MAP CORRECTION
56.57
218.13
70.28
199.97
253.88
280
REMOVE HEAVY LINE-
LEAVE PARCEL LINE
104
-008
1.05 A.
197.80
197.80
92.26
104.83
70.20
-016
3.59 A.
98.70
Map Correction Only
219.31
302.26
120
382.16
SEE 2-03-002-B
-005
0.48 A.
203.35
327.17
100.20
92.20
277.60
-015
30
-014
271.27
2-03-001-C 3.27
29
-037
(104)
#22151-X
APPROVED
LORAIN CO.
MAP DEPT.
DATE 4-24-97
PAGE 2-03-001C
BY R. Bell
VOID AFTER # 22151-X
-04
1001-2-97