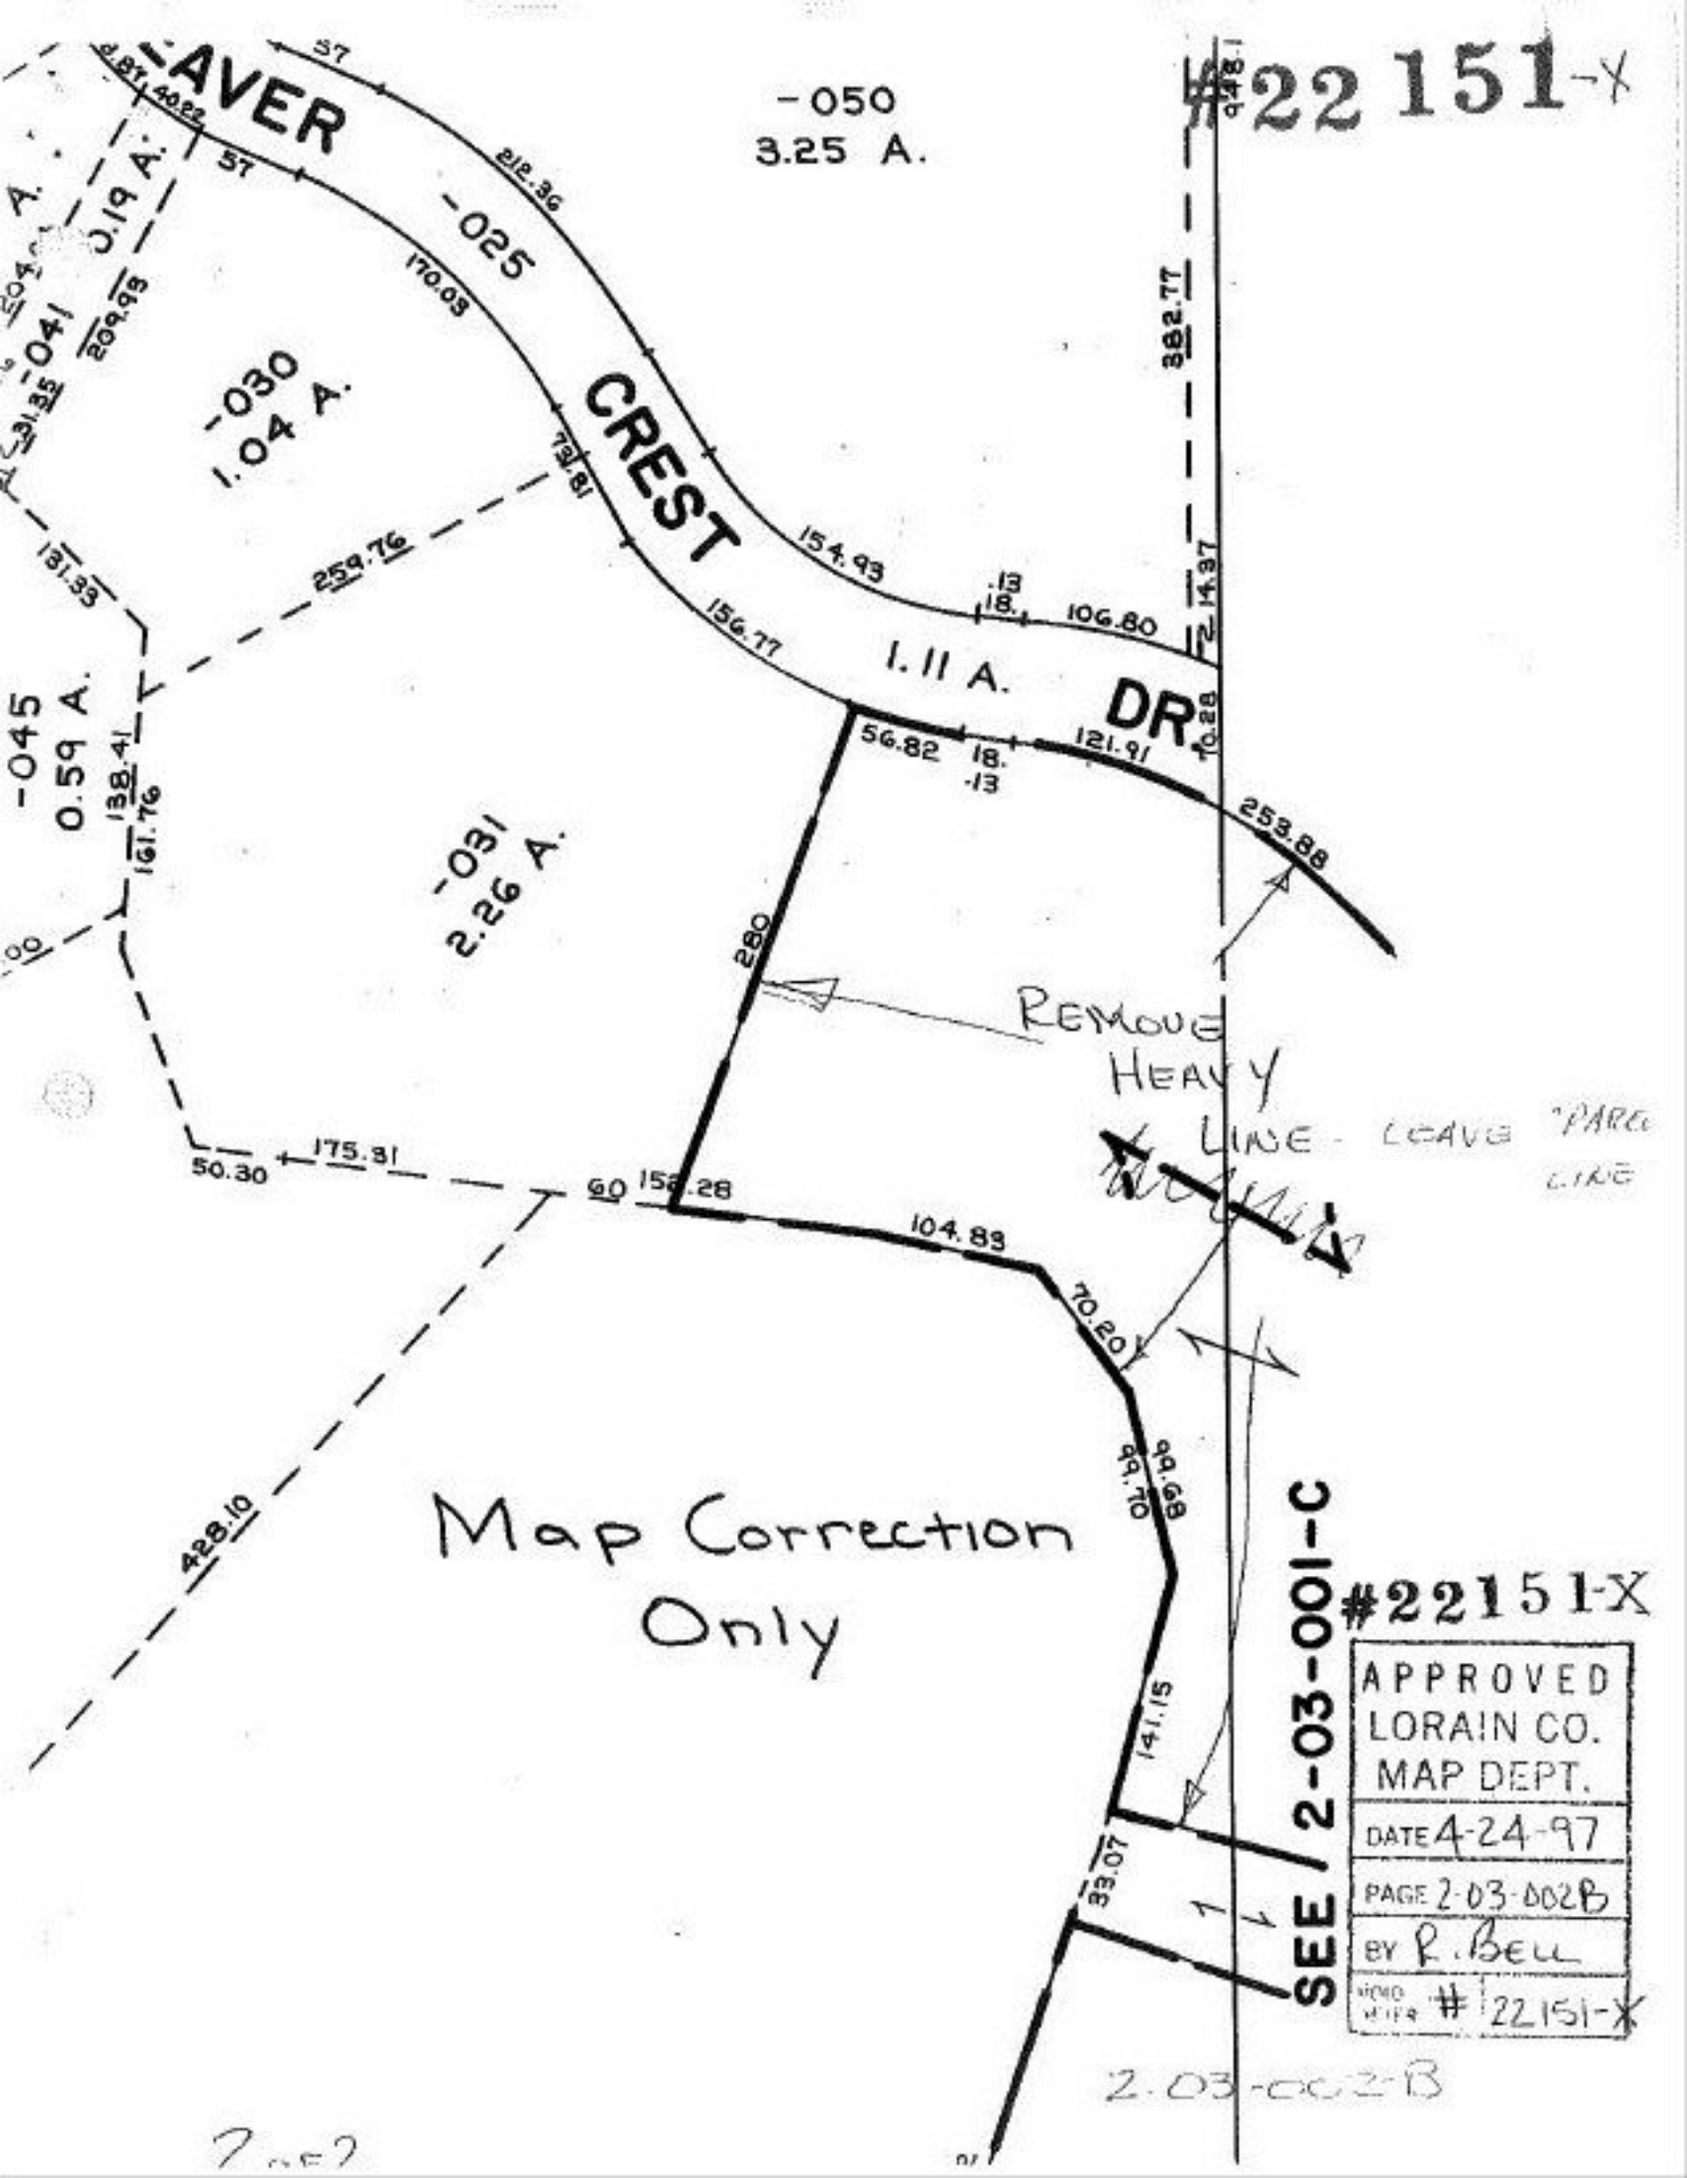
#22151-X
-050
3.25 A.
-025
-030
1.04 A.
-031
2.26 A.
-045
0.59 A.
CREST
DR
1.11 A.
0.19 A.
REMOVE HEAVY LINE - LEAVE "PARC LINE
Map Correction Only
SEE 2-03-001-C
#22151-X
APPROVED
LORAIN CO.
MAP DEPT.
DATE 4-24-97
PAGE 2-03-002B
BY R. BELL
#22151-X
2-03-002B