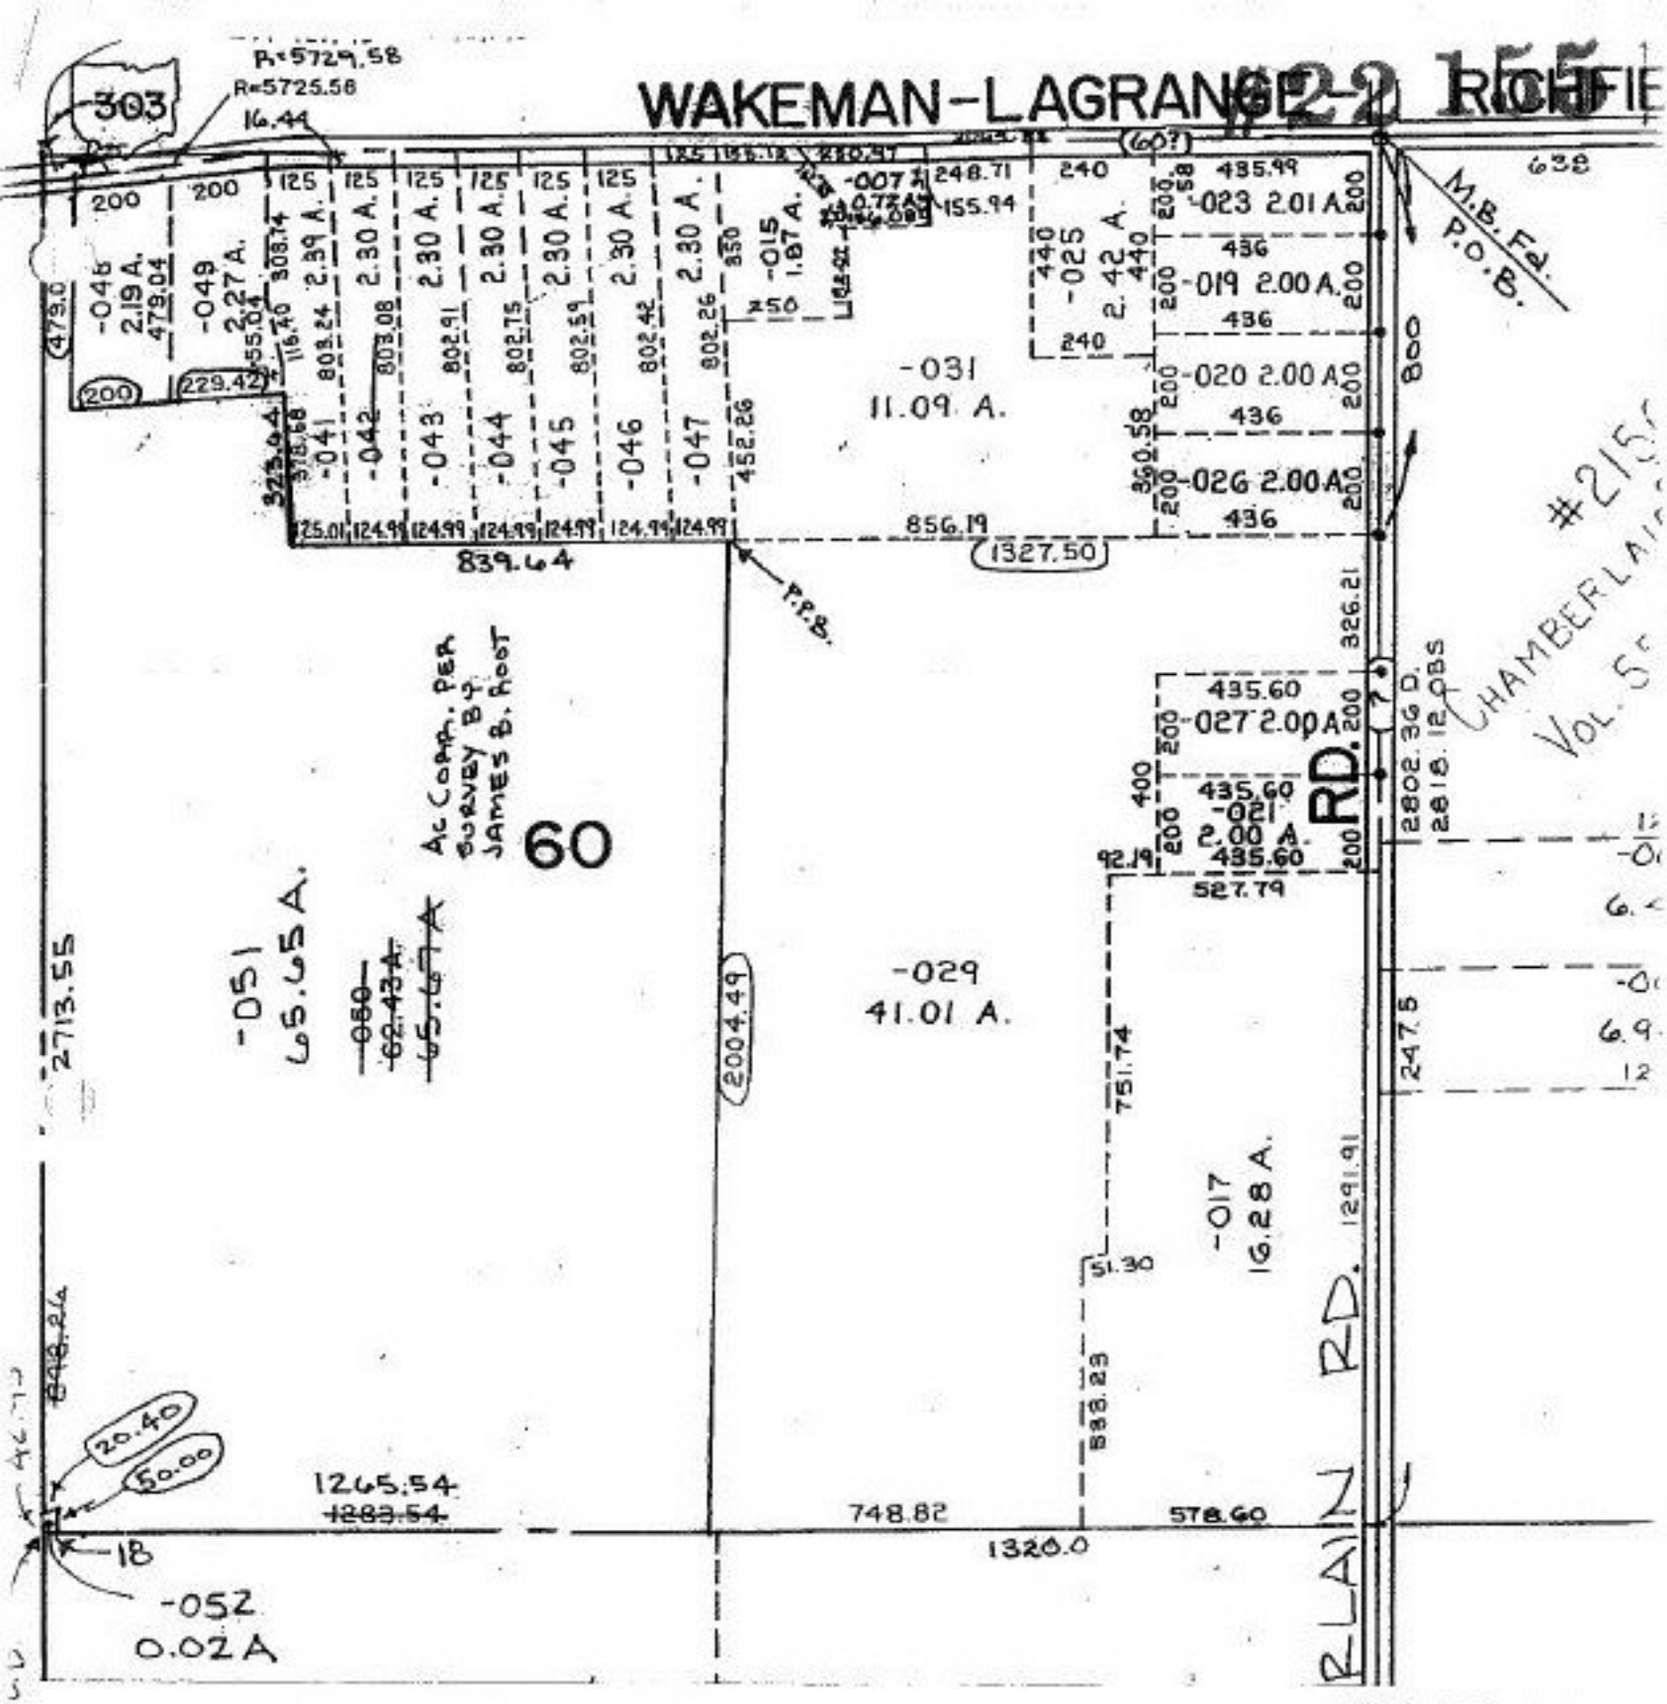

St. Transfer
Map Correction Only

#22155

APPROVED
LORAIN CO.
MAP DEPT.

DATE 4-25-97

PAGE 16-E

BY R. Bell

VOID AFTER # 22155