#22156

PARENT PARCEL: 16-00-015-000-005, 16-00-026-000-006
CHILD PARCEL: 16-00-026-000-034 THRU 037
STARTING POINT: NE CORNER O.L. 26

NO. 22156

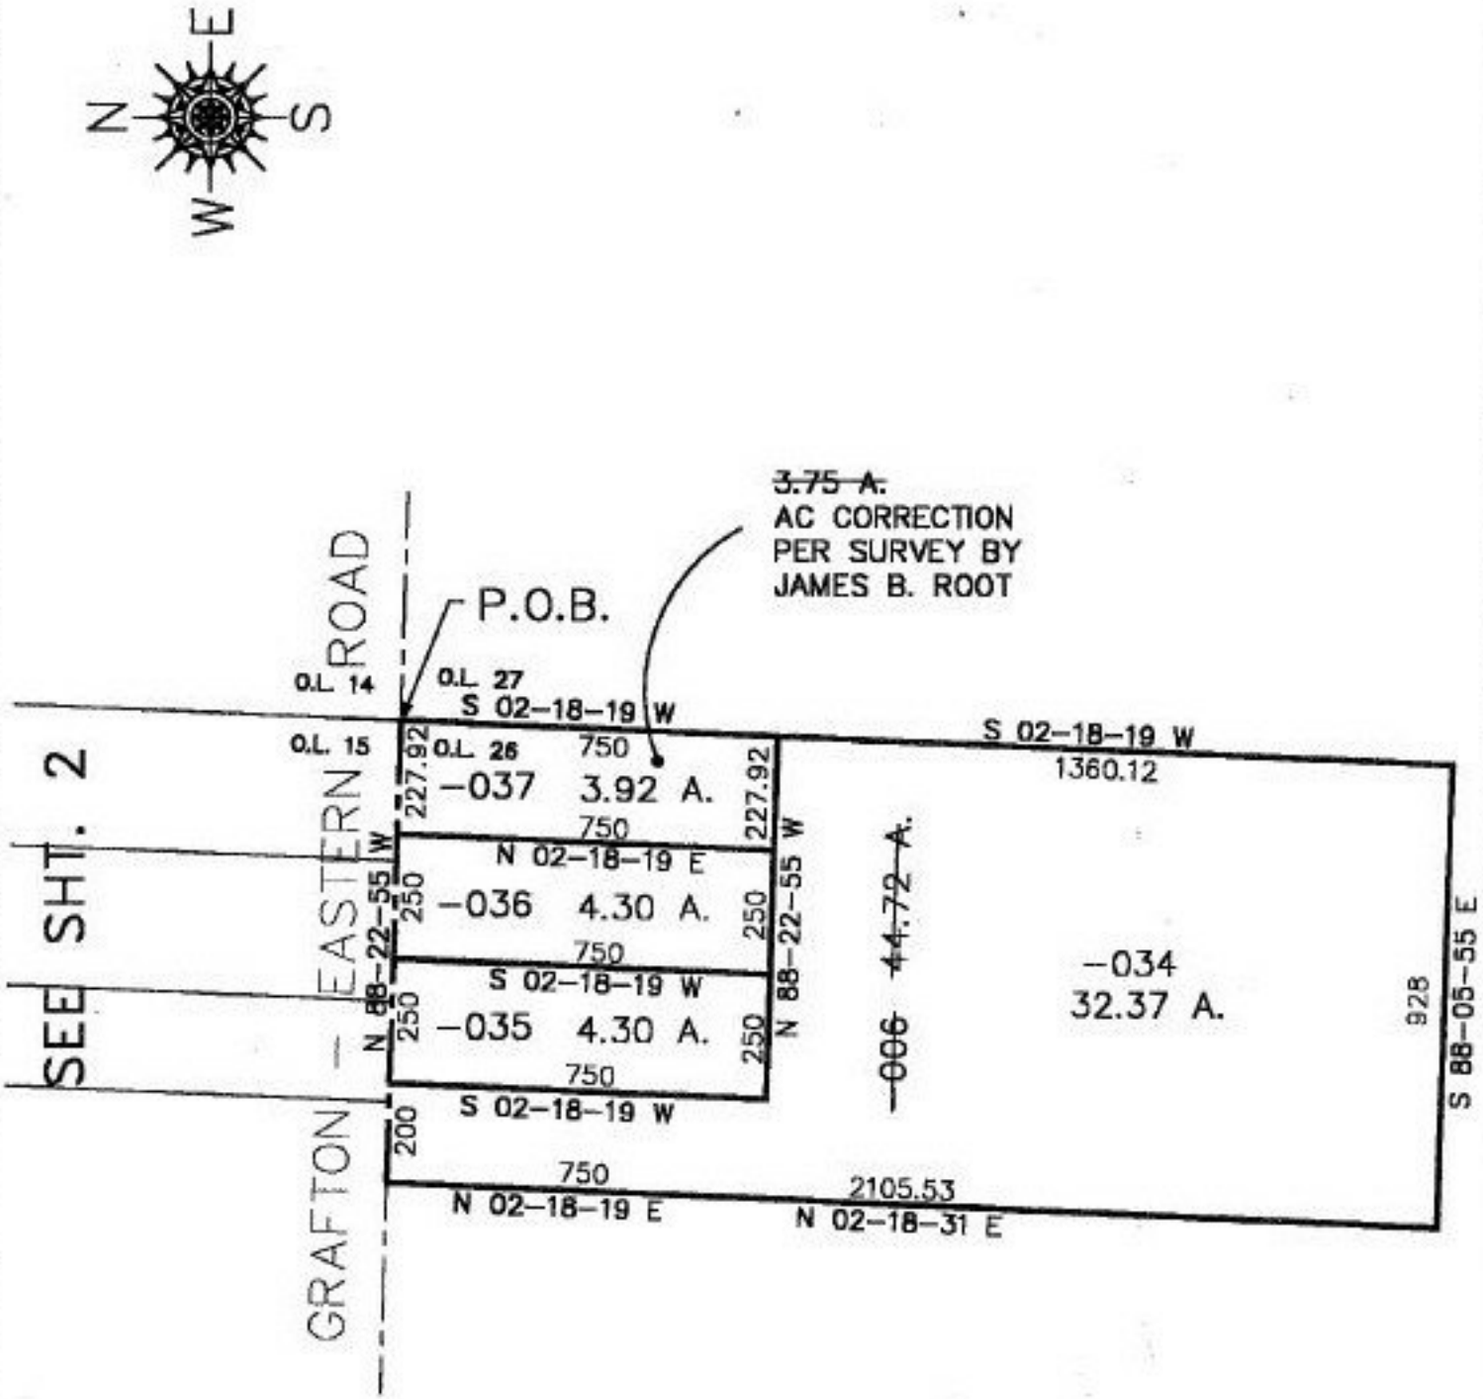

1 OF 2

SPLITS/DEEDS PROCESSED
LORAIN COUNTY TAX MAP DEPARTMENT
226 MIDDLE AVE. ELYRIA, OHIO

SURVEYED BY: JAMES B. ROOT
CLOSURE: 0.00 : 10,000
MAP PAGE(S): 16-00-026 B
APPROVED BY: KAC/RFB DATE: 4/30/97
SCALE: 1" = 400