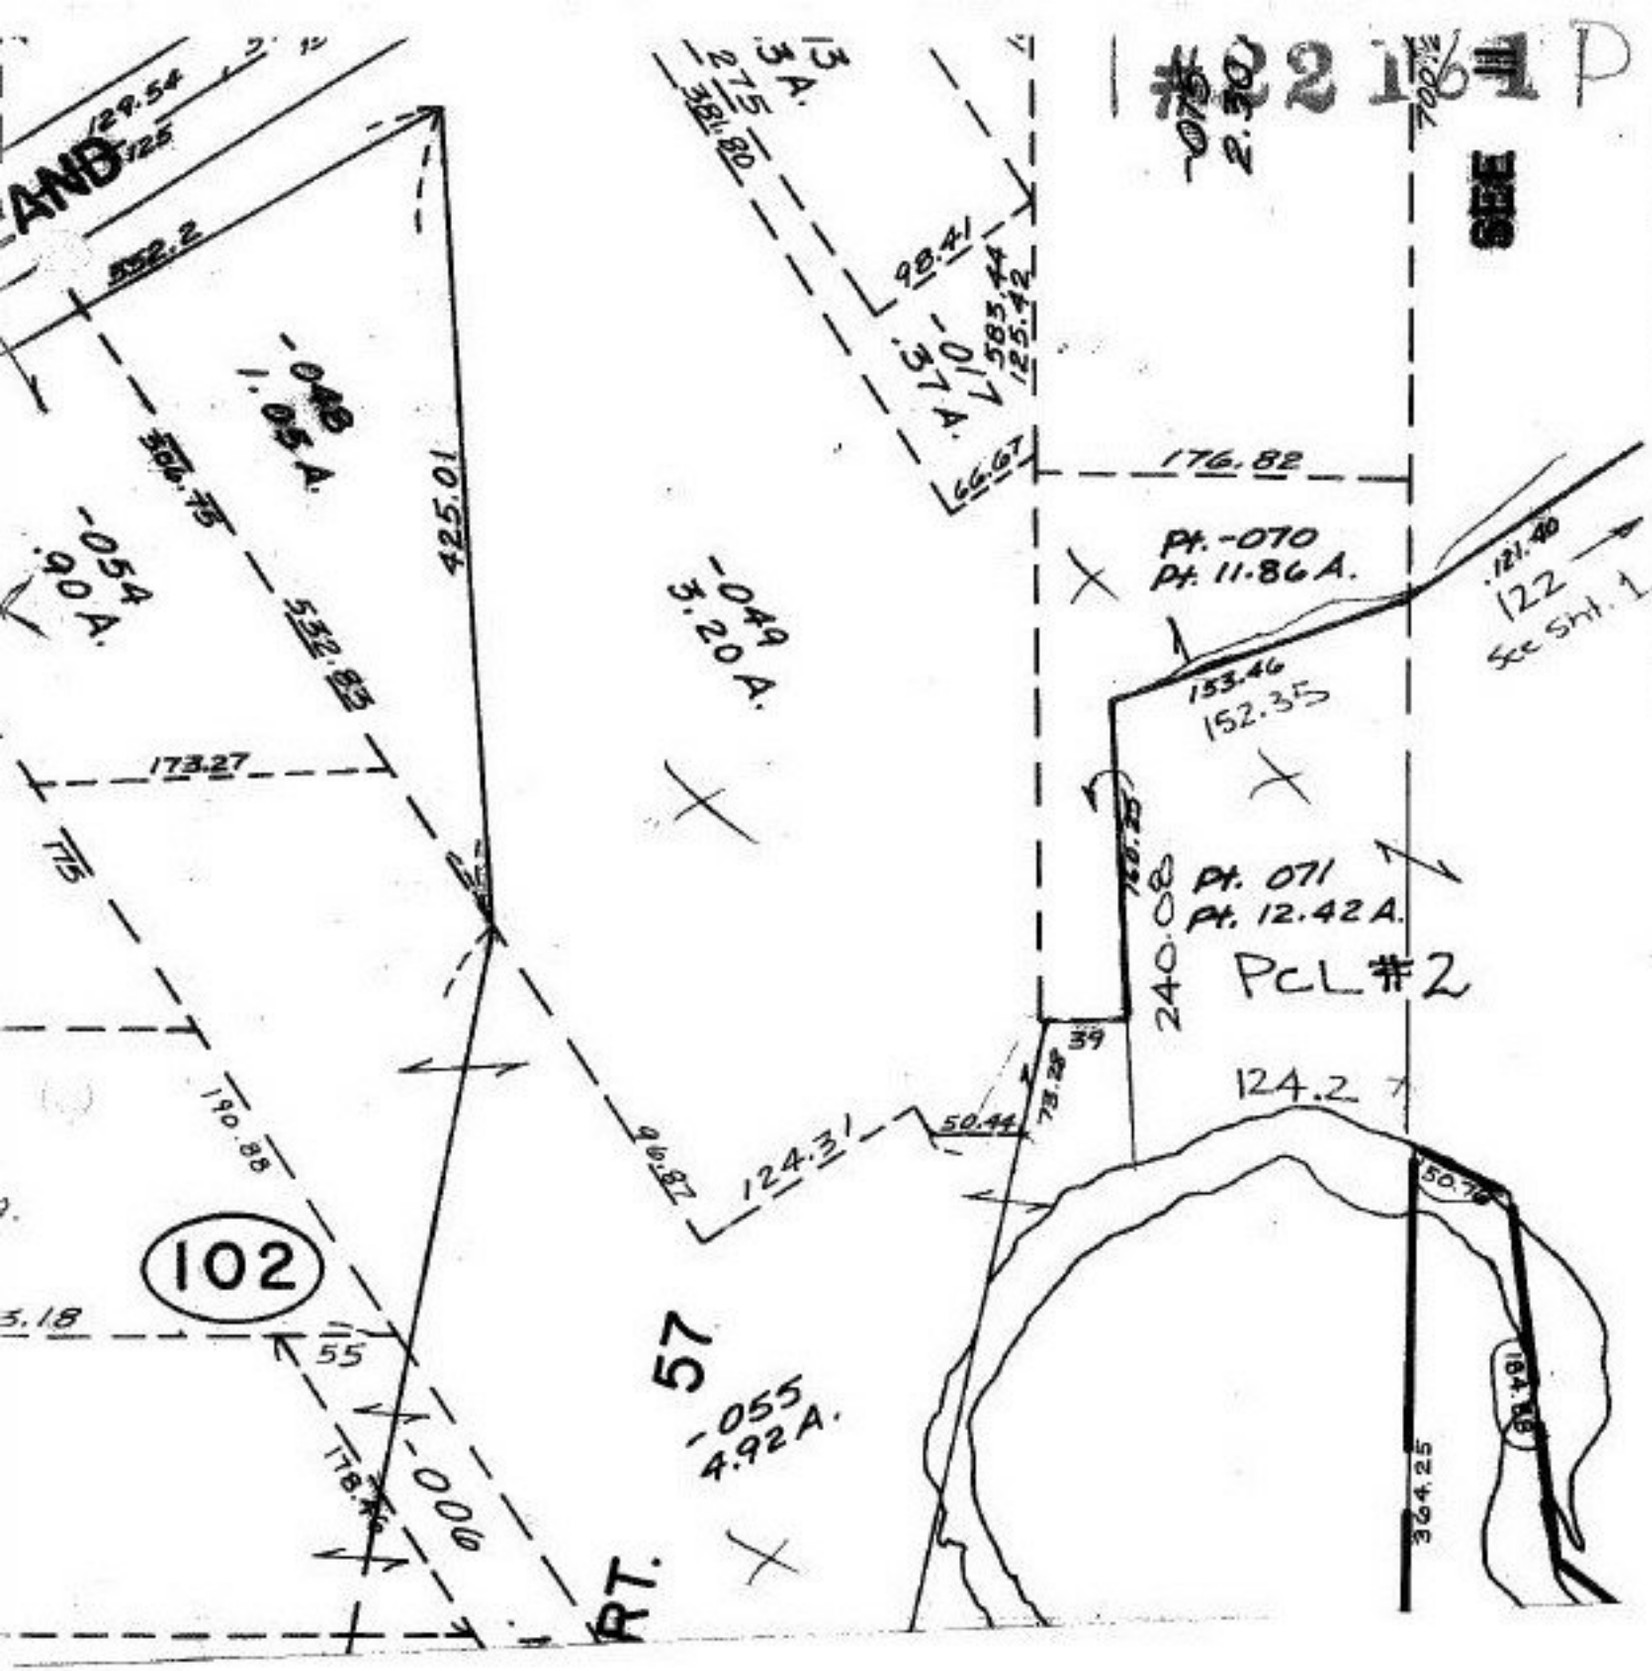

Map Correction
Only

#22161-D

APPROVED LORAIN CO. MAP DEPT.
DATE 4-22-97
PAGE 11-00-093A
BY R. BELL
VOID AFTER # 22161-D

2 of 2