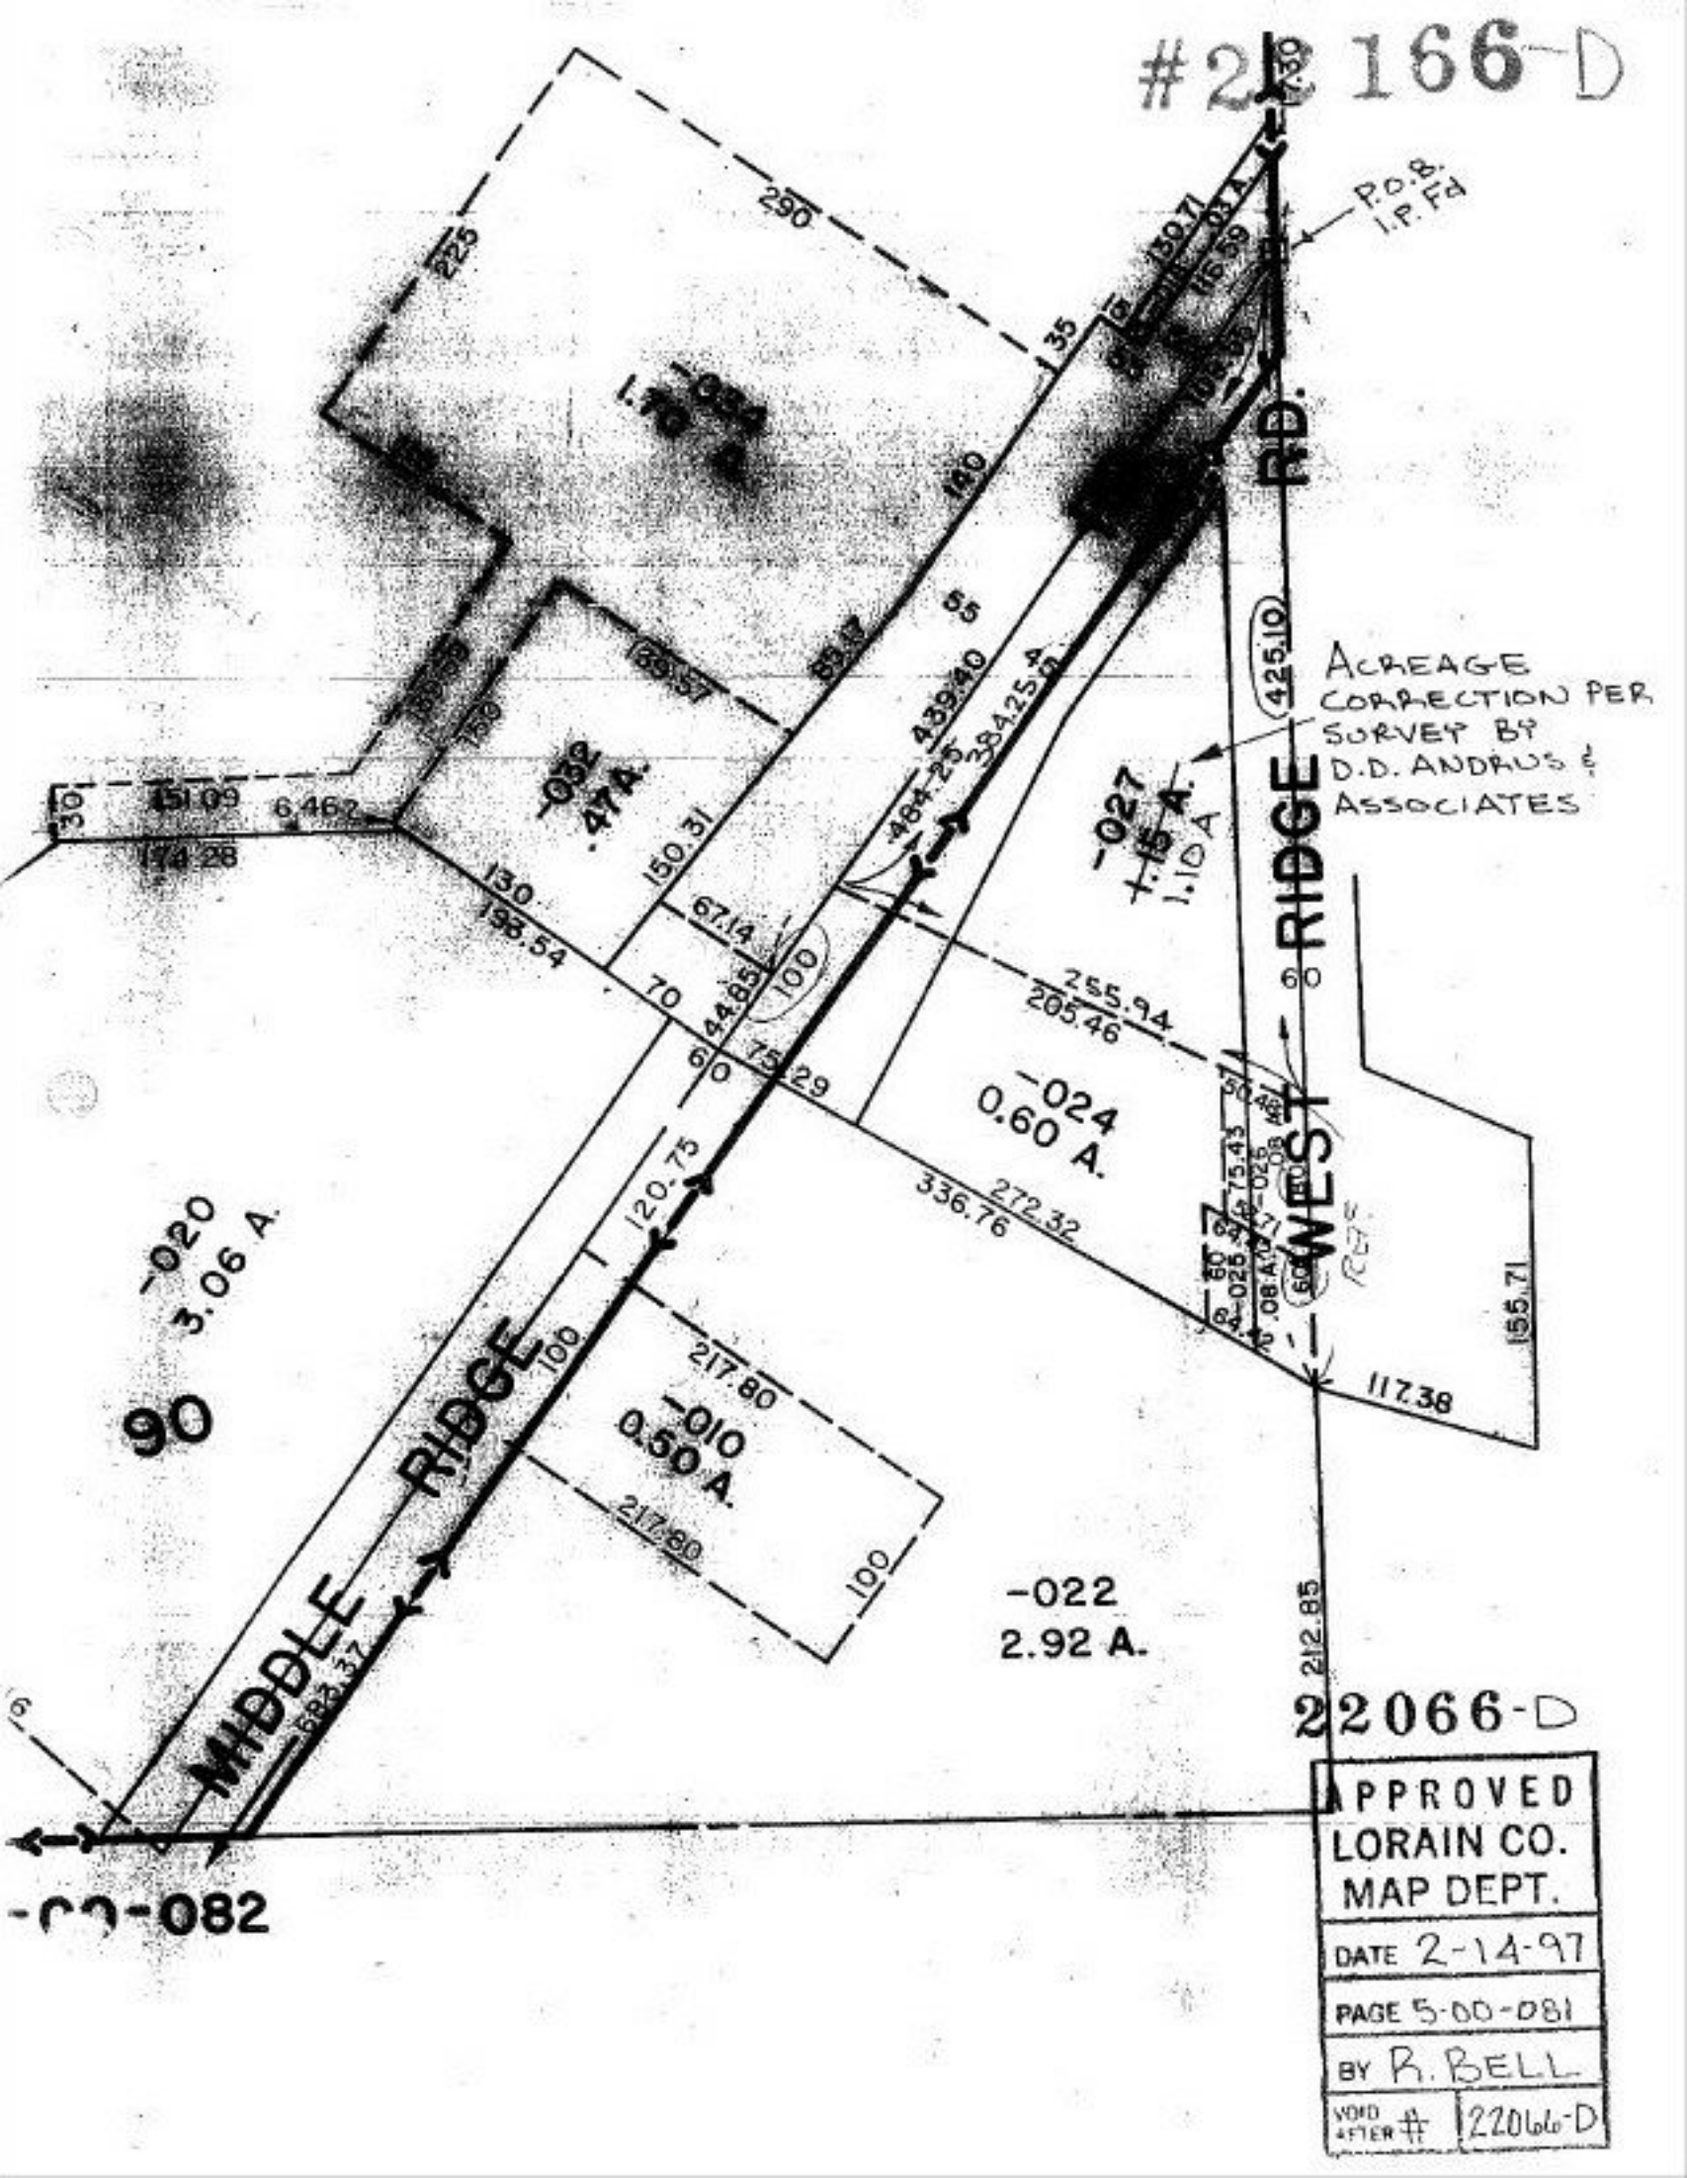
#22166-D
P.O.B. I.P. Fd
ACREAGE CORRECTION PER SURVEY BY D.D. ANDRUS & ASSOCIATES
WEST RIDGE RD.
MIDDLE RIDGE
-034 1.70 A.
-032 .47 A.
-027 1.15 A. 1.10 A
-024 0.60 A.
-020 3.06 A.
-010 0.50 A.
-022 2.92 A.
90
-00-082
22066-D
APPROVED
LORAIN CO.
MAP DEPT.
DATE 2-14-97
PAGE 5-00-081
BY R. BELL
VOID AFTER # 22066-D