#22 168

PARENT PARCEL: 02-01-003-247-006, 007 & 008
CHILD PARCEL: 02-01-003-247-035 thru 038 & 006
STARTING POINT: n. line of W. 38th St. & e. line of Dayton Ave.

NO. 22168

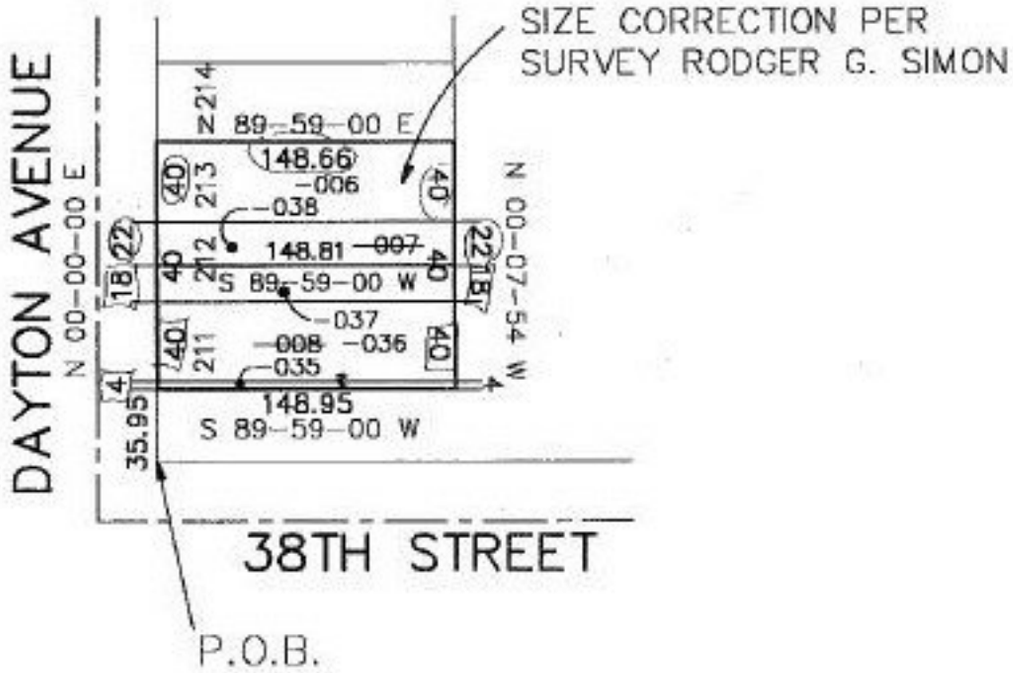

SPLITS/DEEDS PROCESSED
LORAIN COUNTY TAX MAP DEPARTMENT
226 MIDDLE AVE. ELYRIA, OHIO

SURVEYED BY: Rodger G. Simon
CLOSURE: 0.18 per 10,000
MAP PAGE(S): 02-01-003J
APPROVED BY: KAC/RFB DATE: 5/13/97
SCALE: 1" = 100